

D. REPORTS OF COMMITTEE

D.1 Committee of the Whole

D.1.a Report from the November 02, 2023 COTW Meeting

**D.1.a.a965 Cowichan Street: Development Permit with Variances
Application No. 00253 (Gonzales)**

Moved By Councillor Caradonna

Seconded By Councillor Dell

1. That Council waive the standard practice of holding an Opportunity for Public Comment for this application but direct staff to continue other standard practices related to sign posting and public notification, including a request for written commentary to come back to Council for consideration prior to issuing the Development Permit with Variances.
2. That Council considers authorizing the issuance of Development Permit with Variances Application No. 00253 for 965 Cowichan Street, in accordance with plans submitted and date stamped September 25, 2023, subject to:
 - a. Receipt of a revised arborist report and tree management plan to the satisfaction of the Director of Parks, Recreation and Facilities
 - b. Proposed development meeting all City zoning bylaw requirements, except for the following variances:
 - i. increasing the site coverage requirement from 30% to 43%
 - ii. increasing the rear yard site coverage requirement from 25% to 37%.
3. The Development Permit with Variances lapsing two years from the date of this resolution.

FOR (6): Mayor Alto, Councillor Caradonna, Councillor Dell, Councillor Hammond, Councillor Loughton, and Councillor Thompson

OPPOSED (2): Councillor Coleman, and Councillor Gardiner

CARRIED (6 to 2)

G.1 965 Cowichan Street: Development Permit with Variances Application No. 00253 (Gonzales)

Committee received a report dated October 19, 2023 from the Director of Sustainable Planning and Community Development regarding a Development Permit With Variances Application located at 965 Cowichan Street in order to allow construction of a garden suite in the rear yard of a lot with an existing single-family dwelling, and recommending that Council waive the standard practice of holding an Opportunity for Public Comment.

Moved By Councillor Dell
Seconded By Councillor Caradonna

Option 1 - Accept proposal as submitted

1. That Council waive the standard practice of holding an Opportunity for Public Comment for this application but direct staff to continue other standard practices related to sign posting and public notification, including a request for written commentary to come back to Council for consideration prior to issuing the Development Permit with Variances.
2. That Council considers authorizing the issuance of Development Permit with Variances Application No. 00253 for 965 Cowichan Street, in accordance with plans submitted and date stamped September 25, 2023, subject to:
 - a. Receipt of a revised arborist report and tree management plan to the satisfaction of the Director of Parks, Recreation and Facilities
 - b. Proposed development meeting all City zoning bylaw requirements, except for the following variances:
 - i. increasing the site coverage requirement from 30% to 43%
 - ii. increasing the rear yard site coverage requirement from 25% to 37%.
3. The Development Permit with Variances lapsing two years from the date of this resolution.

FOR (8): Mayor Alto, Councillor Caradonna, Councillor Coleman, Councillor Dell, Councillor Hammond, Councillor Kim, Councillor Loughton, and Councillor Thompson

OPPOSED (1): Councillor Gardiner

CARRIED (8 to 1)



Committee of the Whole Report For the Meeting of November 2, 2023

To: Committee of the Whole **Date:** October 19, 2023

From: Karen Hoese, Director, Sustainable Planning and Community Development

Subject: **Development Permit with Variances Application No. 00253 for 965 Cowichan Street**

RECOMMENDATION

1. That Council direct the applicant to revise the site plan to bring the design into compliance with the Garden Suite Policy and Guidelines by directly orienting the proposed garden suite onto Redfern Street, to the satisfaction of the Director of Sustainable Planning and Community Development,
2. That Council waive the standard practice of holding an Opportunity for Public Comment for this application but direct staff to continue other standard practices related to sign posting and public notification, including a request for written commentary to come back to Council for consideration prior to issuing the Development Permit with Variances
3. That Council considers authorizing the issuance of Development Permit with Variances Application No. 00253 for 965 Cowichan Street, in accordance with plans submitted to the satisfaction of the Director of Sustainable Planning and Community Development, subject to:
 - a. Receipt of a revised arborist report and tree management plan to the satisfaction of the Director of Parks, Recreation and Facilities
 - b. Proposed development meeting all City zoning bylaw requirements, except for the following variances:
 - i. increasing the site coverage requirement from 30% to 43%
 - ii. increasing the rear yard site coverage requirement from 25% to 37%.
4. That the Development Permit with Variances, if issued, lapses two years from the date of this resolution”.

LEGISLATIVE AUTHORITY

In accordance with Section 489 of the *Local Government Act*, Council may issue a Development Permit in accordance with the applicable guidelines specified in the *Official Community Plan*. A Development Permit may vary or supplement the *Zoning Regulation Bylaw* but may not vary the use or density of the land from that specified in the Bylaw.

Pursuant to Section 491 of the *Local Government Act*, where the purpose of the designation is the establishment of objectives for the form and character of intensive residential development, a Development Permit may include requirements respecting the character of the development including landscaping, and the siting, form, exterior design and finish of buildings and other structures.

EXECUTIVE SUMMARY

The purpose of this report is to present Council with information, analysis and recommendations for a Development Permit with Variances Application for the property located at 965 Cowichan Street. The proposal is to allow construction of a garden suite in the rear yard of a lot with an existing single-family dwelling. The garden suite is generally consistent with the applicable *Garden Suite Policy and Guidelines*; however, the lot fronts on Cowichan Street and Redfern Street and the proposed siting of the garden suite is not consistent with the Guideline regarding double-fronting lots, which recommends the garden suit entrance face the adjacent street (i.e., Redfern Street).

Staff have worked with the applicant to try to bring the design into compliance with the guidelines; however, the applicant wishes to retain the siting of the garden suite because it's intended for a family member so is oriented toward the primary residence rather than oriented onto Redfern Street and to retain space in the rear yard between the garden suit and Redfern Street for vehicle parking. A fence is also proposed along Redfern Street that would further limit the connection between the garden suite and the street.

The following points were considered in assessing this application:

- The proposal is generally consistent with the policies and design specifications outlined in the *Garden Suite Policy and Guidelines*; however, the proposed location of the garden suite is not directly oriented to Redfern Street which is inconsistent with the intent of the Guidelines which encourages garden suites on double-fronting lots to be directly oriented to the adjacent public right of way with entrances and windows facing the street.
- The applicant has included a pathway from Redfern Street to the garden suite entrance which is encouraged in the guidelines but does not address the issue of building orientation to address the street. The application also requires variances to the site coverage and to the rear lot site coverage requirements, both are supportable as they would appear to have minimal impact on surrounding properties.

BACKGROUND

Description of Proposal

The proposal is for a garden suite in the rear yard of the subject property which is considered a plus site as the lot has two street frontages and the lot area is greater than 557m². Details include:

- The garden suite would be located in the rear yard.
- The proposed building would have a floor area of 55.65m² which is just under the 56m² maximum floor area permitted for a "plus" size lot.
- The garden suite is one storey with a metal roof. The private outdoor space associated with the proposed garden suite faces south and will be separated by landscaping.

Land Use Context

The immediate area is characterized by single-family dwellings and several lots on surrounding properties have garden suites.



965 Cowichan Street
Delegated Development Permit No.00784



Existing Site Development and Development Potential

The site has an existing single-family dwelling. Under the current R1-G Zone, Single Family Dwelling District, the property could be developed with a single-family dwelling with a secondary suite or garden suite.

Data Table

The following data table compares the proposal with the R1-G Zone and Schedule M – Garden Suites regulations. Variances from the *Zoning Regulation Bylaw* are indicated with an *.

Zoning Criteria	Proposal	Zone standard
Site area (m ²) – minimum	590.9	557.00 (plus site)
Lot width (m) - minimum	15.61	15
Site coverage (%) maximum	43 *	30
Open site space (%) minimum	51.5	50
Floor area (m ²) – maximum	55.65	56.00
Height (m) – maximum	3.71	4.20
Storeys	1	1.50
Rear yard site coverage (%) – maximum	37 *	25.00
Separation space from single-family dwelling (m) – minimum (east)	2.93	2.40
Setbacks (m) – minimum		
Rear (East)	0.79	0.60
Side (North)	0.97	0.60

Active Transportation

The applicant has not identified any active transportation impacts associated with this application.

Public Realm

No public realm improvements beyond City standard requirements are proposed in association with this application.

Community Consultation

Consistent with the *Community Association Land Use Committee (CALUC) Procedures for Processing Rezoning and Variance Applications*, since this is a Development Permit with

Variations Application, it was referred to the Fairfield Gonzales CALUC for a 30-day comment period. At the time of writing this report, a letter from the CALUC had not been received.

Pursuant to section 31 of the City's *Land Use Procedures Bylaw*, Council may provide an opportunity for public comment before considering a development permit with variations application. If Council chooses not to provide an opportunity for public comment, notice of the application must still be sent to all owners and occupiers of the subject property and adjacent properties. In addition, the recommendation is to continue to post notification signage on the subject property. The notice would invite recipients to provide written comments prior to Council's consideration of the application. Should Council wish to hold an opportunity for public comment, an alternate motion has been provided at the end of this report.

ANALYSIS

Development Permit Area and Design Guidelines

The *Official Community Plan* identifies this property within Development Permit Area 15E: Intensive Residential - Garden Suites. The subject lot has frontage onto Cowichan Street to the west and Redfern Street to the east. The design guidelines for garden suites state that:

In the case of double-fronting lots, Garden Suites should be directly oriented to the adjacent public right-of-way. This means including front doors that are directly oriented to the street or laneway windows directed towards the street or laneway and landscape that reinforces the location of the entry.

The proposed garden suite is not directly oriented to Redfern Street. There is a carport proposed in between the garden suite and Redfern Street and a fence along the lot line; therefore, there is no orientation or connection to Redfern Street. The applicant has revised the site plan to include a gate and path connecting Redfern Street. The revision in the view of the applicant meets the intent of the guidelines to have some orientation to Redfern Street.

It should be noted that there are several garden suites on similar double fronting lots between Cowichan Street and Redfern Street adjacent to and near the subject lot and several of these garden suites are directly oriented onto Redfern Street.

In summary, in order to bring the proposed garden suite into compliance with the design guidelines it is recommended that the applicant revise the site plans to directly orient the garden suite to Redfern Street. Should Council wish to proceed with approving the application as proposed by the applicant, an alternate motion is provided.

Variations

The application, regardless of how the garden suite is sited, requires the consideration of two variations:

1. increase of the maximum site coverage of the lot from 30% to 43%
2. increase of the maximum rear yard site coverage from 25% to 37%.

The subject lot is considered a plus size lot due to its lot size of 590.9m² and because it's a double fronting lot; this permits a larger garden suite to be constructed on the lot. However, the subject lot doesn't greatly exceed the plus size lot requirements, making it more challenging to construct a larger garden suite while still meeting the site coverage requirements. As the proposed variations would appear to not negatively impact the surrounding properties, these

variance requests are supported. It is worth noting that the adjacent lot to the south required a variance to the site coverage requirement to be permitted to build the existing garden suite.

Accessibility

No accessibility improvements are proposed beyond what is required through the *British Columbia Building Code*.

Sustainability

No sustainability features are proposed.

Tree Preservation Bylaw and Urban Forest Master Plan

The goals of the *Urban Forest Master Plan* include protecting, enhancing, and expanding Victoria's urban forest and optimizing community benefits from the urban forest in all neighbourhoods. This application was received after July 1, 2021, so Tree Protection Bylaw No. 21-035 applies.

A total of four trees have been inventoried. Of these, two are located on the subject lot, both of which are bylaw protected. There are two existing municipal trees, one on the Cowichan Street frontage and one on the Redfern Street frontage. Bylaw protected trees No.3 (70 cm diameter Garry Oak) and No.5 (45/21 cm diameter multiple-stemmed Walnut) as well as municipal tree No. 1 (28 cm diameter Mountain Ash) and municipal tree No. 2 (70 cm Horse chestnut) can be retained following the mitigation measures outlined in the arborist report.

There are no new trees proposed with this application.

Tree Impact Summary Table

Tree Status	Total # of Trees	To be REMOVED	To be PLANTED	NET CHANGE
On-site trees, bylaw protected	2	0	0	0
On-site trees, not bylaw protected	0	0	0	0
Municipal trees	2	0	0	0
Neighbouring trees, bylaw protected	0	0	0	0
Neighbouring trees, not bylaw protected	0	0	0	0
Total	4	0	0	0

The recommendation for Council's consideration includes a requirement for the applicant to revise the tree management plan and arborist report prior to issuance of the Development Permit with Variances.

CONCLUSION

The proposal for a garden suite is generally consistent with the OCP objectives and guidelines for sensitive infill; however, the design is inconsistent with the *Garden Suite Policy and Guidelines*, specifically in relation to siting of the garden suite and its orientation to Redfern

Street. It is recommended that the proposal be modified so the siting of the garden suite is directly oriented to Redfern Street. However, if Council wishes to accept the design as proposed, then the Alternate Motion Option 1, would be appropriate.

It is recommended that Council supports the variance requests to exceed the site coverage and rear yard site coverage requirements.

ALTERNATE MOTIONS

Option 1 - Accept proposal as submitted

1. That Council waive the standard practice of holding an Opportunity for Public Comment for this application but direct staff to continue other standard practices related to sign posting and public notification, including a request for written commentary to come back to Council for consideration prior to issuing the Development Permit with Variances.
2. That Council considers authorizing the issuance of Development Permit with Variances Application No. 00253 for 965 Cowichan Street, in accordance with plans submitted and date stamped September 25, 2023, subject to:
 - a. Receipt of a revised arborist report and tree management plan to the satisfaction of the Director of Parks, Recreation and Facilities
 - b. Proposed development meeting all City zoning bylaw requirements, except for the following variances:
 - i. increasing the site coverage requirement from 30% to 43%
 - ii. increasing the rear yard site coverage requirement from 25% to 37%.
3. The Development Permit with Variances lapsing two years from the date of this resolution.

Option 2 – Decline

That Council decline Development Permit with Variances Application No. 00253 for the property located at 965 Cowichan Street.

Respectfully submitted,

Gerry Hamblin
Senior Planner
Development Services Division

Karen Hoese, Director
Sustainable Planning and Community
Development Department

Report accepted and recommended by the City Manager.

List of Attachments


- Attachment A: Plans date stamped September 25, 2023
- Attachment B: Letter to Mayor and Council dated September 25, 2023

READ RESIDENCE - GARDEN SUITE

965 COWICHAN STREET, VICTORIA, B.C.



Drawing Notes
 All drawings, plans, models, designs, specifications and other documents prepared by Lane Design and used in connection with this project are instruments of service for the work shown in them (the "Work") and as such are and remain the property of Lane Design whether the Work is executed or not, and Lane Design reserves the copyright in them and in the Work executed from them, and they shall not be used for any other work or project.
 The general contractor is responsible for confirming and correlating dimensions at the job site. The designer will not be responsible for construction means, methods, techniques, sequences or procedures, or safety precautions and programs in connection with the project.

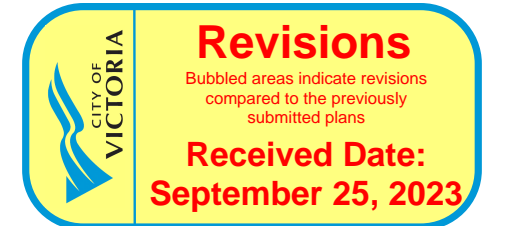

3	Issued for Variance Application	2023/09/05	LL
2	Re-issued for Delegated Development Permit	2023/06/29	LL
1	Delegated Development Permit	2022/10/3	LL
No.	Revision	Date	By

GENERAL NOTES

ROOFING

ALL ROOFING SHALL BE APPLIED TO THE MANUFACTURERS SPECIFICATIONS AND SHALL INCLUDE EAVE PROTECTION FROM ICE DAMMING AND SNOW BUILD UP

PLUMBING AND ELECTRICAL

PLUMBING AND ELECTRICAL NOT SHOWN ON THESE PLANS AND MUST BE DESIGNED AND INSTALLED BY A QUALIFIED PROFESSIONAL

FLASHING

ALL PENETRATIONS THROUGH THE ROOF WILL REQUIRE FLASHING.

ALL EXPOSED OPENINGS TO INCLUDE FLASHING

ALL FLASHING END DAMS TO BE 25MM (1") HIGH

DOORS

FRAME OPENING TO BE 1 1/4" WIDER THAN DOOR
 FRAME OPENING 1 1/4" WIDER THAN BIFOLD DOORS AND FRAME HEIGHT IS 81.5"
 ALL INTERIOR DOORS TO BE 80" TALL U.N.O. PROVIDE MIN. 2-STUDS AT EACH SIDE OF JAMB FRAMING

FENESTRATION

ALL WINDOWS, DOORS TO CONFORM TO NAFS-08 AND THE CANADIAN SUPPLEMENT TO NAFS

FENESTRATION PERFORMANCE REQUIREMENTS:
 CLASS R - PG 30 - 4"YE/-4"VE DP = 1440PA/1440PA - WATER PENETRATION RESISTANCE = 260PA - CANADIAN AIR INFILTRATION/EXFILTRATION = A2

WINDOW/DOOR LABELS TO BE LEFT IN PLACE UNTIL FINAL INSPECTION

SUPPLY AND INSTALL ALL WINDOW TYPES, INTERIOR CASINGS AND MILLWORK TO OWNERS APPROVAL

ALL WINDOWS ADJACENT TO BATH TUBS TO BE SAFETY GLASS

VENTILATION

PROVIDE HEATING, MECHANICAL VENTILATION, AND AIR CONDITIONING WHERE REQUIRED IN ACCORDANCE WITH BCBC AND LOCAL BYLAWS

MECHANICAL CONTRACTOR TO PROVIDE MECHANICAL CHECKLIST COMPLETE WITH FAN & DUCT SIZES PRIOR TO FRAMING INSPECTION

MISC.

SMOKE/CARBON MONOXIDE ALARMS TO BE PROVIDED AND ARE TO BE HARDWIRED AND WITHIN 5M OF EACH BEDROOM. SMOKE ALARMS TO ALSO BE PROVIDED IN EVERY BEDROOM. ALL SMOKE ALARM LOCATIONS WILL HAVE BOTH PHOTOELECTRIC AND IONIC DETECTION SYSTEMS

BEDROOM WINDOWS FOR EGRESS SHALL HAVE OPENINGS WITH AREAS NOT LESS THAN 3.8FT2 WITH NO DIMENSION LESS THAN 15"

IT IS THE RESPONSIBILITY OF THE CONTRACTOR AND/OR OWNER TO CHECK AND VERIFY ALL ASPECTS OF THESE PLANS PRIOR TO START OF CONSTRUCTION OR DEMOLITION.

GENERAL NOTES

ALL MATERIALS AND CONSTRUCTION METHODS TO CONFORM TO THE CURRENT EDITION OF THE BRITISH COLUMBIA BUILDING CODE (BCBC), GOOD CONSTRUCTION PRACTICE, AS WELL AS ANY OTHER LOCAL BUILDING CODES OR BYLAWS WHICH MAY TAKE PRECEDENCE

ALL MEASUREMENTS TO BE VERIFIED ON SITE BY BUILDER PRIOR TO CONSTRUCTION. COMMENCEMENT OF CONSTRUCTION OR ANY PART THEREOF CONSTITUTES ACCEPTANCE OF THE DRAWINGS/SITE CONDITIONS AND MEANS DIMENSIONS & ELEVATIONS HAVE BEEN VERIFIED & ARE ACCEPTABLE

IF ANY DISCREPANCIES ARISE, THEY SHOULD BE REPORTED TO THE DESIGNER. DIMENSIONS SHALL TAKE PRECEDENCE OVER SCALE

FRAMING LUMBER SHALL BE GRADED #2 OR BETTER UNLESS OTHERWISE SPECIFIED. ALL INTERIOR FINISHES, CASINGS, WINDOW TYPES AND MILLWORK TO OWNERS APPROVAL

TEMPORARY HEAT REQUIRED PRIOR TO DRYWALL INSTALLATION TO ASSIST IN DRYING OF FRAMEWORK. MOISTURE CONTENT OF FRAMEWORK MUST NOT EXCEED 19%

FOUNDATION

THE BUILDER IS RESPONSIBLE FOR LOCATING THE FOOT PRINT OF THE STRUCTURE IN THE PROPER PLACE AS PER PLANS

CONCRETE FOUNDATION WALLS NOT SUBJECT TO SURCHARGE SHALL BE INSTALLED ON COMPACTED, UNDISTURBED, INORGANIC STABLE SOILS BELOW THE DEPTH OF FROST PENETRATION WITH AN ALLOWABLE BEARING PRESSURE OF 75 KPA OR GREATER. IF SOFTER CONDITIONS APPLY, THE BEARING CAPACITY AND SIZE OF FOOTINGS ARE TO BE DESIGNED BY A QUALIFIED ENGINEER

THE SILL PLATE IS TO BE FASTENED TO THE FOUNDATION WALL, REFER TO STRUCTURAL. ALL LUMBER IN CONTACT WITH CONCRETE SHALL BE TREATED OR PROTECTED BY A MOISTURE RESISTANT GASKET. IT IS THE RESPONSIBILITY OF THE OWNER/CONTRACTOR TO HAVE SITE SOIL CONDITIONS INSPECTED AND ADVISE THE DESIGNER OF ANY SOIL CONDITIONS WHICH MAY REQUIRE ENGINEERING

ALL FOUNDATION WALLS ARE 200mm THICK 20MPA CONCRETE UNLESS OTHERWISE SPECIFIED

FOUNDATION WALLS MAY BE A MAXIMUM OF 4' HIGH FROM GRADE TO UNDERSIDE OF FLOOR IF LATERALLY UNSUPPORTED AT TOP. ALL OTHER CONCRETE FOUNDATION WALLS TO BE ENGINEERED

FRAMING

ALL ENGINEERED COMPONENTS TO BE SIZED BY SUPPLIER

ALL SPANS AND LOADINGS SHALL CONFORM TO THE CURRENT VERSION OF THE BCBC. VERIFICATION OF ALL COMPONENTS IS THE RESPONSIBILITY OF THE OWNER/BUILDER. ANY COMPONENTS WHICH CANNOT BE DESIGNED WITH THE BCBC SHALL BE DESIGNED BY A QUALIFIED ENGINEER

TRUSSES AND LAYOUT ARE TO BE ENGINEERED AND INSTALLED ACCORDING TO MANUFACTURERS SPECIFICATIONS. IT IS ASSUMED THAT THE CONTRACTOR IS FAMILIAR WITH THE 2018 BCBC AND INDUSTRY STANDARDS FOR WOOD FRAME CONSTRUCTION. NOT EVERY DETAIL OF WOOD FRAMING IS SHOWN ON THESE DRAWINGS

ALL LINTELS DOUBLE 2X10 S.S. SPF FOR CLEAR SPANS UP TO 5' UNLESS OTHERWISE NOTED

EXTERIOR WALL THICKNESS SHOWN ARE MEASURED FROM OUTSIDE OF EXTERIOR SHEATHING TO INSIDE OF DRYWALL

INTERIOR WALL THICKNESS SHOWN ARE MEASURED FROM OUTSIDE OF DRYWALL/PLYWOOD TO OUTSIDE DRYWALL/PLYWOOD.

ROOM MEASUREMENTS SHOWN ARE TO THE NEAREST INCH. DIMENSIONS SHOWN ARE TO THE NEAREST 1/4"

CONFIRM ALL VANITY'S, BATHTUBS, SHOWERS AND KITCHEN CUPBOARDS WITH OWNER PRIOR TO FRAMING AS THESE MAY REQUIRE MODIFICATIONS TO THE ROOM SIZES

DRAWING LIST

A0.0 COVER SHEET AND GENERAL NOTES

A1.1 SITE PLAN

A1.2 PHOTOS OF PROPERTY

A2.1 FLOOR PLANS

A3.1 ELEVATIONS

A4.1 BUILDING SECTIONS

A5.1 DETAILS

A5.2 DETAILS

A5.3 WINDOW DETAILS

A5.4 SLIDING DOOR DETAILS

A5.5 SWING DOOR DETAILS

S1.1 GENERAL NOTES

S1.2 GENERAL NOTES

S1.3 GENERAL NOTES, DETAILS AND PLANS

L1.1 LANDSCAPING PLAN

Project Name

READ RESIDENCE - GARDEN SUITE

965 COWICHAN STREET, VICTORIA BC

Sheet Title

COVER SHEET


Drawn By **LL** Scale **AS SHOWN**

Designed By **LL** Date **AUGUST 5, 2023**

Project Number **100**

Sheet Number Revision


A0.0

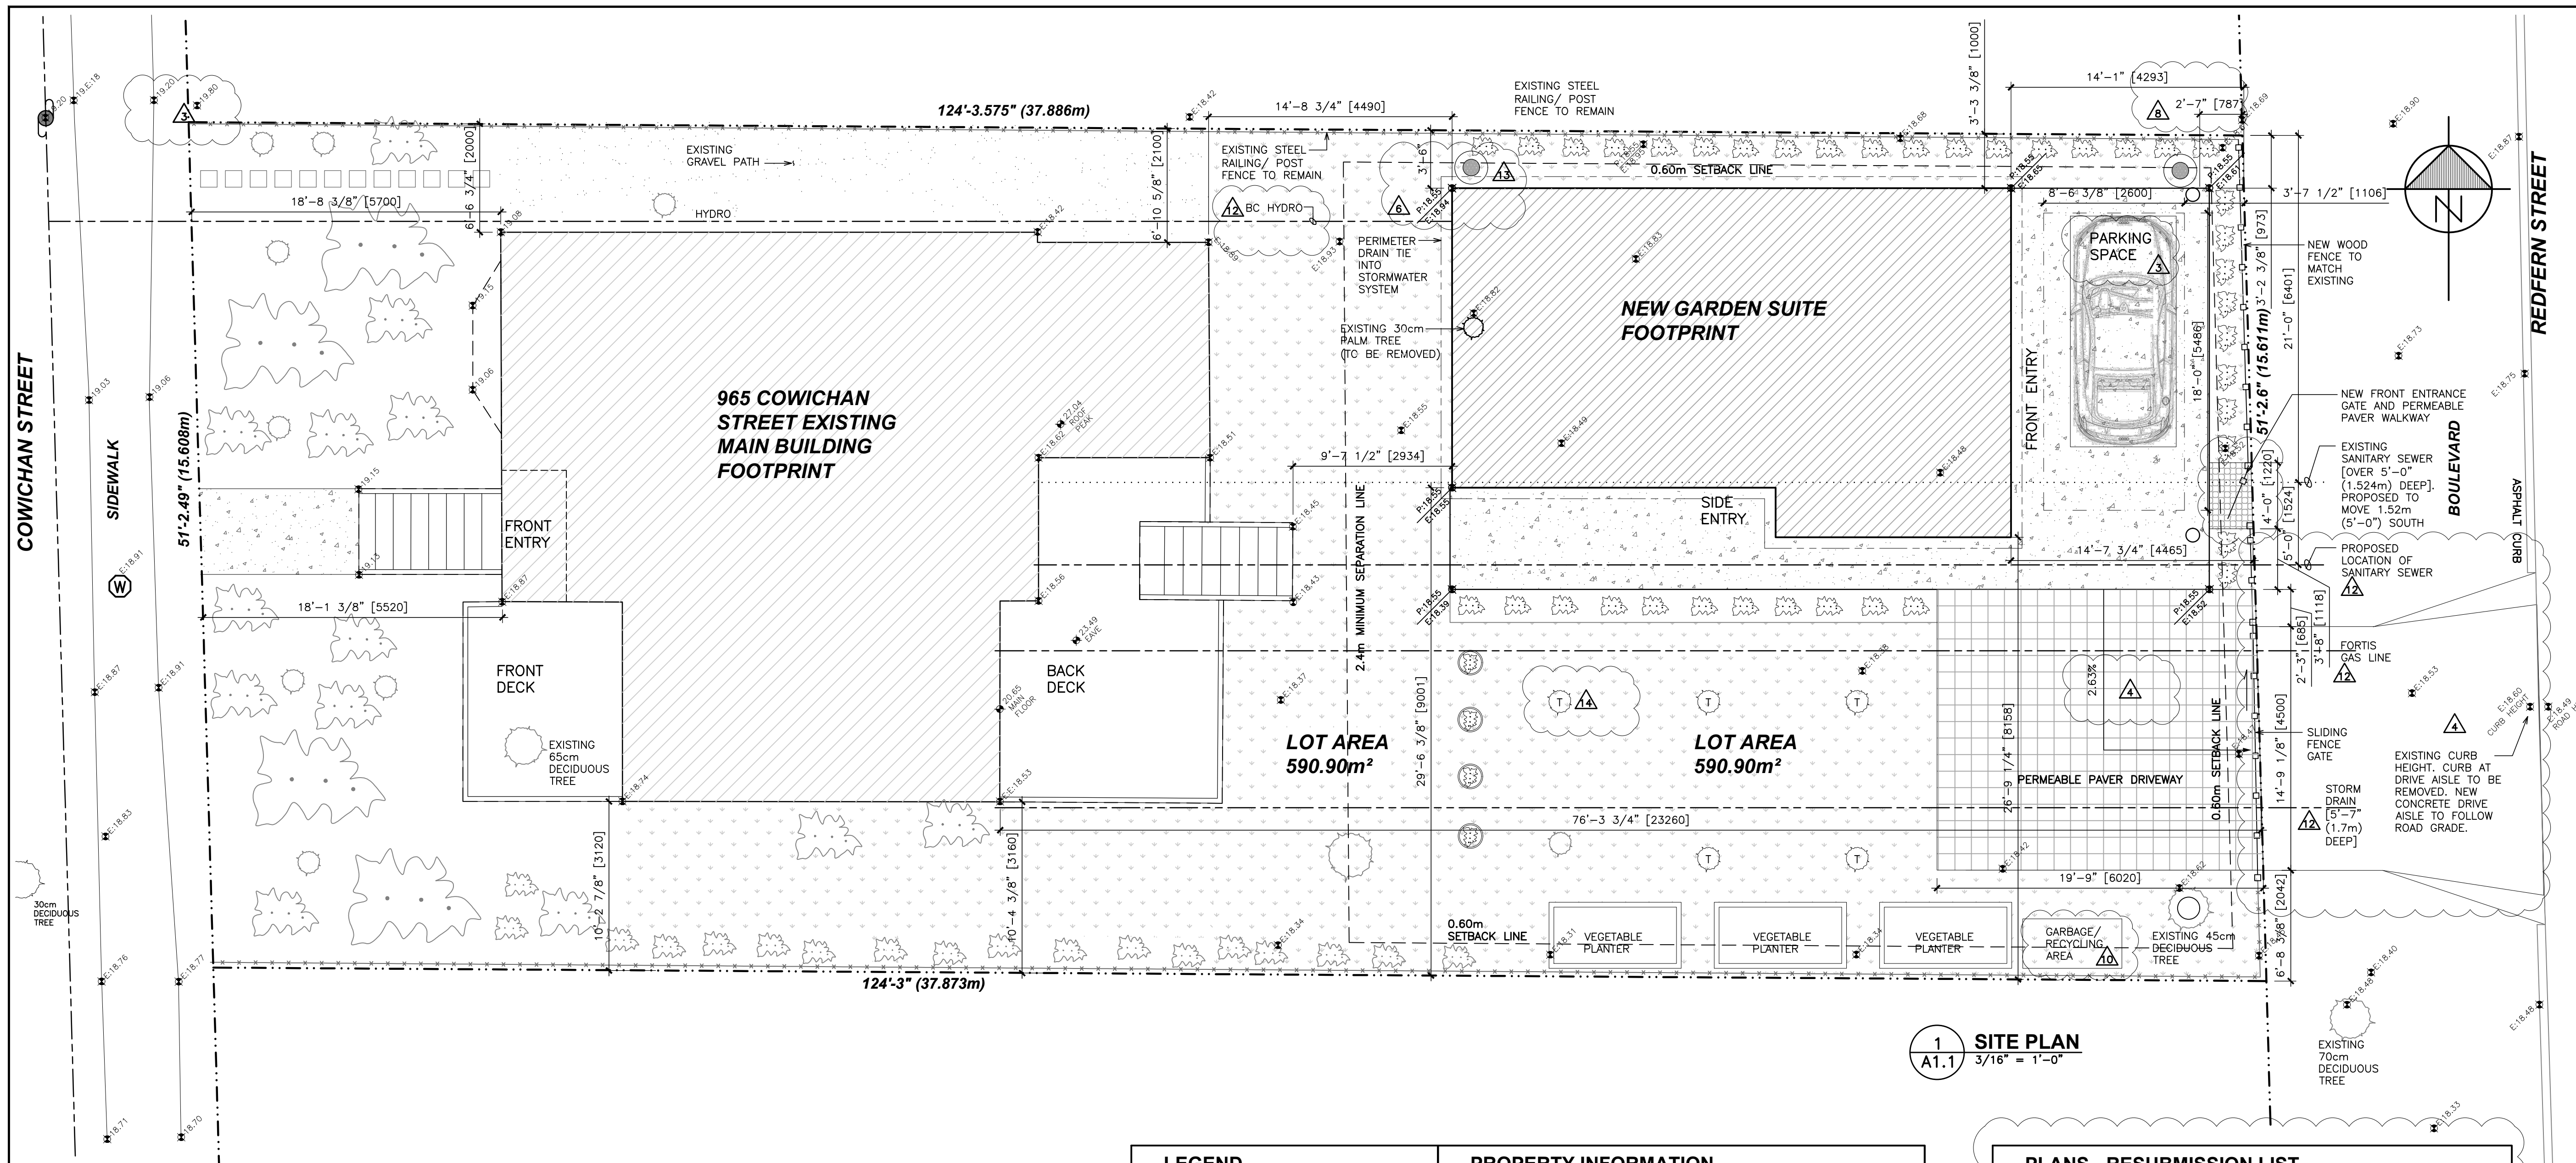

1 SITE PLAN
A1.1 3/16" = 1'-0"

Drawing Notes
All drawings, plans, models, designs, specifications and other documents prepared by Lane Design and used in connection with this project are instruments of service for the work shown in them (the "Work") and as such are and remain the property of Lane Design whether the Work is executed or not, and Lane Design reserves the copyright in them and in the Work executed from them, and they shall not be used for any other work or project.
The general contractor is responsible for confirming and correlating dimensions at the job site. The designer will not be responsible for construction means, methods, techniques, sequences or procedures, or safety precautions and programs in connection with the project.

No.	Revision	Date	By
3	Issued for Variance Application	2023/09/05	LL
2	Re-issued for Delegated Development Permit	2023/06/29	LL
1	Delegated Development Permit	2022/10/3	LL

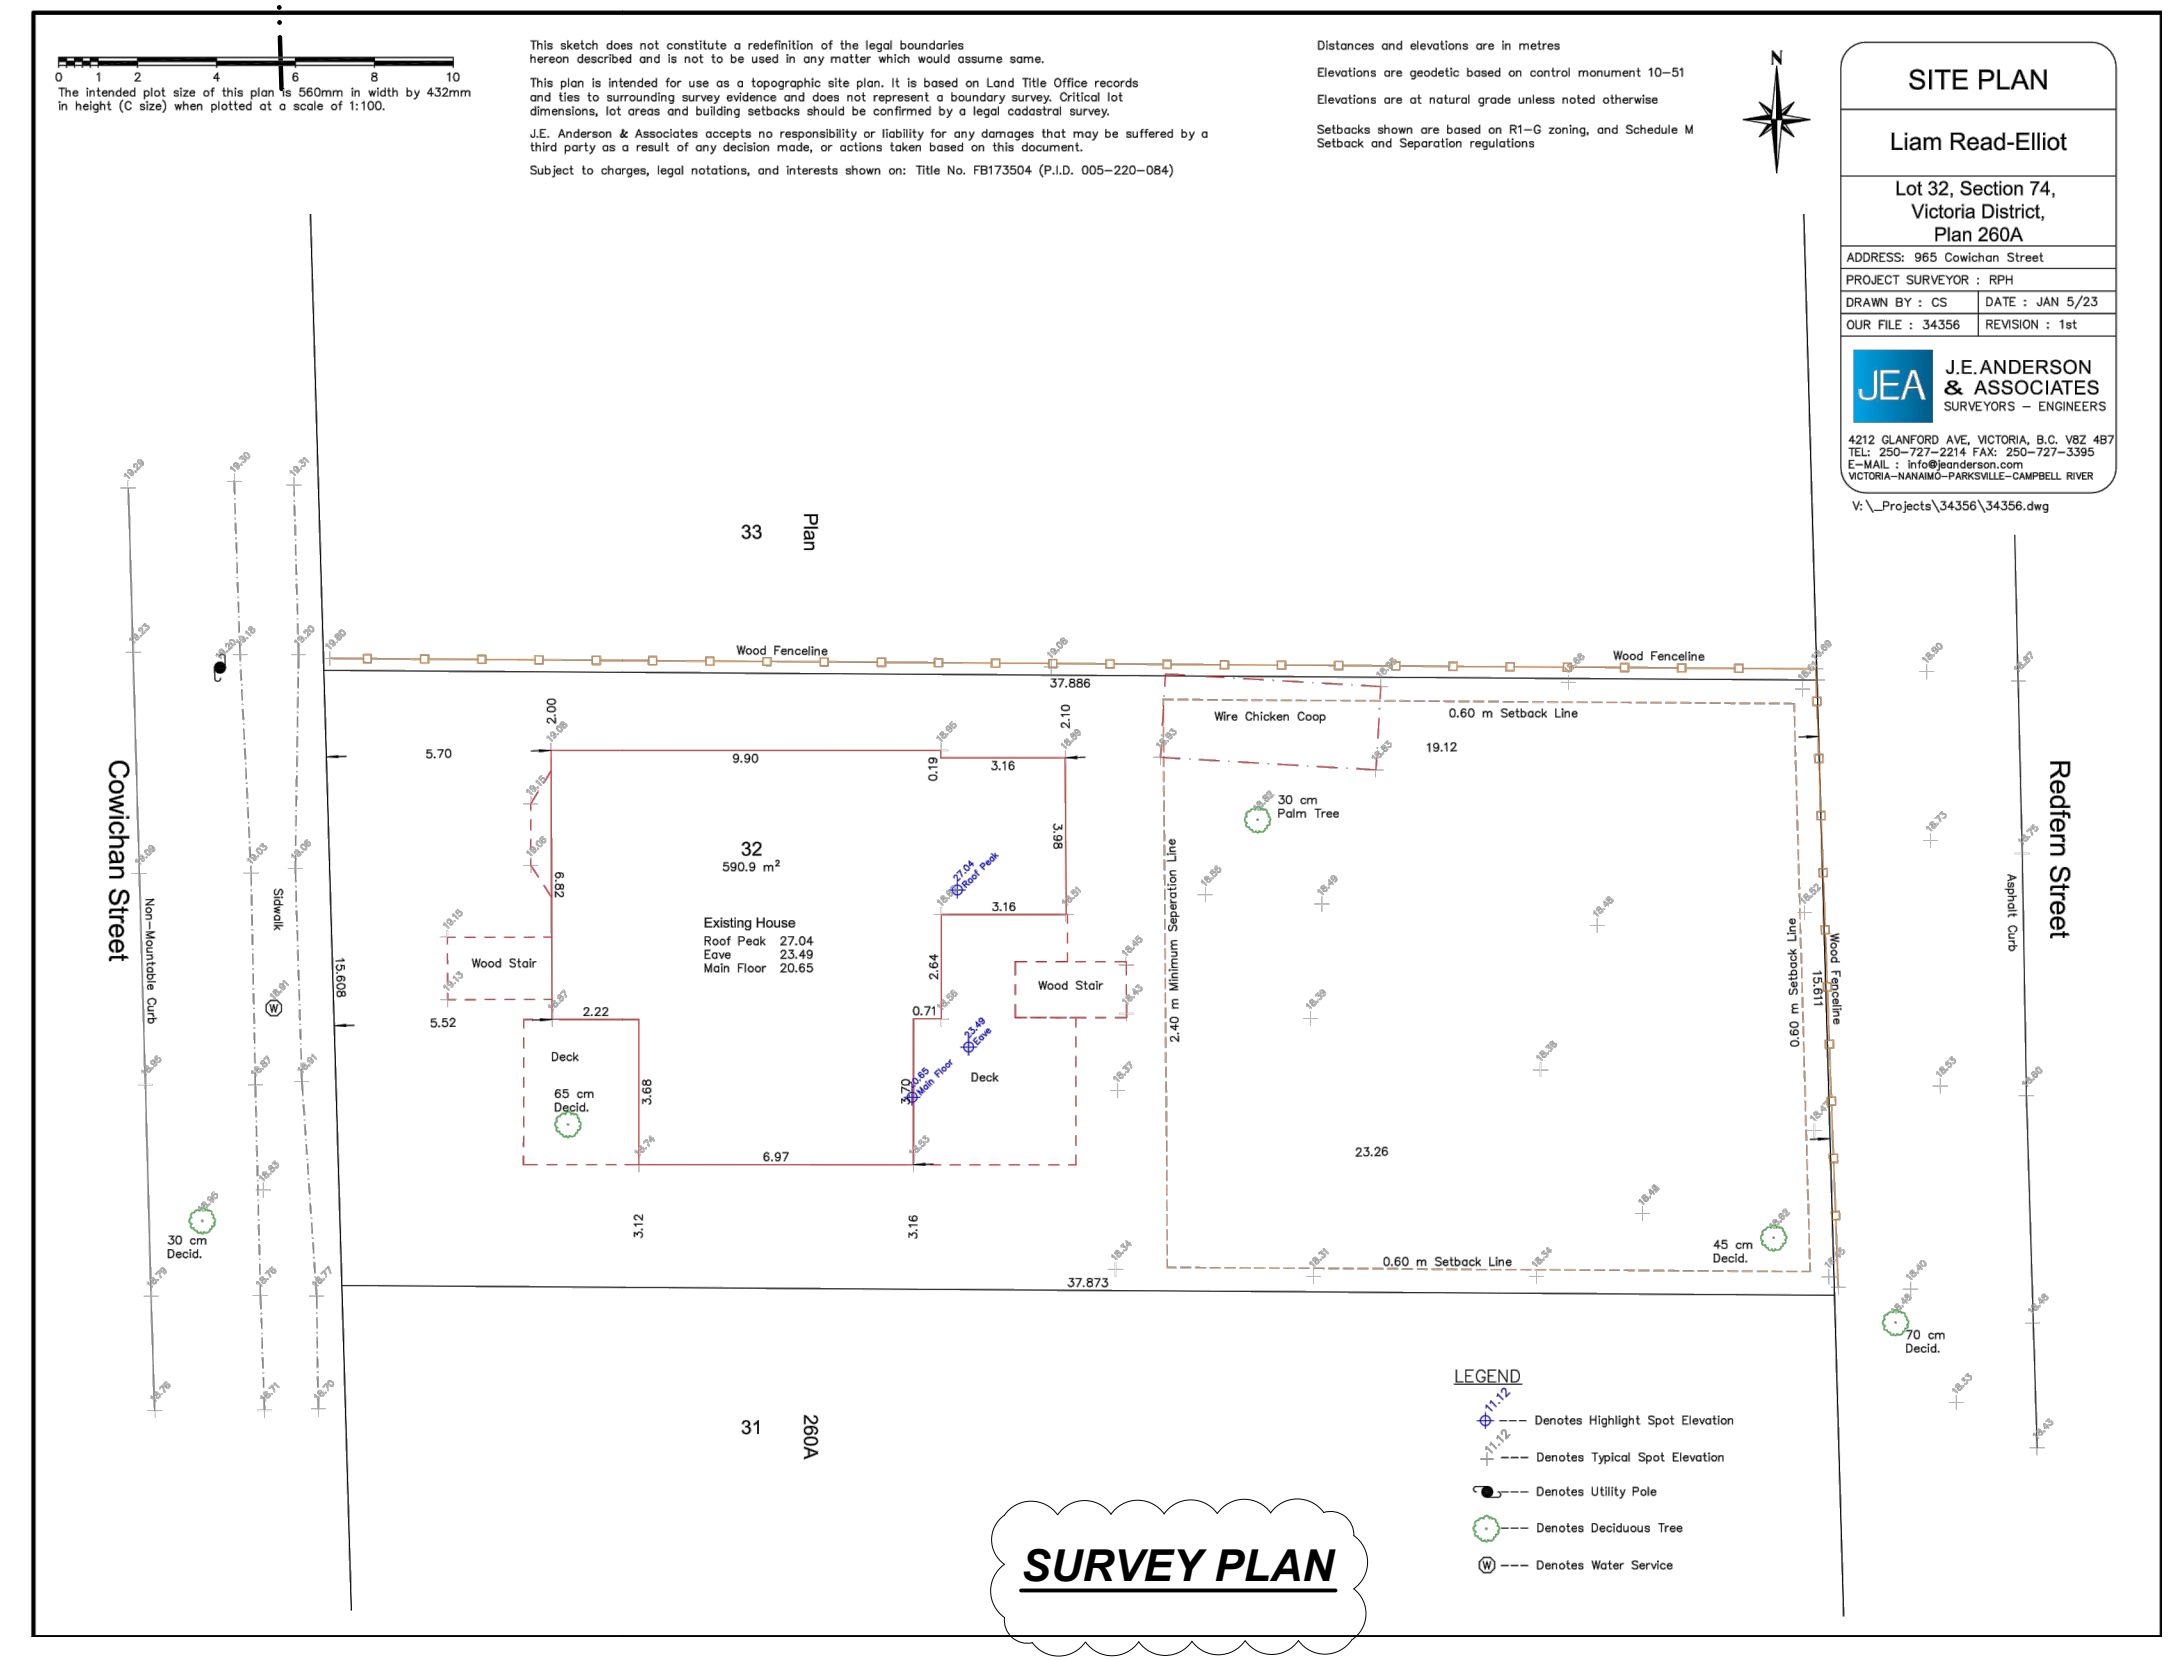

SURVEY PLAN

LEGEND

- PROPERTY LINE
- EXISTING TREE
- NEW TREE
- SHRUB / PLANT
- NEW SHRUB / NEW PLANT
- EXISTING FENCE
- NEW FENCE
- GRASS AREA
- PAVER AREA
- GRAVEL AREA
- CONCRETE PAVED AREA
- UTILITY POLE (EXISTING)
- WATER SERVICE (EXISTING)
- SPOT ELEVATION (EXISTING)

PROPERTY INFORMATION

PROPOSED SCOPE OF WORK: CONSTRUCT A NEW GARDEN SUITE
ADDRESS: 965 COWICHAN STREET, VICTORIA BC V8S 4E6
LEGAL DESCRIPTION: LOT 32, PLAN 260A SECTION 74 VICTORIA DISTRICT
ZONING: R1-G SINGLE FAMILY DWELLING

ZONING CRITERIA	PROPOSAL	ZONE STANDARD
SITE AREA (m ²)(MIN.)	590.90 m ²	460.00 m ²
LOT WIDTH (m)(MIN.)	15.61 m	15.00 m
SITE COVERAGE (%) (MAX.)	43% *	30%-40%
OPEN SITE SPACE (%) (MIN.)	51.5%	50%
OPEN SITE SPACE FRONT YARD (%) (MIN.)	EXISTING	50%
PARKING (MIN.)	1	1
PARKING LOCATION	REAR YARD	SCHEDULE C
DRIVEWAY/PARKING SLOPE (%) (MAX.)	2.63%	8.00%
DRIVEWAY/PARKING MATERIAL	PAVERS/CONCRETE	SCHEDULE C
GARDEN SUITE (PLUS SITE)		
PRIMARY BUILDING USE	SFD	SFD
SITE AREA FOR PLUS SITE (m ²)(MIN.)	590.90 m ²	557.00 m ²
LOCATION	REAR YARD	REAR YARD
COMBINED FLOOR AREA (m ²) (MAX.)	55.65 m ²	56.00 m ²
AVERAGE GRADE	18.55	N/A
HEIGHT (m) (MAX.)	3.71 m	4.20 m
STOREYS (MAX.)	1.0	1.5
REAR SETBACK (m) (MIN.)	0.79 m	0.60 m
SIDE SETBACK (m) (MIN.)	1.13 m	0.60 m
SEPARATION SPACE FROM MAIN BUILDING (m) (MIN.)	2.93 m	2.40 m
REAR YARD SITE COVERAGE (%) (MAX.)	37% *	25%

NOTE: * DENOTES VARIANCE REQUIRED

PLANS - RESUBMISSION LIST

TYPICAL NOTE:
PLAN REVISIONS TO PREVIOUS SUBMISSION. NUMBERING CORRELATED TO PLAN CHECK COMMENT'S NUMBERING.

REVISION NUMBER	COMMENTS (REVISIONS ON A1.1 SITE PLAN UNLESS NOTED OTHERWISE)
1	SITE COVERAGE RECALCULATED, VARIANCE REQUIRED.
2	OPEN SITE SPACE CALCULATED PER SCHEDULE A
3	PARKING SPACE LOCATED AND DIMENSIONED PER SCHEDULE C
4	DRIVEWAY PARKING SLOPE DENOTED. DRIVEWAY CROSSING/ SITE TRIANGLES PER SCHEDULE C
5	DRIVEWAY/PARKING MATERIAL PROVIDED
6	AVERAGE GRADE PROPOSED
7	HEIGHT OF BUILDING DIMENSIONED TO FINISHED GRADE (SEE A3.1)
8	REAR SETBACK DIMENSIONED TO POST
9	REAR YARD SITE COVERAGE CALCULATED PER PLAN CHECK COMMENT
10	LOCATION OF GARBAGE/RECYCLING AREA, NO ENCLOSURE REQUIRED
11	POTTED PLANTS DELINEATE GARDEN SUITE USE OF OUTDOOR SPACE, MORE THAN 15m ² MINIMUM (SEE L1.1)
12	EXISTING SITE SERVICES ARE LOCATED ON SITE PLAN. GARDEN SUITE SERVICES WILL BE CONNECTED TO EXISTING. UPGRADE AND RELOCATION (SEWER LINE) AS REQUIRED
13	STORMWATER MANAGEMENT: MEASURES INCORPORATED TO MANAGE STORMWATER RUNOFF VIA INTERLOCKING PERMEABLE PAVERS IN THE DRIVING AISLE, RAIN COLLECTION BARRELS AT RAINWATER LEADER LOCATIONS IN ADDITION TO PERIMETER DRAIN AROUND THE BUILDING FOR OVERFLOWS, TREES / VEGETATIONS PLANTED TO HELP WITH RUNOFFS.
14	PARKS DEPARTMENT: ALL TREES ARE OUTSIDE OF THE CONSTRUCTION ZONE EXCEPT ONE, WHICH WILL BE REMOVED. THIS TREE WILL BE REPLACED WITH 5 DWARF FRUIT TREES
15	FIRE DEPARTMENT: SMOKE ALARMS WILL BE INSTALLED PER BCBC

APPLICABLE CODES

- BC BUILDING CODE CURRENT EDITION (2018)
- ENERGY: BCBC 9.36
- VENTILATION: BCBC 9.32

Project Name
READ RESIDENCE - GARDEN SUITE

965 COWICHAN STREET, VICTORIA BC

Sheet Title
SITE PLAN


Drawn By LL Scale AS SHOWN
Designed By LL Date AUGUST 5, 2023
Project Number 100
Sheet Number A1.1 Revision



2 FRONT OF MAIN RESIDENCE
A1.2 N.T.S.



3 BACK OF MAIN RESIDENCE
A1.2 N.T.S.

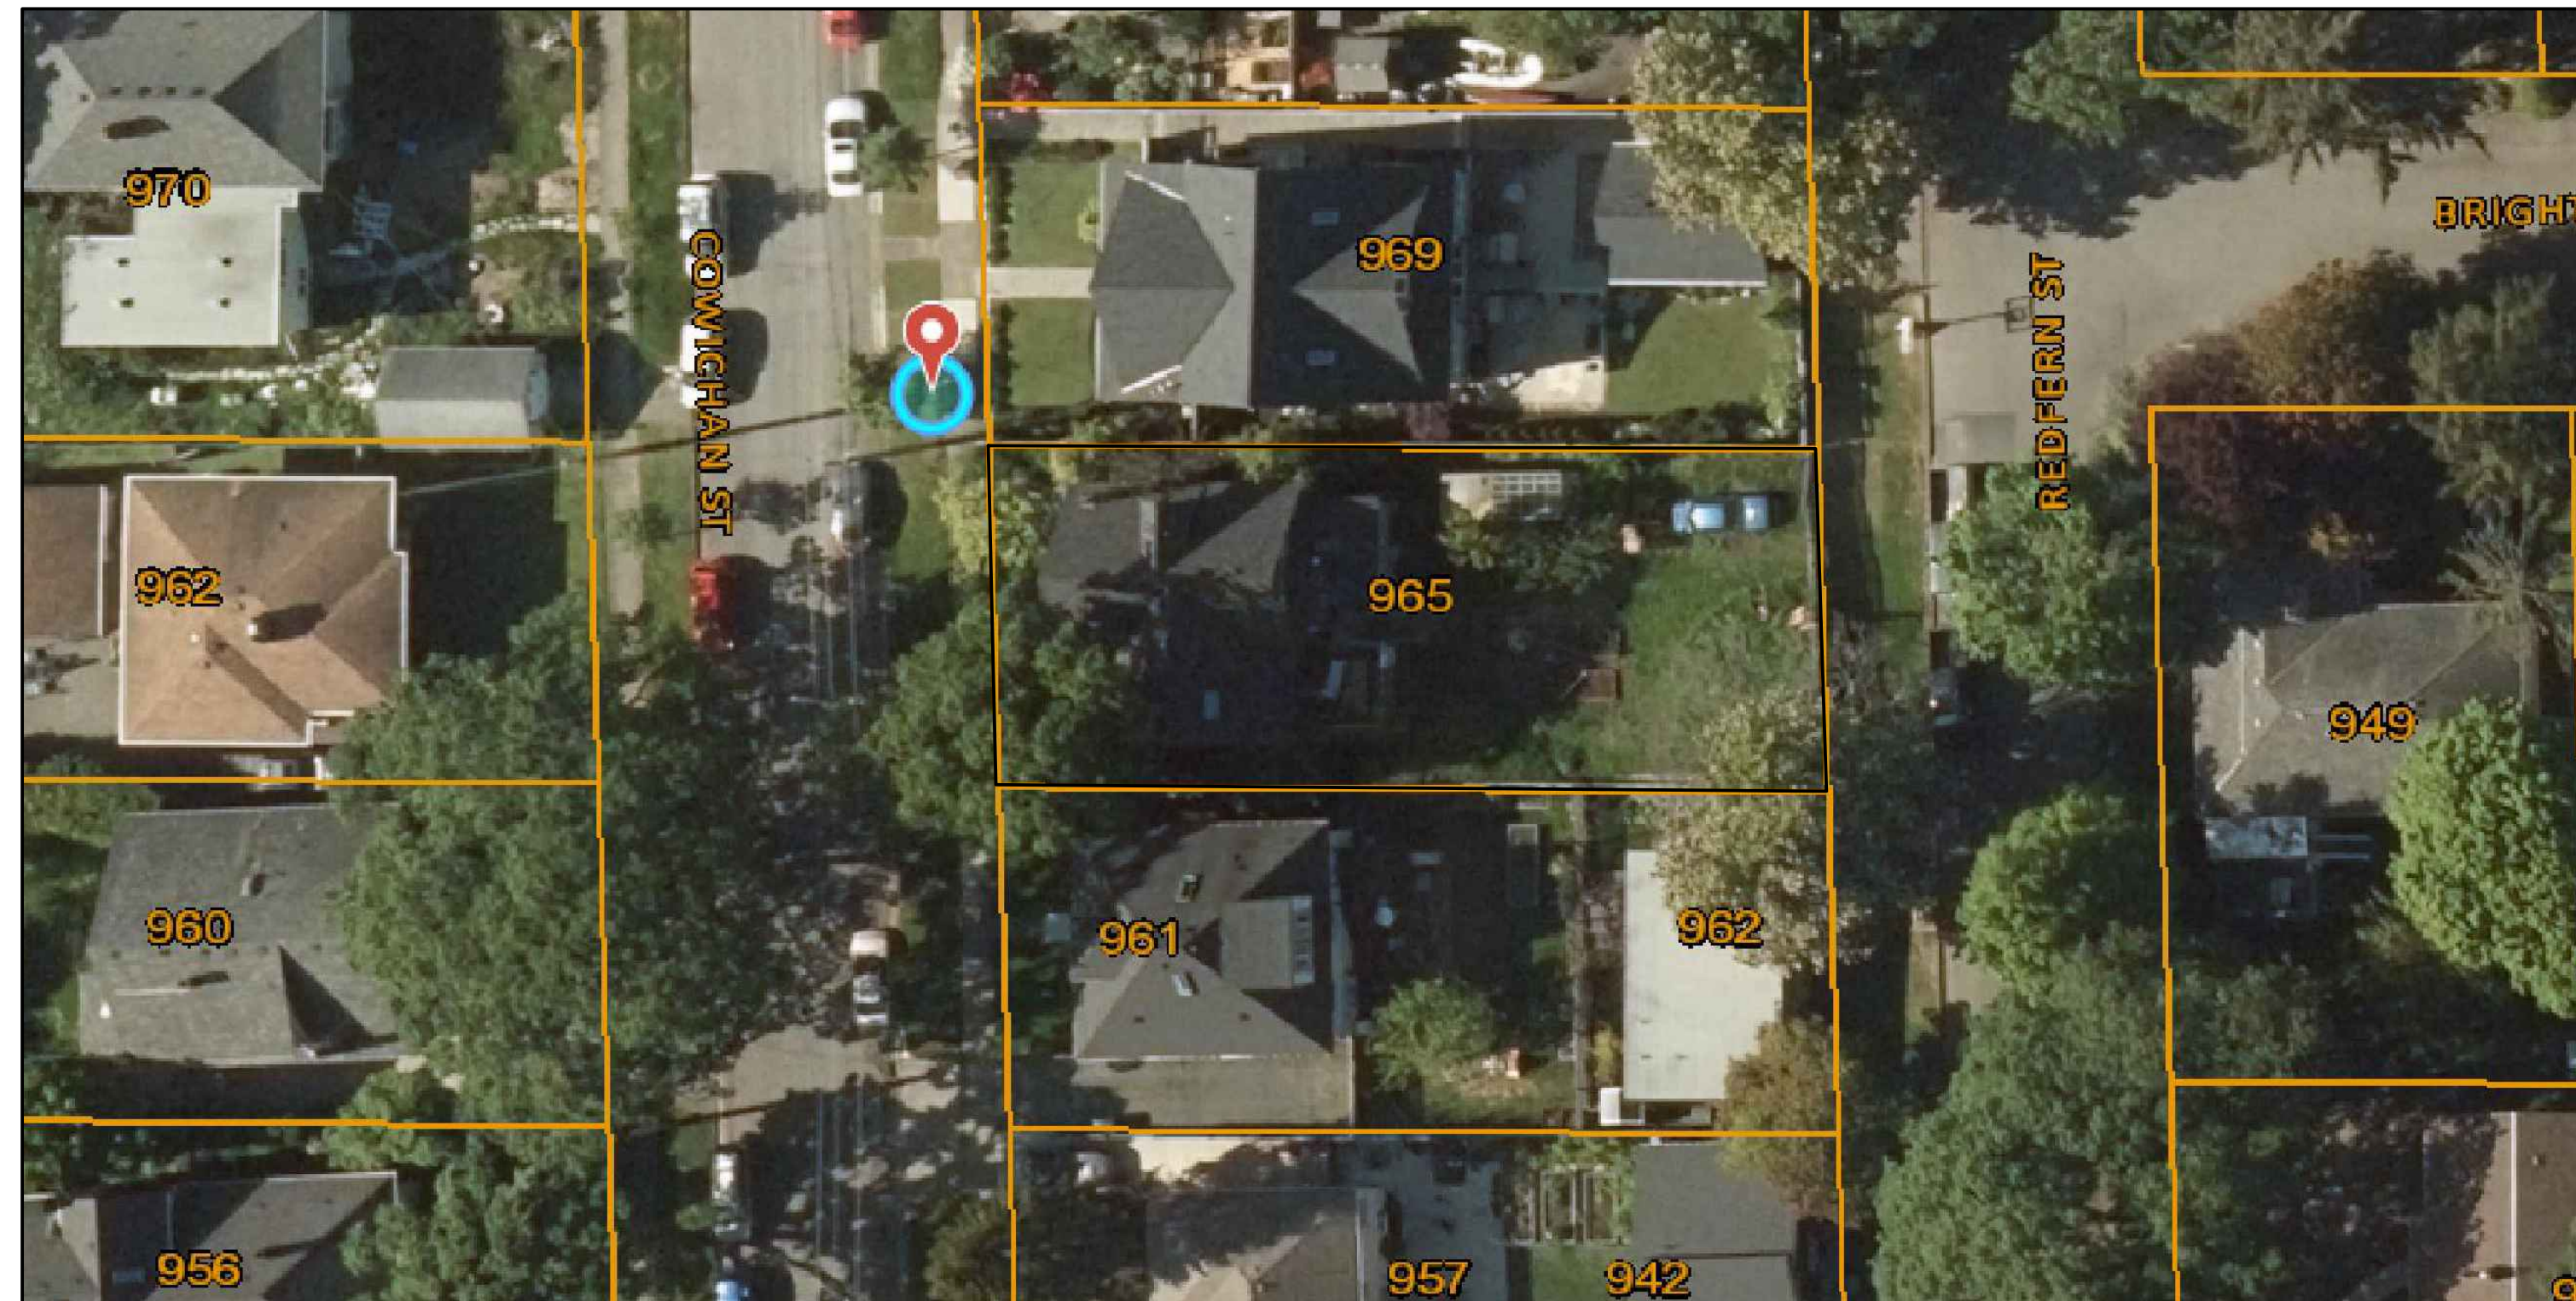

1 AERIAL PHOTO OF PROPERTY AND SURROUNDING AREA
A1.2 N.T.S.

COURTESY OF CRD MAPS

Drawing Notes
All drawings, plans, models, designs, specifications and other documents prepared by Lane Design and used in connection with this project are instruments of service for the work shown in them (the "Work") and as such are and remain the property of Lane Design whether the Work is executed or not, and Lane Design reserves the copyright in them and in the Work executed from them, and they shall not be used for any other work or project.
The general contractor is responsible for confirming and correlating dimensions at the job site. The designer will not be responsible for construction means, methods, techniques, sequences or procedures, or safety precautions and programs in connection with the project.

No.	Revision	Date	By
3	Issued for Variance Application	2023/09/05	LL
2	Re-issued for Delegated Development Permit	2023/06/29	LL
1	Delegated Development Permit	2022/10/3	LL



7 REDFERN STREET VIEW OF BACK LOT
A1.2 N.T.S.



6 REDFERN STREET VIEW OF BACK LOT
A1.2 N.T.S.



5 REDFERN STREET VIEW OF BACK LOT
A1.2 N.T.S.



4 REDFERN STREET VIEW OF BACK LOT
A1.2 N.T.S.



11 NORTH SIDE YARD
A1.2 N.T.S.



10 BACK YARD FACING REDFERN STREET
A1.2 N.T.S.



9 BACK YARD FACING REDFERN STREET
A1.2 N.T.S.



8 BACK OF MAIN RESIDENCE
A1.2 N.T.S.

Project Name
READ RESIDENCE - GARDEN SUITE
965 COWICHAN STREET, VICTORIA BC
Sheet Title
PHOTOS OF PROPERTY

Drawn By LL Scale AS SHOWN
Designed By LL Date AUGUST 5, 2023
Project Number 100

Sheet Number A1.2 Revision

GENERAL NOTES

BUILDING ENCLOSURE

- EXTERIOR BUILDING ENVELOPE IS TO BE DESIGNED AND INSTALLED IN ACCORDANCE WITH REGIONAL BEST PRACTICES, THE 2018 BRITISH COLUMBIA BUILDING CODE, AND IN GENERAL CONFORMANCE WITH THESE DRAWINGS.
- INSULATION, AIR AND VAPOUR BARRIERS, MOISTURE PROTECTION, VENTILATION, HEATING, AND DOMESTIC WATER HEATING ARE TO BE DESIGNED AND INSTALLED PER SECTION 9.36 OF THE BRITISH COLUMBIA BUILDING CODE.
- ALL DOORS, WINDOWS AND SKYLIGHTS TO CONFORM TO NAFS (NORTH AMERICAN FENESTRATION STANDARD) AS WELL AS A440S1-09 CANADIAN SUPPLEMENT TO AAMA/WDMA/CSA 101/1.5.2/A440, NAFS - NORTH AMERICAN FENESTRATION STANDARD FOR WINDOWS, DOORS, AND SKYLIGHTS.
- OPEN TERRAIN EXPOSURE TO BE ASSUMED FOR ALL DOORS, WINDOWS, AND SKYLIGHTS. THE PERFORMANCE GRADE OF ALL RESIDENTIAL DOORS, WINDOWS, AND SKYLIGHTS MUST MEET CLASS R, PG40 (PG 1440 - METRIC), DESIGN PRESSURES OF +/-1920 PA. WATER PENETRATION TEST PRESSURE OF 330 PA AND WATER INFILTRATION/EXFILTRATION LEVEL A2.
- ALL DOORS AND WINDOWS TO MEET OR EXCEED THE THERMAL PERFORMANCE REQUIREMENTS OF TABLE 9.36.2.7.A. SKYLIGHTS TO MEET OR EXCEED THE THERMAL PERFORMANCE REQUIREMENTS OF TABLE 9.36.2.7.B.

GENERAL STRUCTURAL NOTES



- SEISMIC LATERAL SYSTEM AND STRUCTURE TO CONFORM TO PART 9 OF THE BCBC OR TO BE DESIGNED BY A STRUCTURAL ENGINEER.
- FOUNDATIONS AND FOOTINGS MUST BEAR ON UNDISTURBED SOIL, ROCK, OR COMPACTED GRANULAR FILL WITH AN ALLOWABLE BEARING PRESSURE OF 100 KPA OR GREATER.

OTHER


- INSULATE ALL HOT WATER LINES BELOW SLAB TO R20 MINIMUM.
- MECHANICAL, ELECTRICAL, GAS AND PLUMBING COMPONENTS PLACED WITHIN AND PARALLEL TO AN EXTERIOR WALL ARE REQUIRED TO BE INSULATED TO THE EFFECTING THERMAL RESISTANCE REQUIRED FOR THE WALL AT THE PROJECTED AREA OF THE SYSTEM COMPONENT.
- INSTALL HARD WIRED INTERCONNECTED SMOKE ALARMS ON ALL LEVELS AND IN ALL SLEEPING ROOMS PER BCBC SECTION 9.10.19.
- INSTALL HARD WIRED CARBON MONOXIDE DETECTORS PER BCBC SECTION 9.32.4.2.
- VENTILATION TO BE PER BCBC SECTION 9.32

THERMAL CALCULATIONS


- ASSEMBLY CALCULATION TABLES (EFFECTIVE RSI/R-VALUES CALCULATED USING THE PARALLEL PATH METHOD)

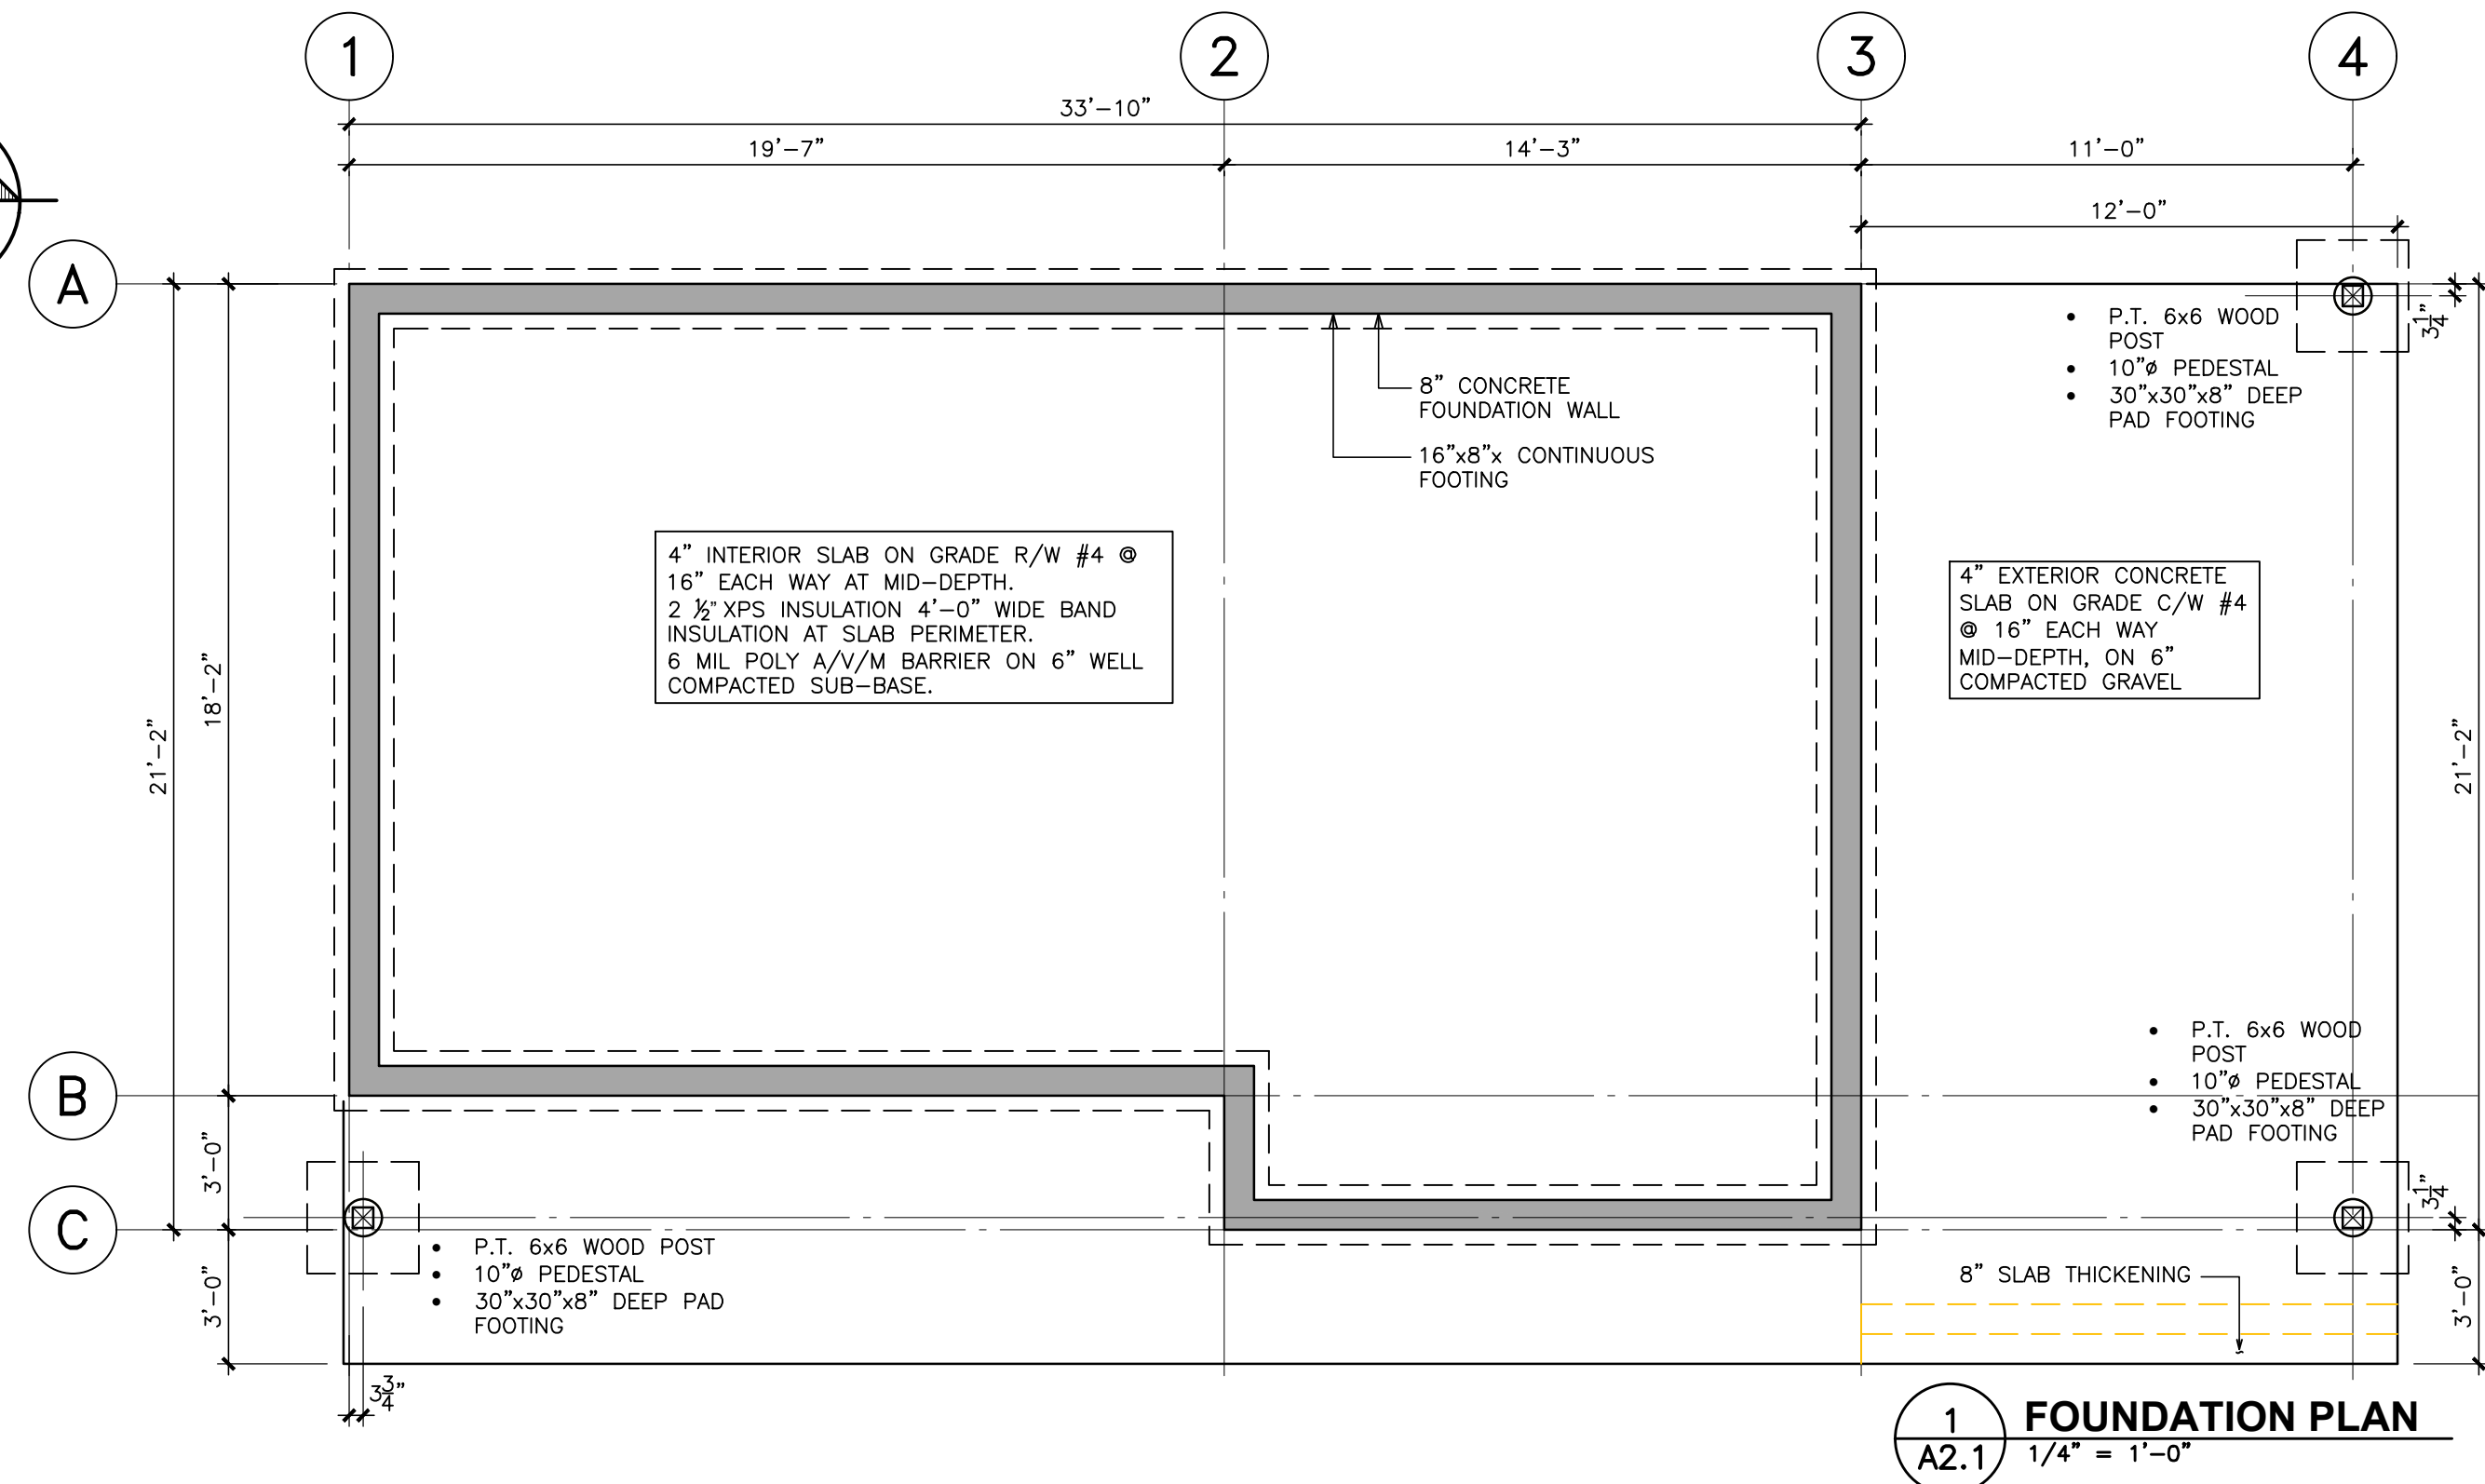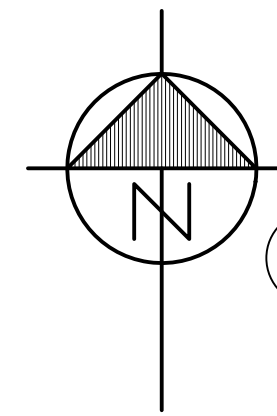

1 FOUNDATION PLAN
A2.1 1/4" = 1'-0"

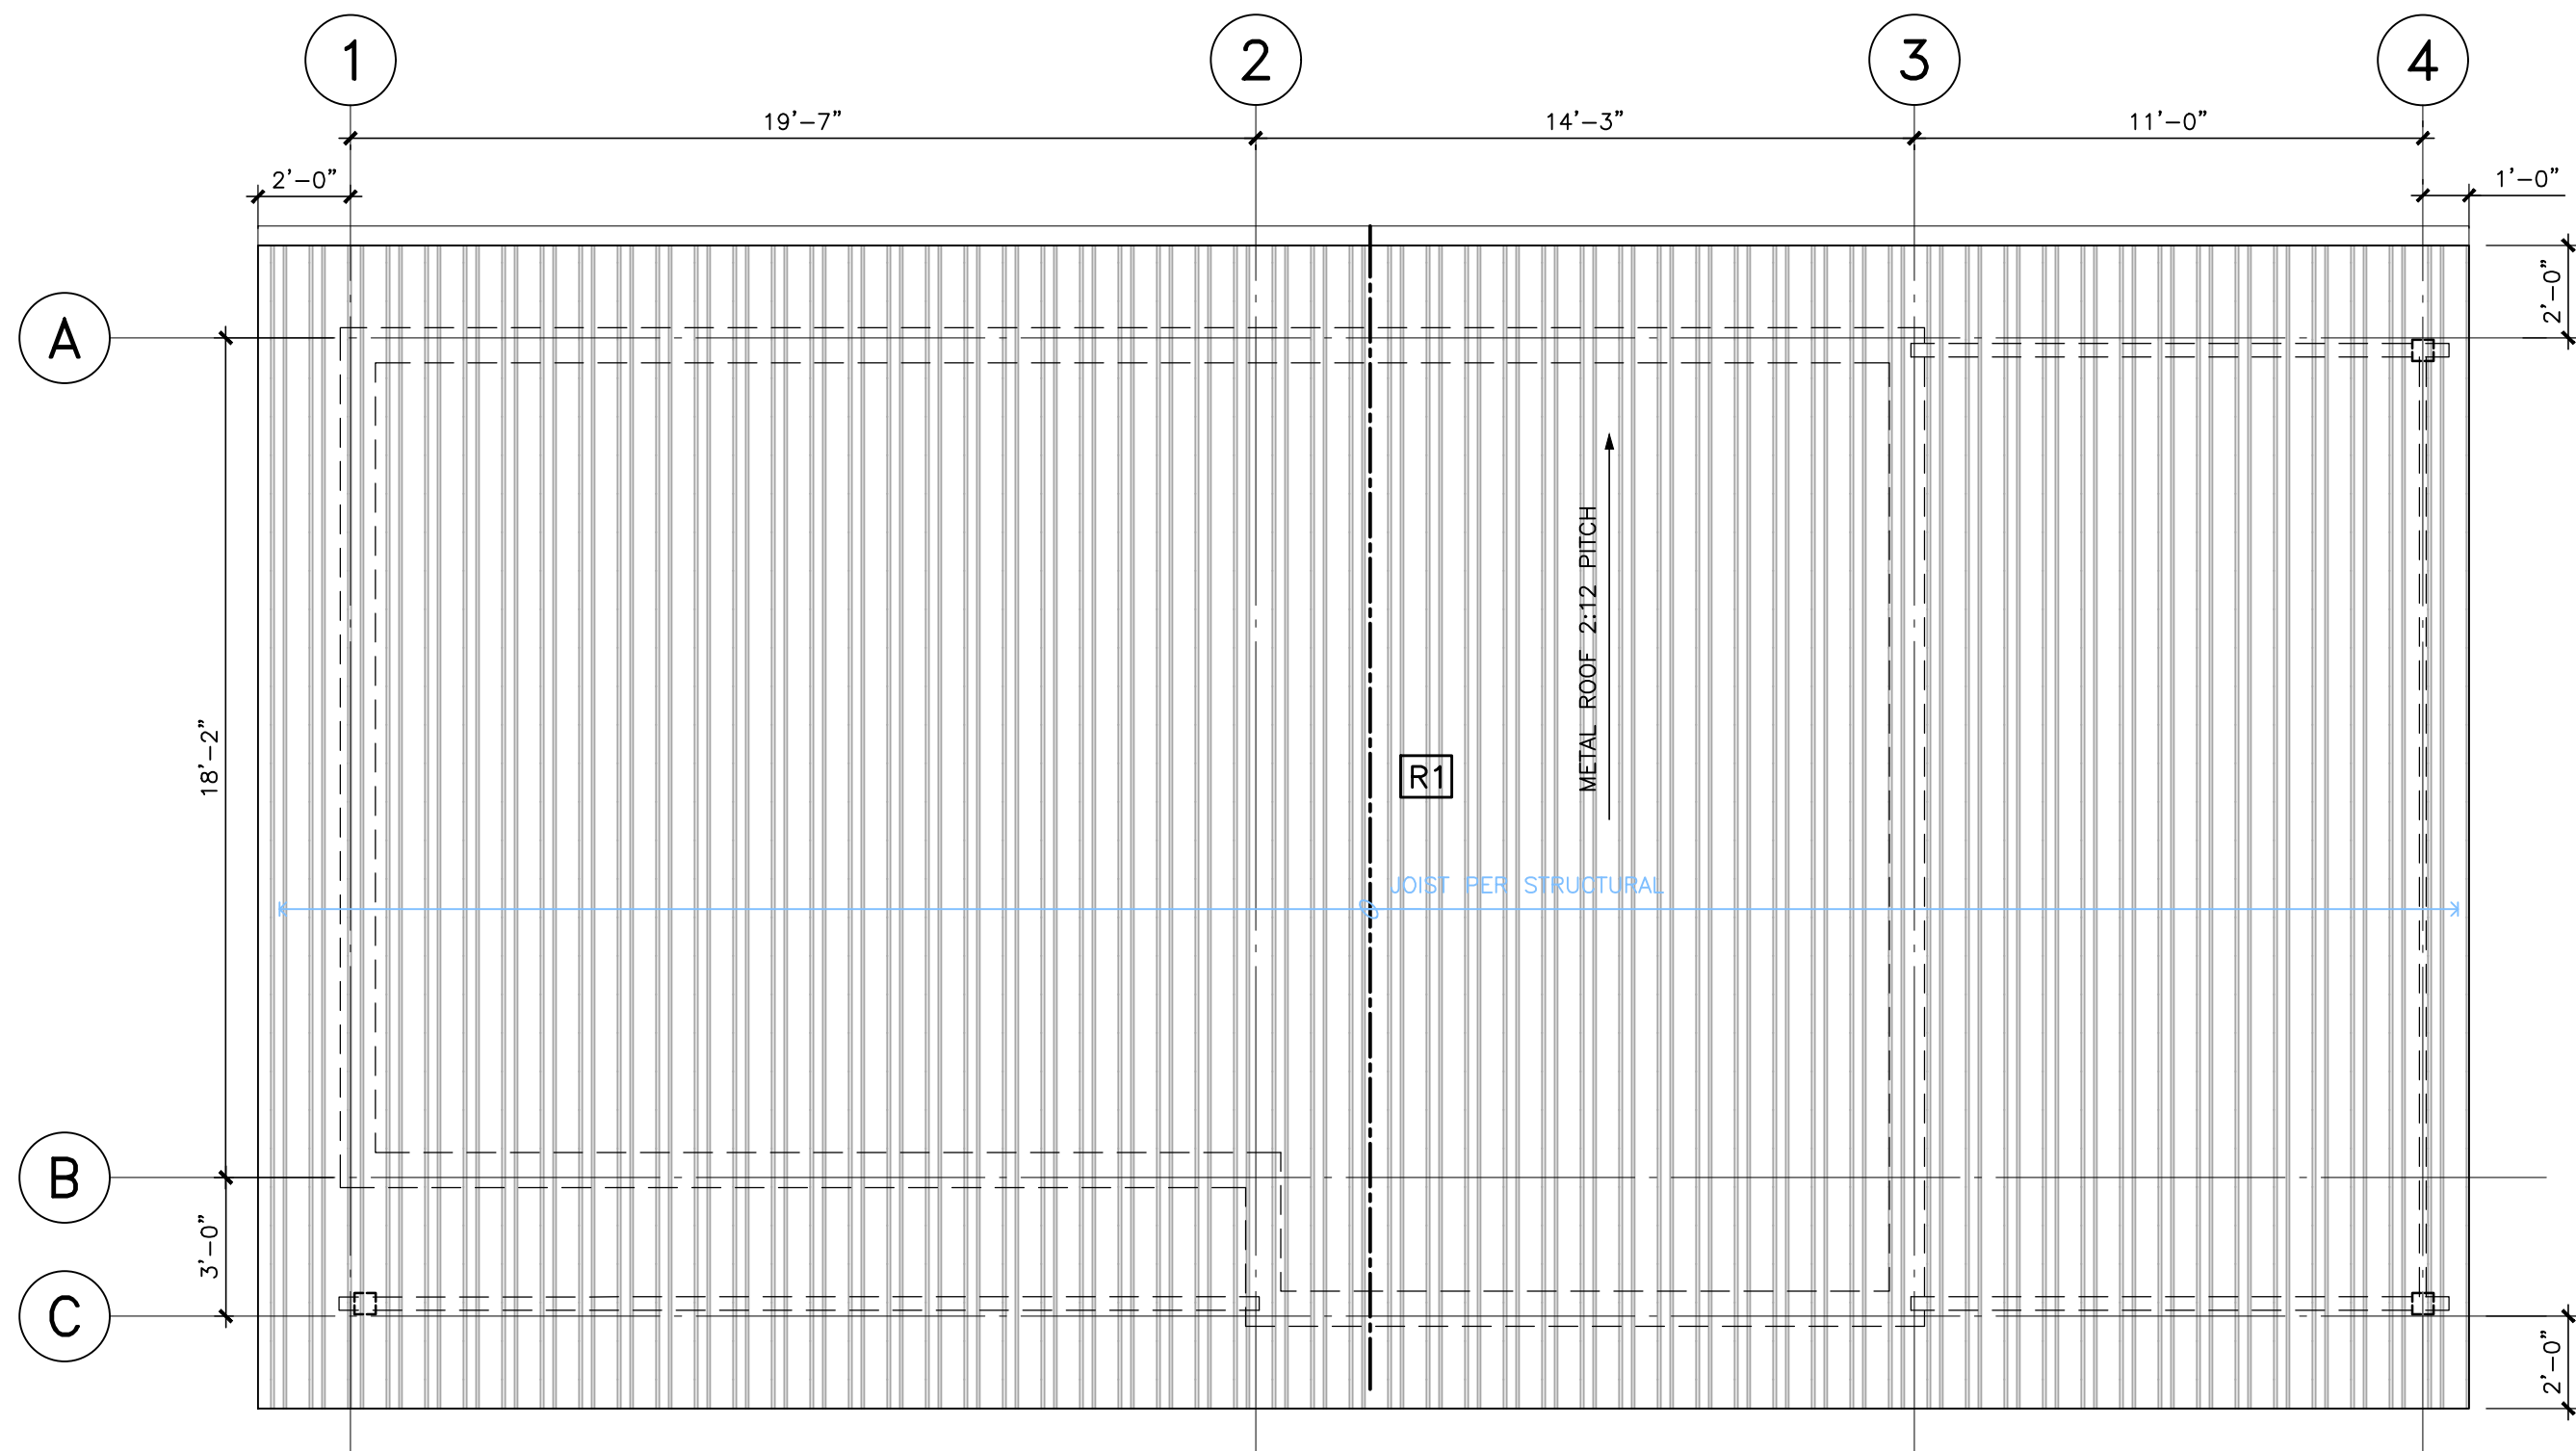

3 ROOF PLAN
A2.1 1/4" = 1'-0"

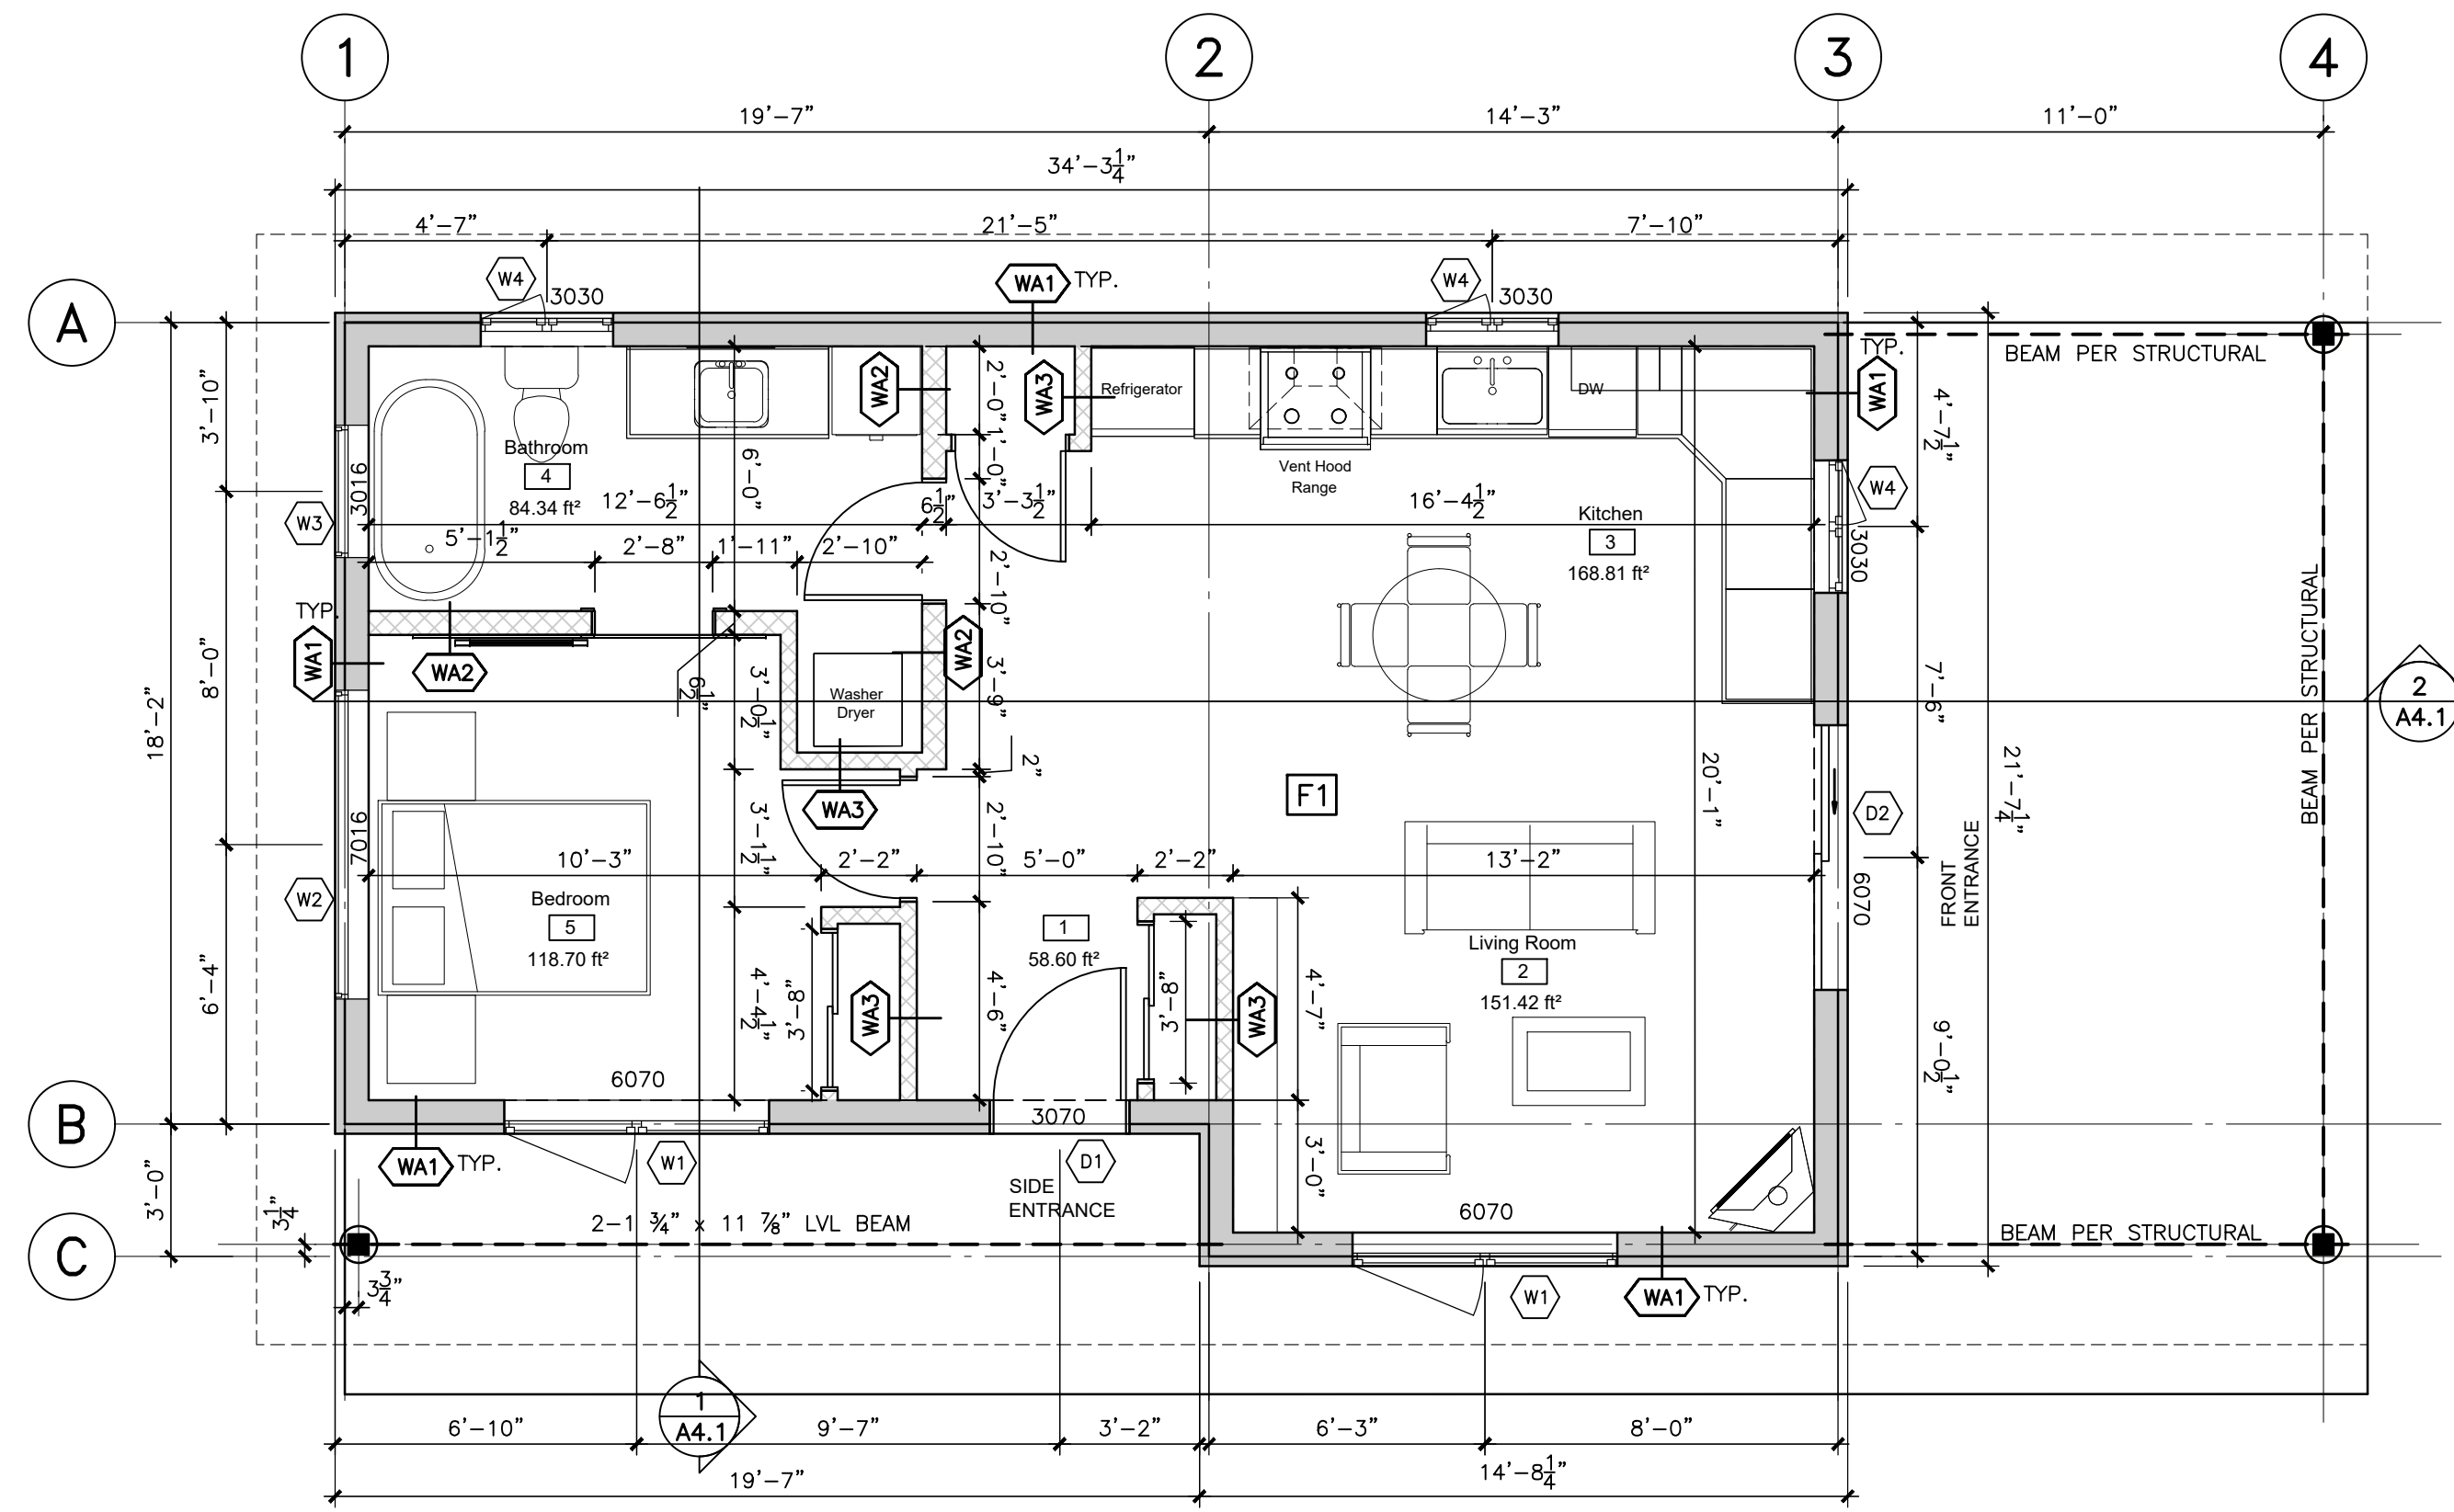

2 GROUND FLOOR PLAN
A2.1 1/4" = 1'-0"

R1	ROOF - FRAMED RAFTER - CATHEDRAL CEILING	RSI	R
1	METAL ROOF	0.00	0.00
2	VAPOUR PERMEABLE UNDERLAYMENT	0.00	0.00
3	5/8" EXTERIOR PLYWOOD SHEATHING	0.135	0.77
4	EXTERIOR AIR FILM (WITHIN JOIST SPACE)	0.16	0.91
5	2x4 WOOD PURLINS ON FLAT @ 16" O/C	0.00	0.00
6	11-7/8" ENGINEERED JOISTS @ 24" O/C	0.00	0.00
7	R33 MINERAL WOOL INSULATION (FACTORED FOR FRAMING)	5.51	31.29
8	6MIL POLY A/V BARRIER	0.00	0.00
9	1/2" PLYWOOD SHEATHING	0.109	0.62
9	INTERIOR AIR FILM	0.11	0.62
EFFECTIVE RSI/R-VALUE OF ENTIRE ASSEMBLY		6.02	34.21
MINIMUM REQUIRED BY BCBC		4.67	26.70

F1	FLOOR - BASEMENT SLAB ON GRADE	RSI	R
1	COMPACTED SUB-BASE	N/A	N/A
2	6 MIL POLY A/V/M BARRIER	N/A	N/A
3	2 1/2" XPS INSULATION (PERIMETER TO CODE); 4'-0" WIDE BAND INSULATION AT SLAB PERIMETER ONLY PER 9.36.4.b.i	N/A	N/A
4	4" CONCRETE S.O.G.	N/A	N/A
5	LEVEL AND SMOOTH TROWELLED FINISH	N/A	N/A
EFFECTIVE RSI/R-VALUE OF ENTIRE ASSEMBLY		N/A	N/A
MINIMUM REQUIRED BY BCBC		N/A	N/A

WA1	TYPICAL EXTERIOR WALL	RSI	R
1	CLADDING (METAL)	0.00	0.00
2	3/4" AIR SPACE (FROM STRAPPING)	0.18	1.00
3	1/2" P.T. RAINSCREEN STRAPPING @ 16" O/C C/W INSECT SCREEN T&B	0.00	0.00
4	1 1/2" EXTERIOR INSULATION (MINERAL WOOL)	1.05	5.98
5	AIR/MOISTURE BARRIER MEMBRANE TO CODE	0.00	0.00
6	1/2" PLYWOOD SHEATHING	0.109	0.62
7	R-19 BATT INSULATION (FACTORED FOR FRAMING)	2.36	13.40
8	2X6 WALL STUDS @ 16" O/C (SPF #2 OR BETTER)	0.00	0.00
9	6MIL POLY A/V BARRIER	0.00	0.00
10	1/2" PLYWOOD SHEATHING	0.109	0.62
11	FINISH TO OWNER'S SPECIFICATION	0.00	0.00
12	INTERIOR AIR FILM	0.12	0.68
EFFECTIVE RSI/R-VALUE OF ENTIRE ASSEMBLY		3.93	22.30
MINIMUM REQUIRED BY BCBC 9.36.2.6.A		2.78	15.80

WA2	2x6 INTERIOR WALL WITH 1/2" PLYWOOD SHEATHING BOTH SIDES		
WA3	2x4 INTERIOR WALL WITH 1/2" PLYWOOD SHEATHING BOTH SIDES		

LEGEND

- NON-LOAD BEARING WALL
- LOAD BEARING STUD WALL
- CONCRETE WALL
- FOOTING
- POST
- BEAM
- JOIST

Drawing Notes
All drawings, plans, models, designs, specifications and other documents prepared by Lane Design and used in connection with this project are instruments of service for the work shown in them (the "Work") and as such are and remain the property of Lane Design whether the Work is executed or not, and Lane Design reserves the copyright in them and in the Work executed from them, and they shall not be used for any other work or project.
The general contractor is responsible for confirming and correlating dimensions at the job site. The designer will not be responsible for construction means, methods, techniques, sequences or procedures, or safety precautions and programs in connection with the project.

No.	Revision	Date	By
3	Issued for Variance Application	2023/09/05	LL
2	Re-issued for Delegated Development Permit	2023/06/29	LL
1	Delegated Development Permit	2022/10/3	LL

Project Name
READ RESIDENCE - GARDEN SUITE

965 COWICHAN STREET, VICTORIA BC

Sheet Title

PLANS

Drawn By **LL** Scale **AS SHOWN**

Designed By **LL** Date **AUGUST 5, 2023**







Project Number **100**

Sheet Number **A2.1** Revision

Drawing Notes

All drawings, plans, models, designs, specifications and other documents prepared by Lane Design and used in connection with this project are instruments of service for the work shown in them (the "Work") and as such are and remain the property of Lane Design whether the Work is executed or not, and Lane Design reserves the copyright in them and in the Work executed from them, and they shall not be used for any other work or project.

The general contractor is responsible for confirming and correlating dimensions at the job site. The designer will not be responsible for construction means, methods, techniques, sequences or procedures, or safety precautions and programs in connection with the project.

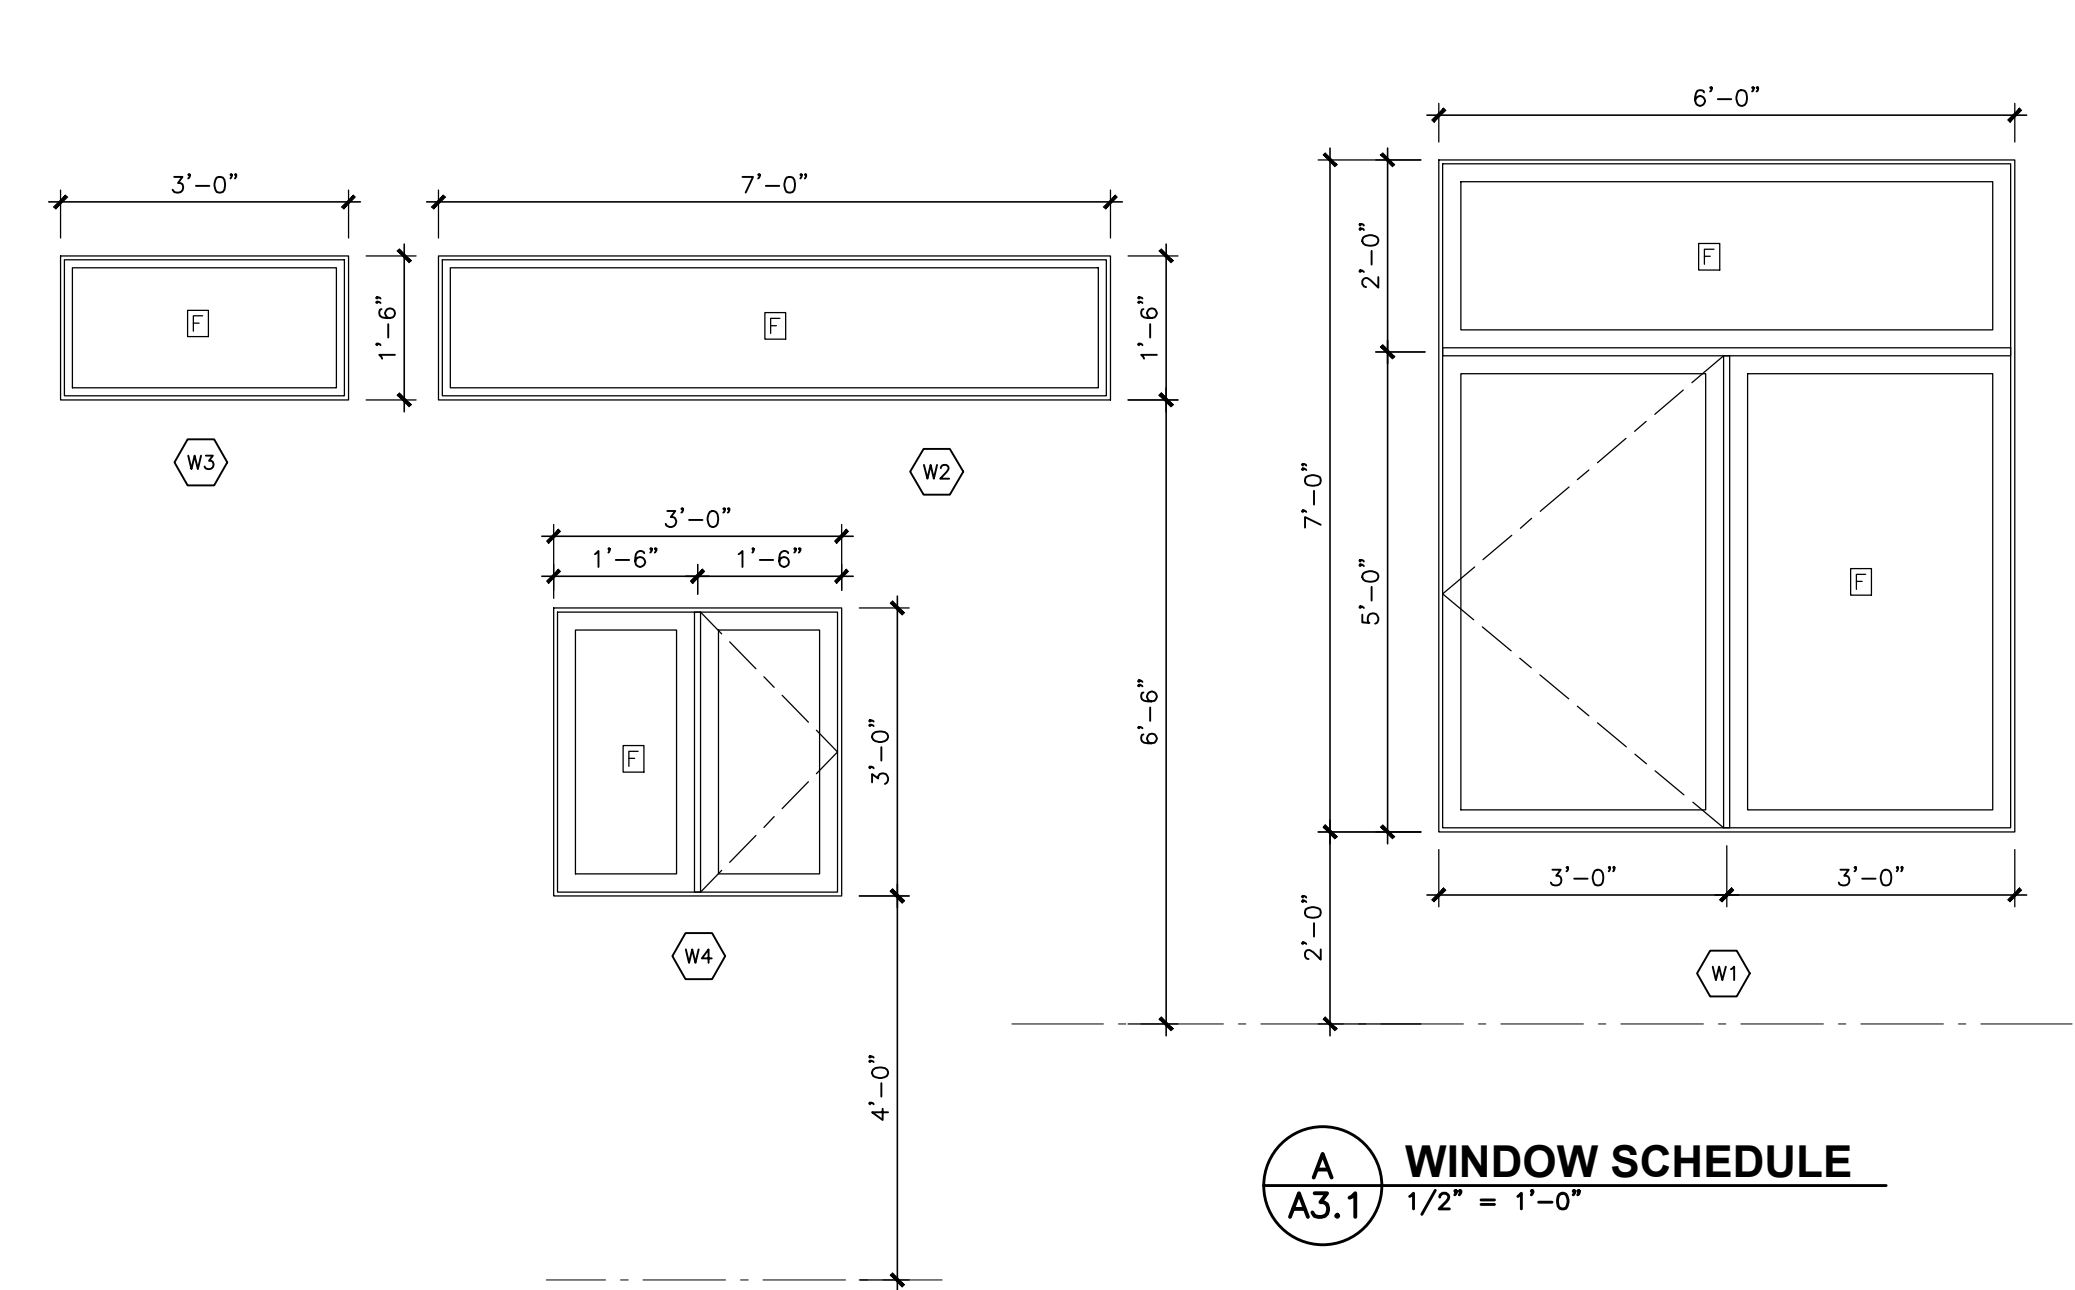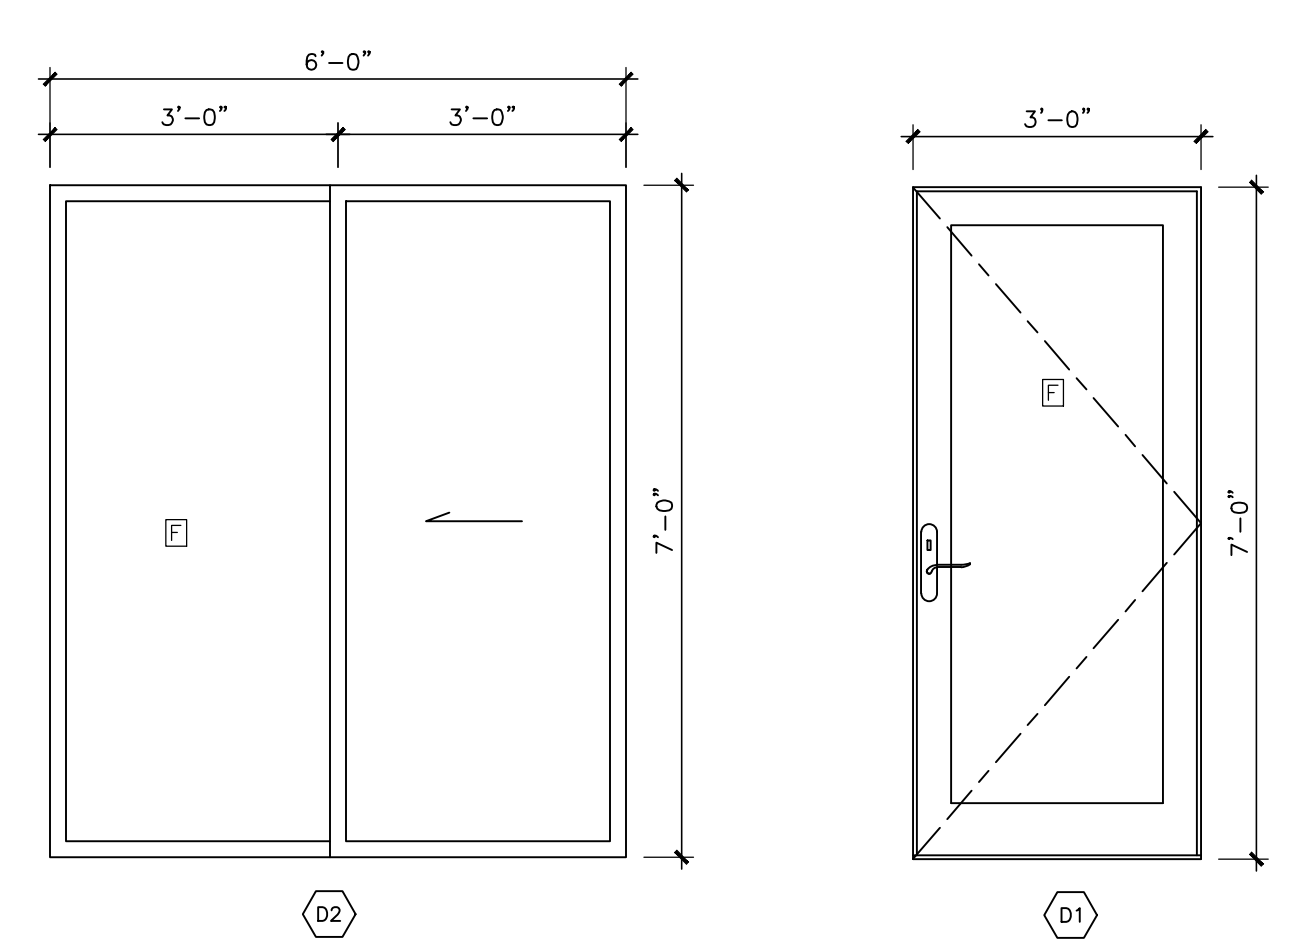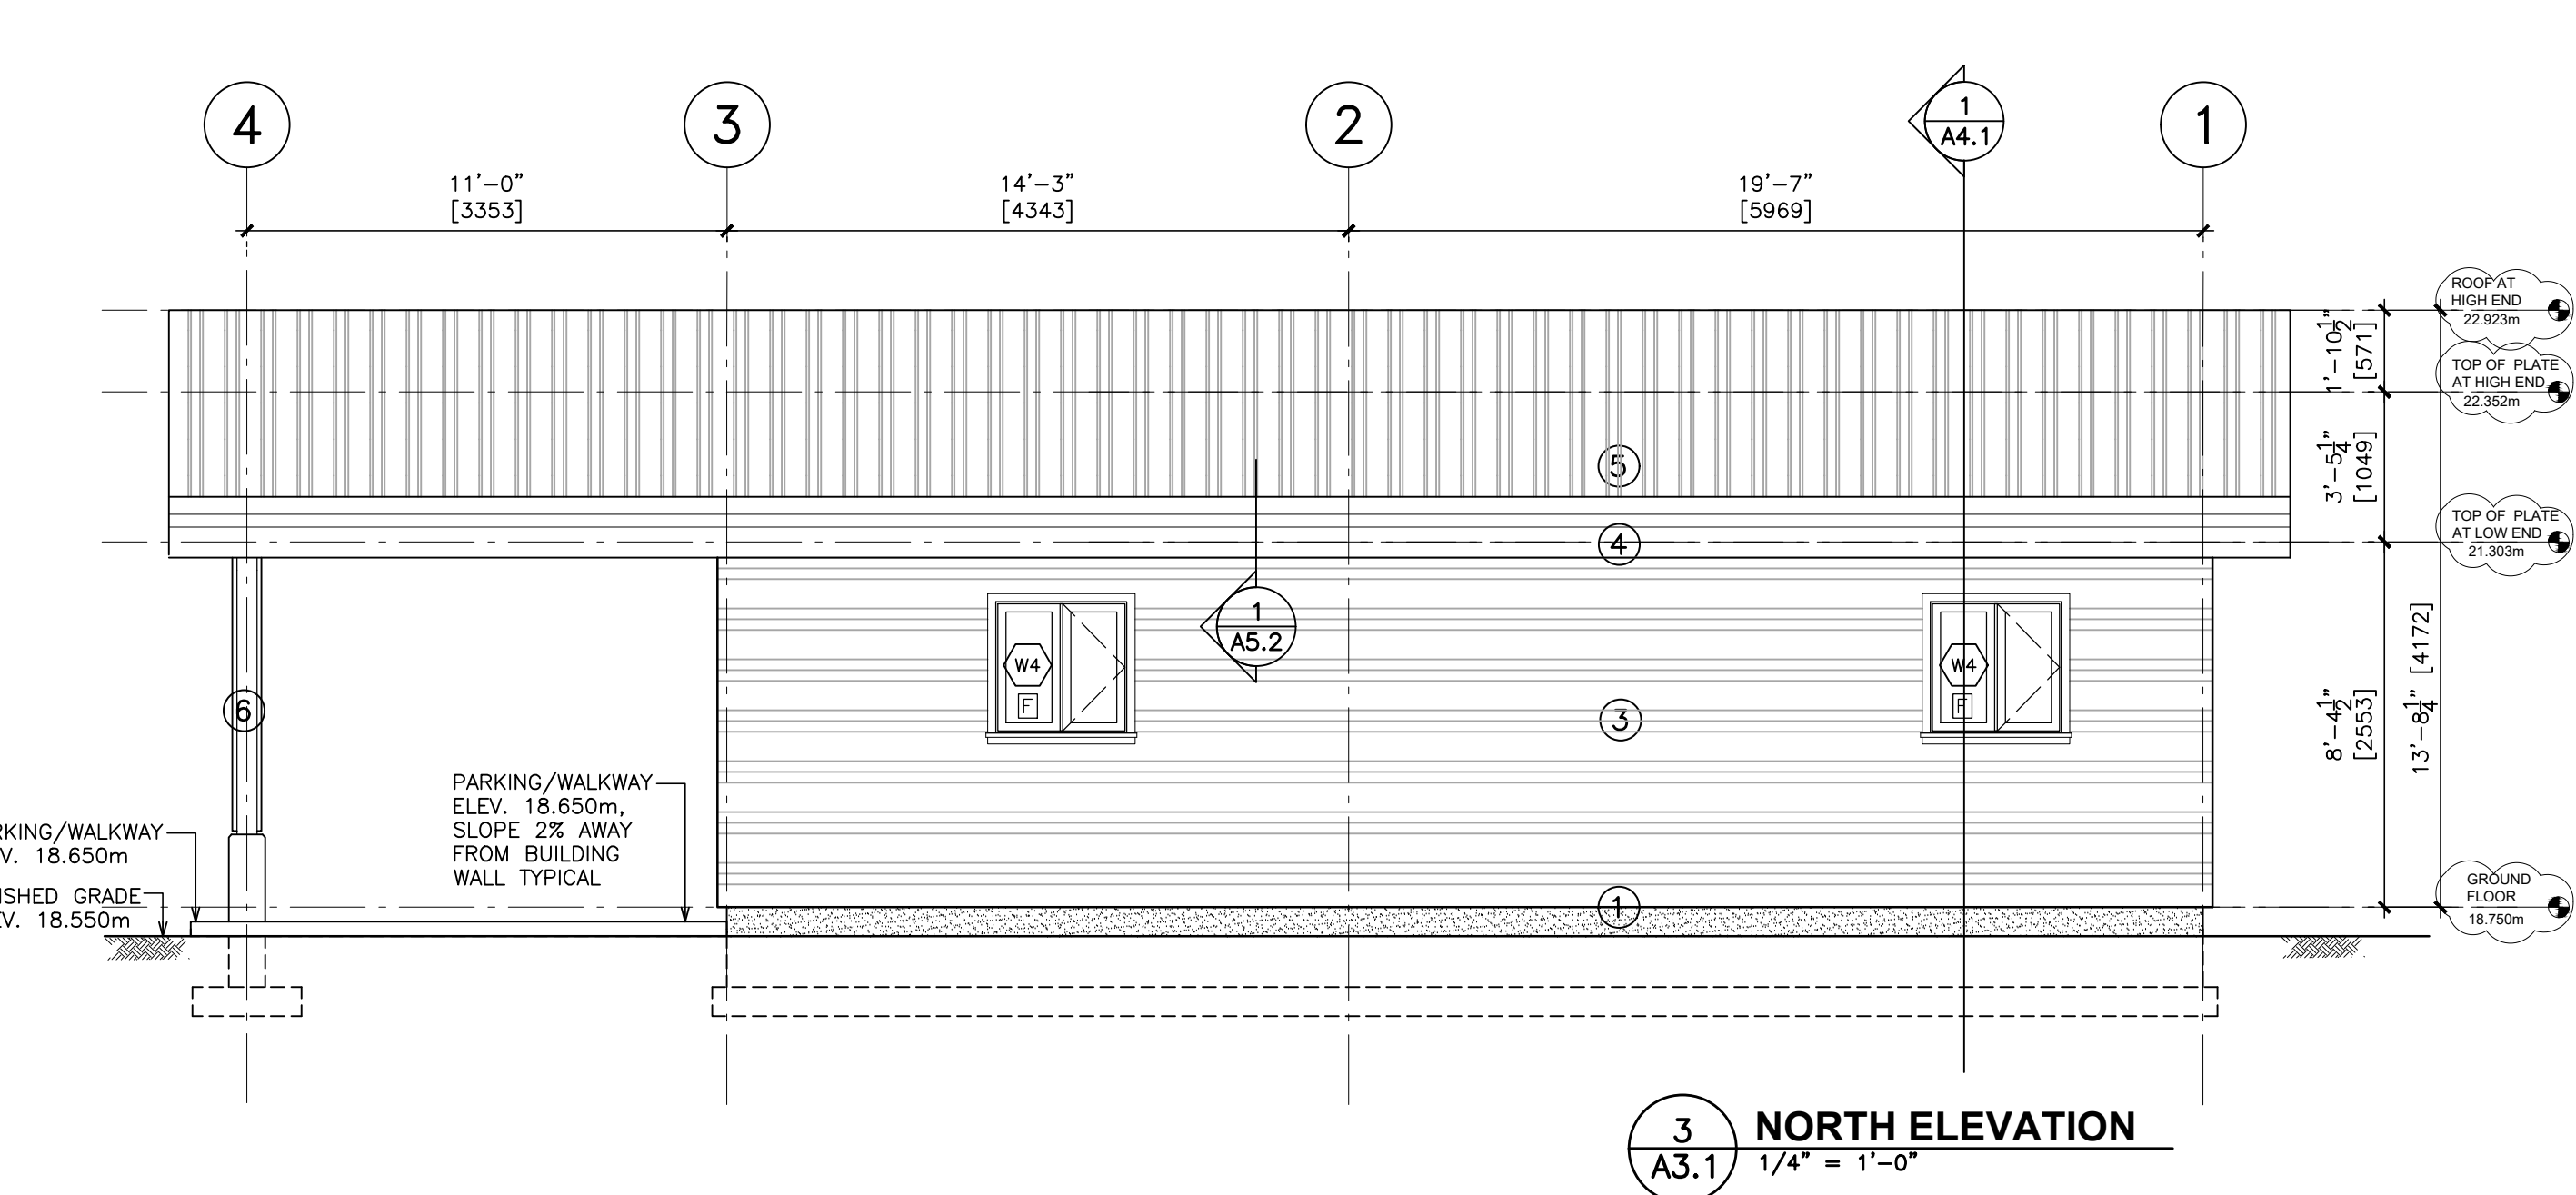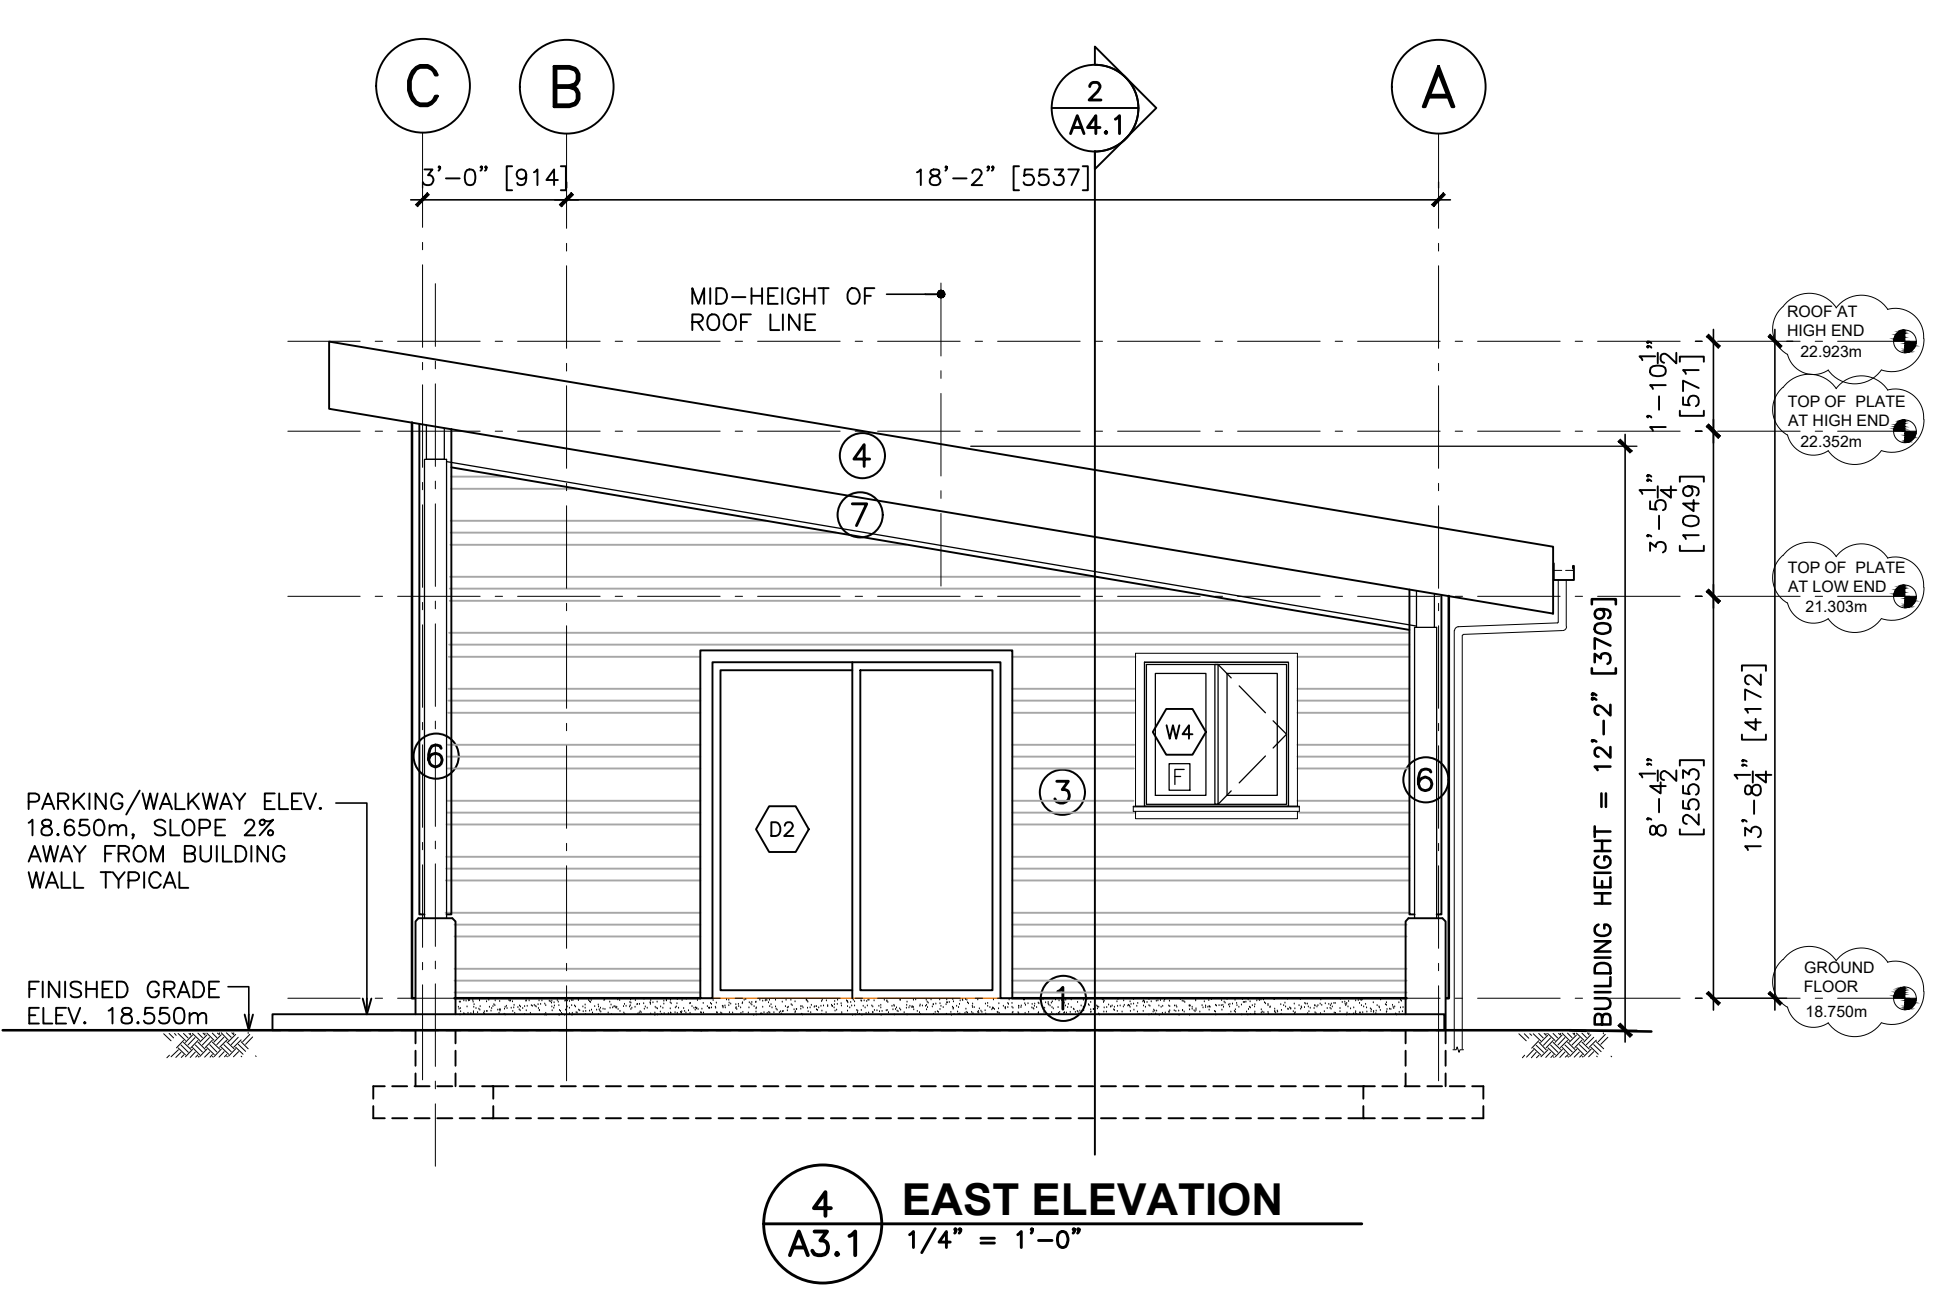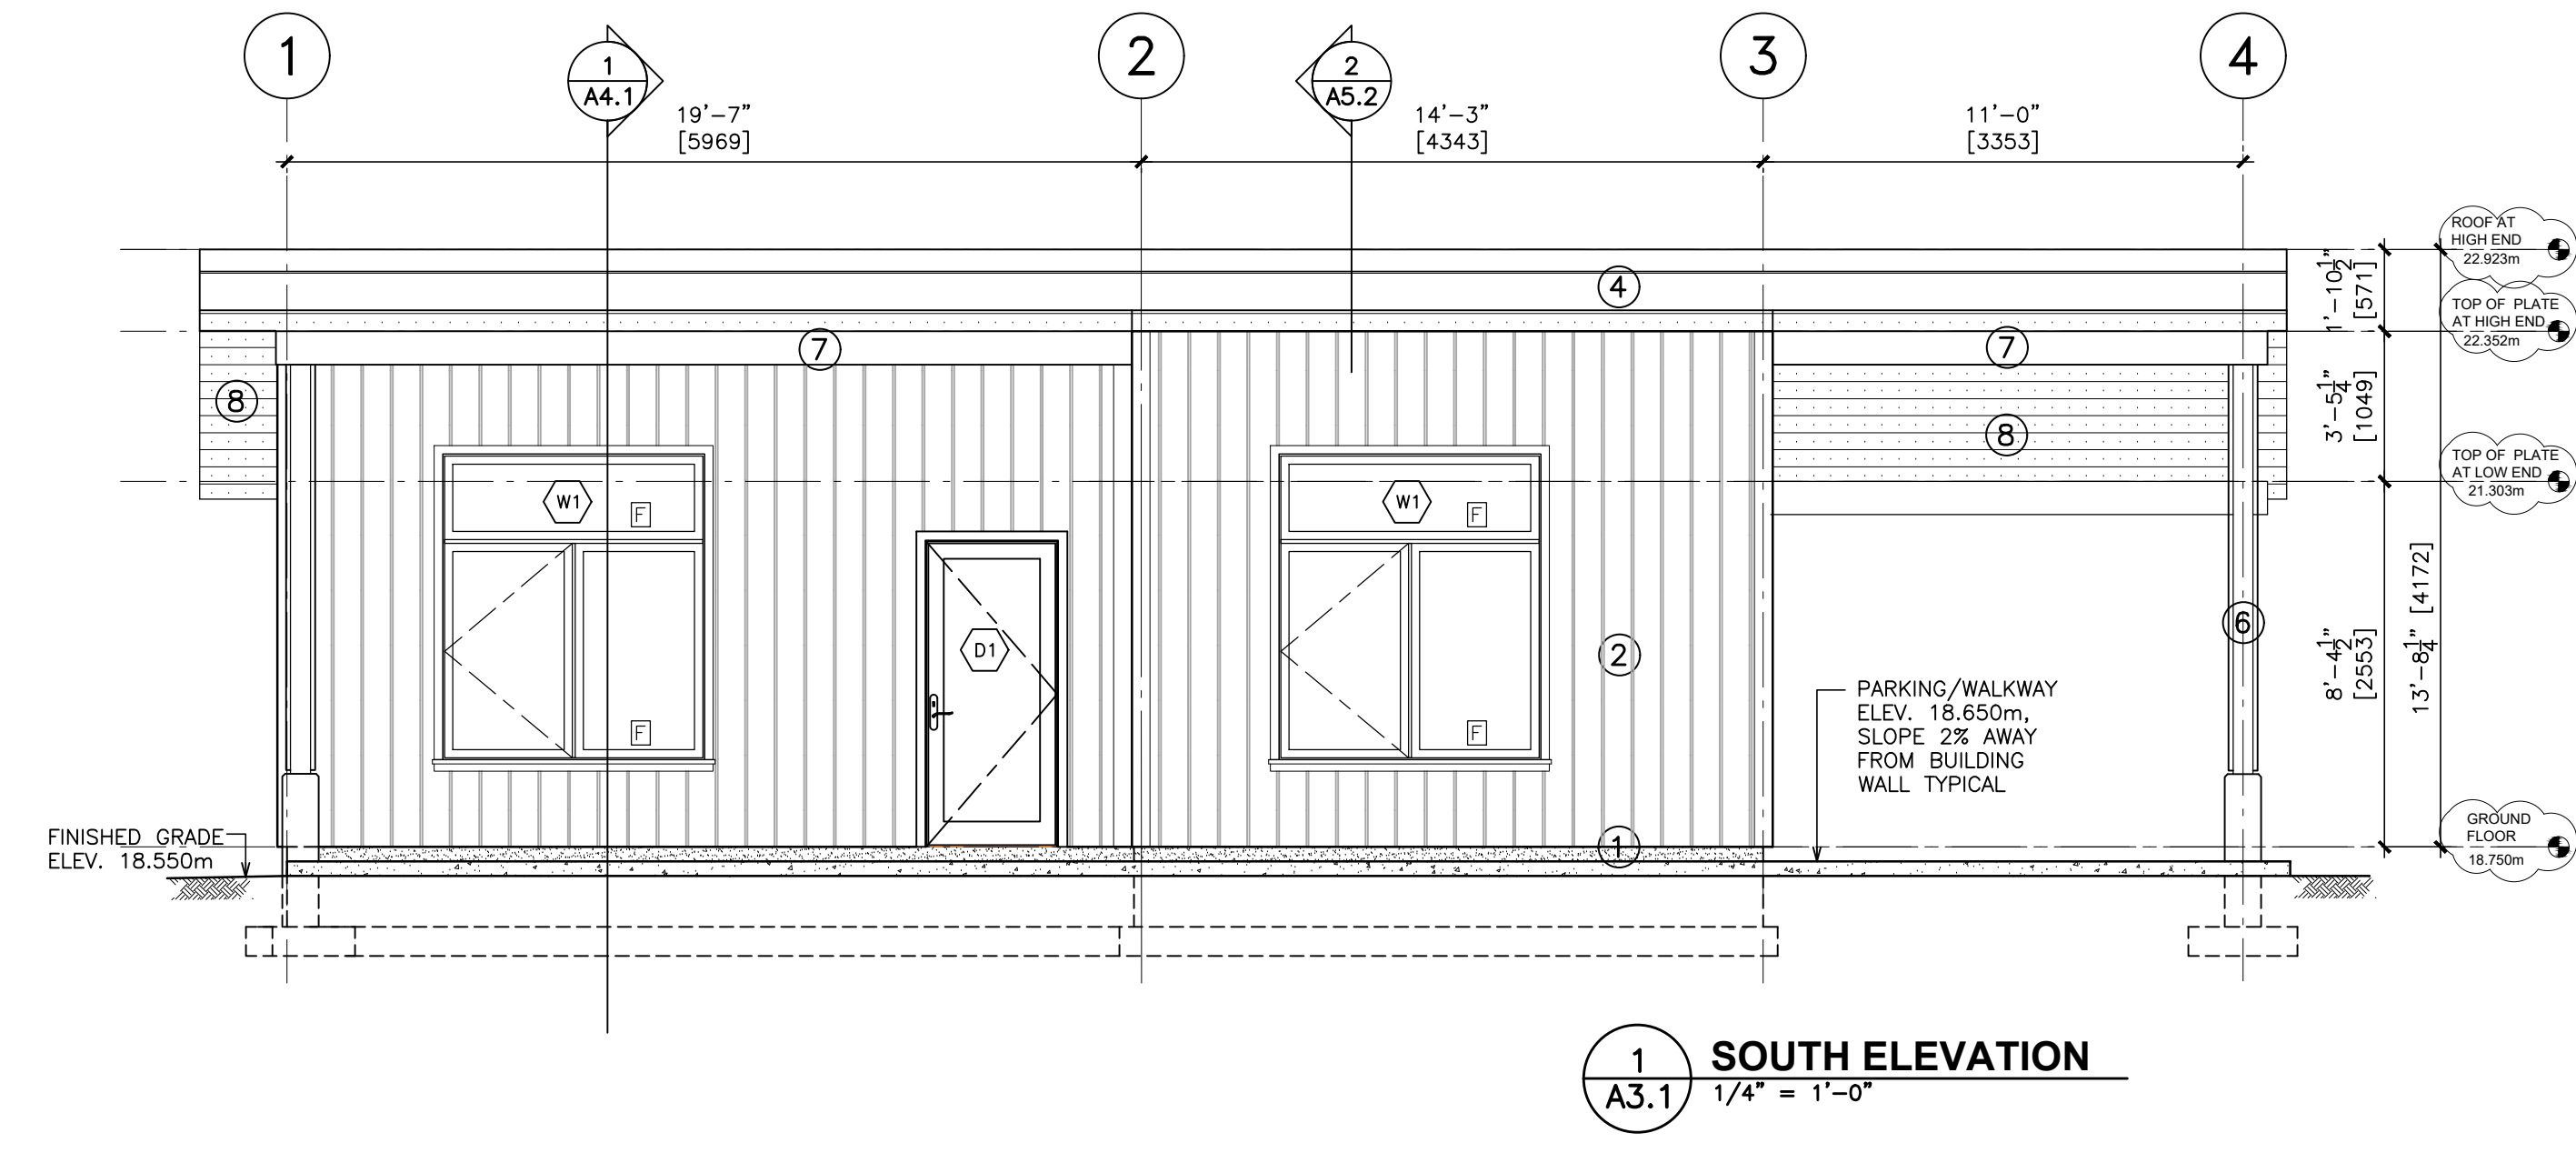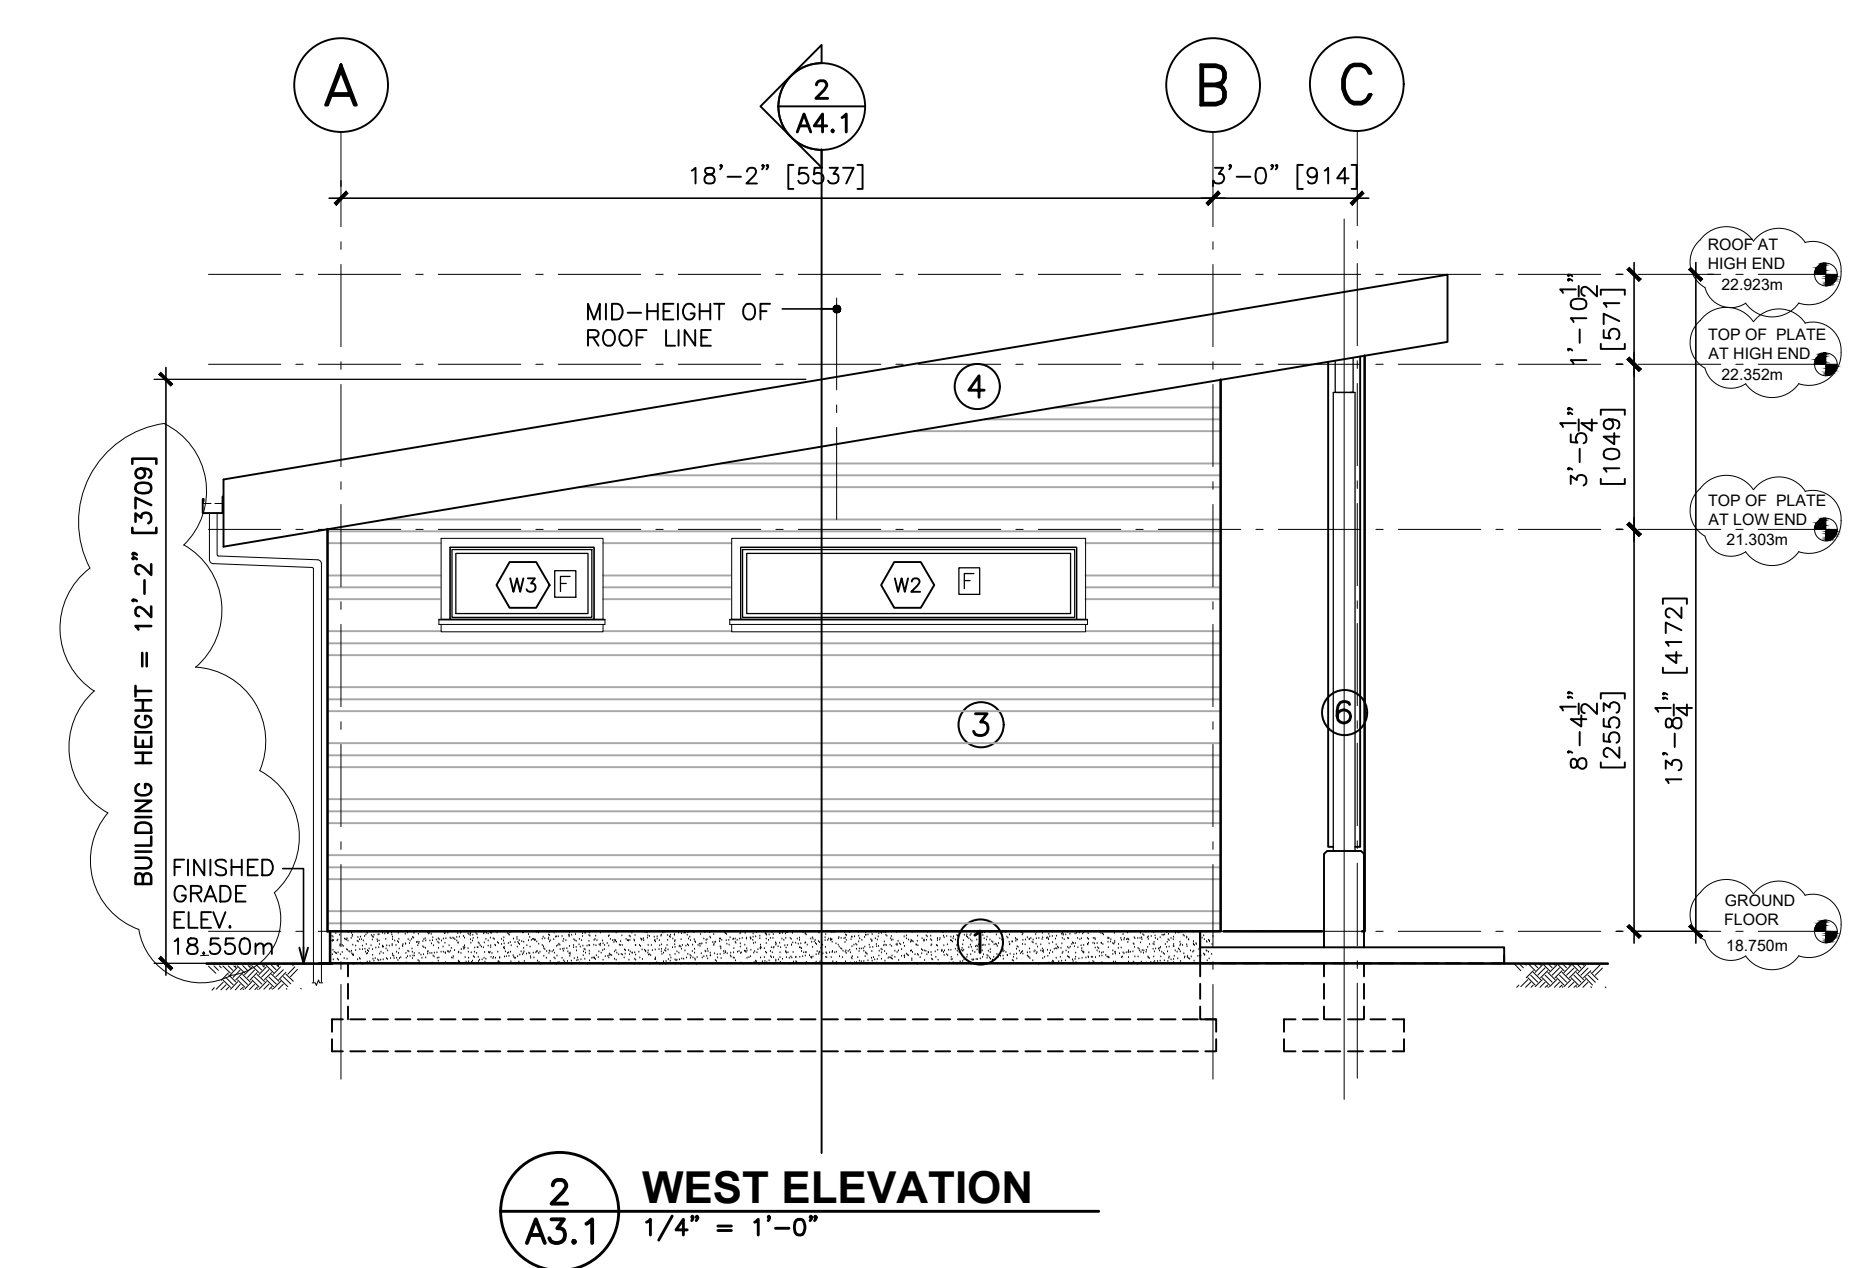

MATERIALS LEGEND

- CONCRETE FACE (CT) INSULATION BOARD
- VERTICAL PROFILE METAL SIDING
- HORIZONTAL PROFILE METAL SIDING
- METAL ROOF FASCIA TRIM
- METAL ROOF ASSEMBLY (WITH GUTTERS & DOWNSPOUTS)
- CEDAR CLADDED EXTERIOR POST
- CEDAR CLADDED EXTERIOR BEAM
- ALUMINUM PERFORATED SOFFIT

NOTES

- WINDOW AND DOOR OPERATIONS SHALL BE PER OWNER'S DIRECTION AND CONFIRM TO BCBC EGRESS REQUIREMENTS. CONTRACTOR TO VERIFY ALL ROUGH OPENINGS PRIOR TO ORDERING WINDOWS/DOORS.
- FLASH OVER ALL MATERIAL TRANSITIONS.
- ALL COLOURS PER OWNER.

GLAZING LEGEND

- NEW WINDOW IDENTIFIER (SEE DRAWING A5.3)
- NEW SWING DOOR IDENTIFIER (SEE DRAWING A5.5)
- NEW SLIDING DOOR IDENTIFIER (SEE DRAWING A5.4)
- FIXED PANE; INSULATED GLAZED UNIT (U.N.O.)
- DENOTES SWING DOOR OR CASEMENT WINDOW, SHOWN AS HINGED AT LEFT
- DOOR SLIDING DIRECTION

No.	Revision	Date	By
3	Issued for Variance Application	2023/09/05	LL
2	Re-issued for Delegated Development Permit	2023/06/29	LL
1	Delegated Development Permit	2022/10/3	LL

Project Name
READ RESIDENCE - GARDEN SUITE

965 COWICHAN STREET, VICTORIA BC


Sheet Title
ELEVATIONS

Drawn By LL Scale AS SHOWN
Designed By LL Date AUGUST 5, 2023
Project Number 100
Sheet Number Revision
A3.1


Drawing Notes

All drawings, plans, models, designs, specifications and other documents prepared by Lane Design and used in connection with this project are instruments of service for the work shown in them (the "Work") and as such are and remain the property of Lane Design whether the Work is executed or not, and Lane Design reserves the copyright in them and in the Work executed from them, and they shall not be used for any other work or project.

The general contractor is responsible for confirming and correlating dimensions at the job site. The designer will not be responsible for construction means, methods, techniques, sequences or procedures, or safety precautions and programs in connection with the project.

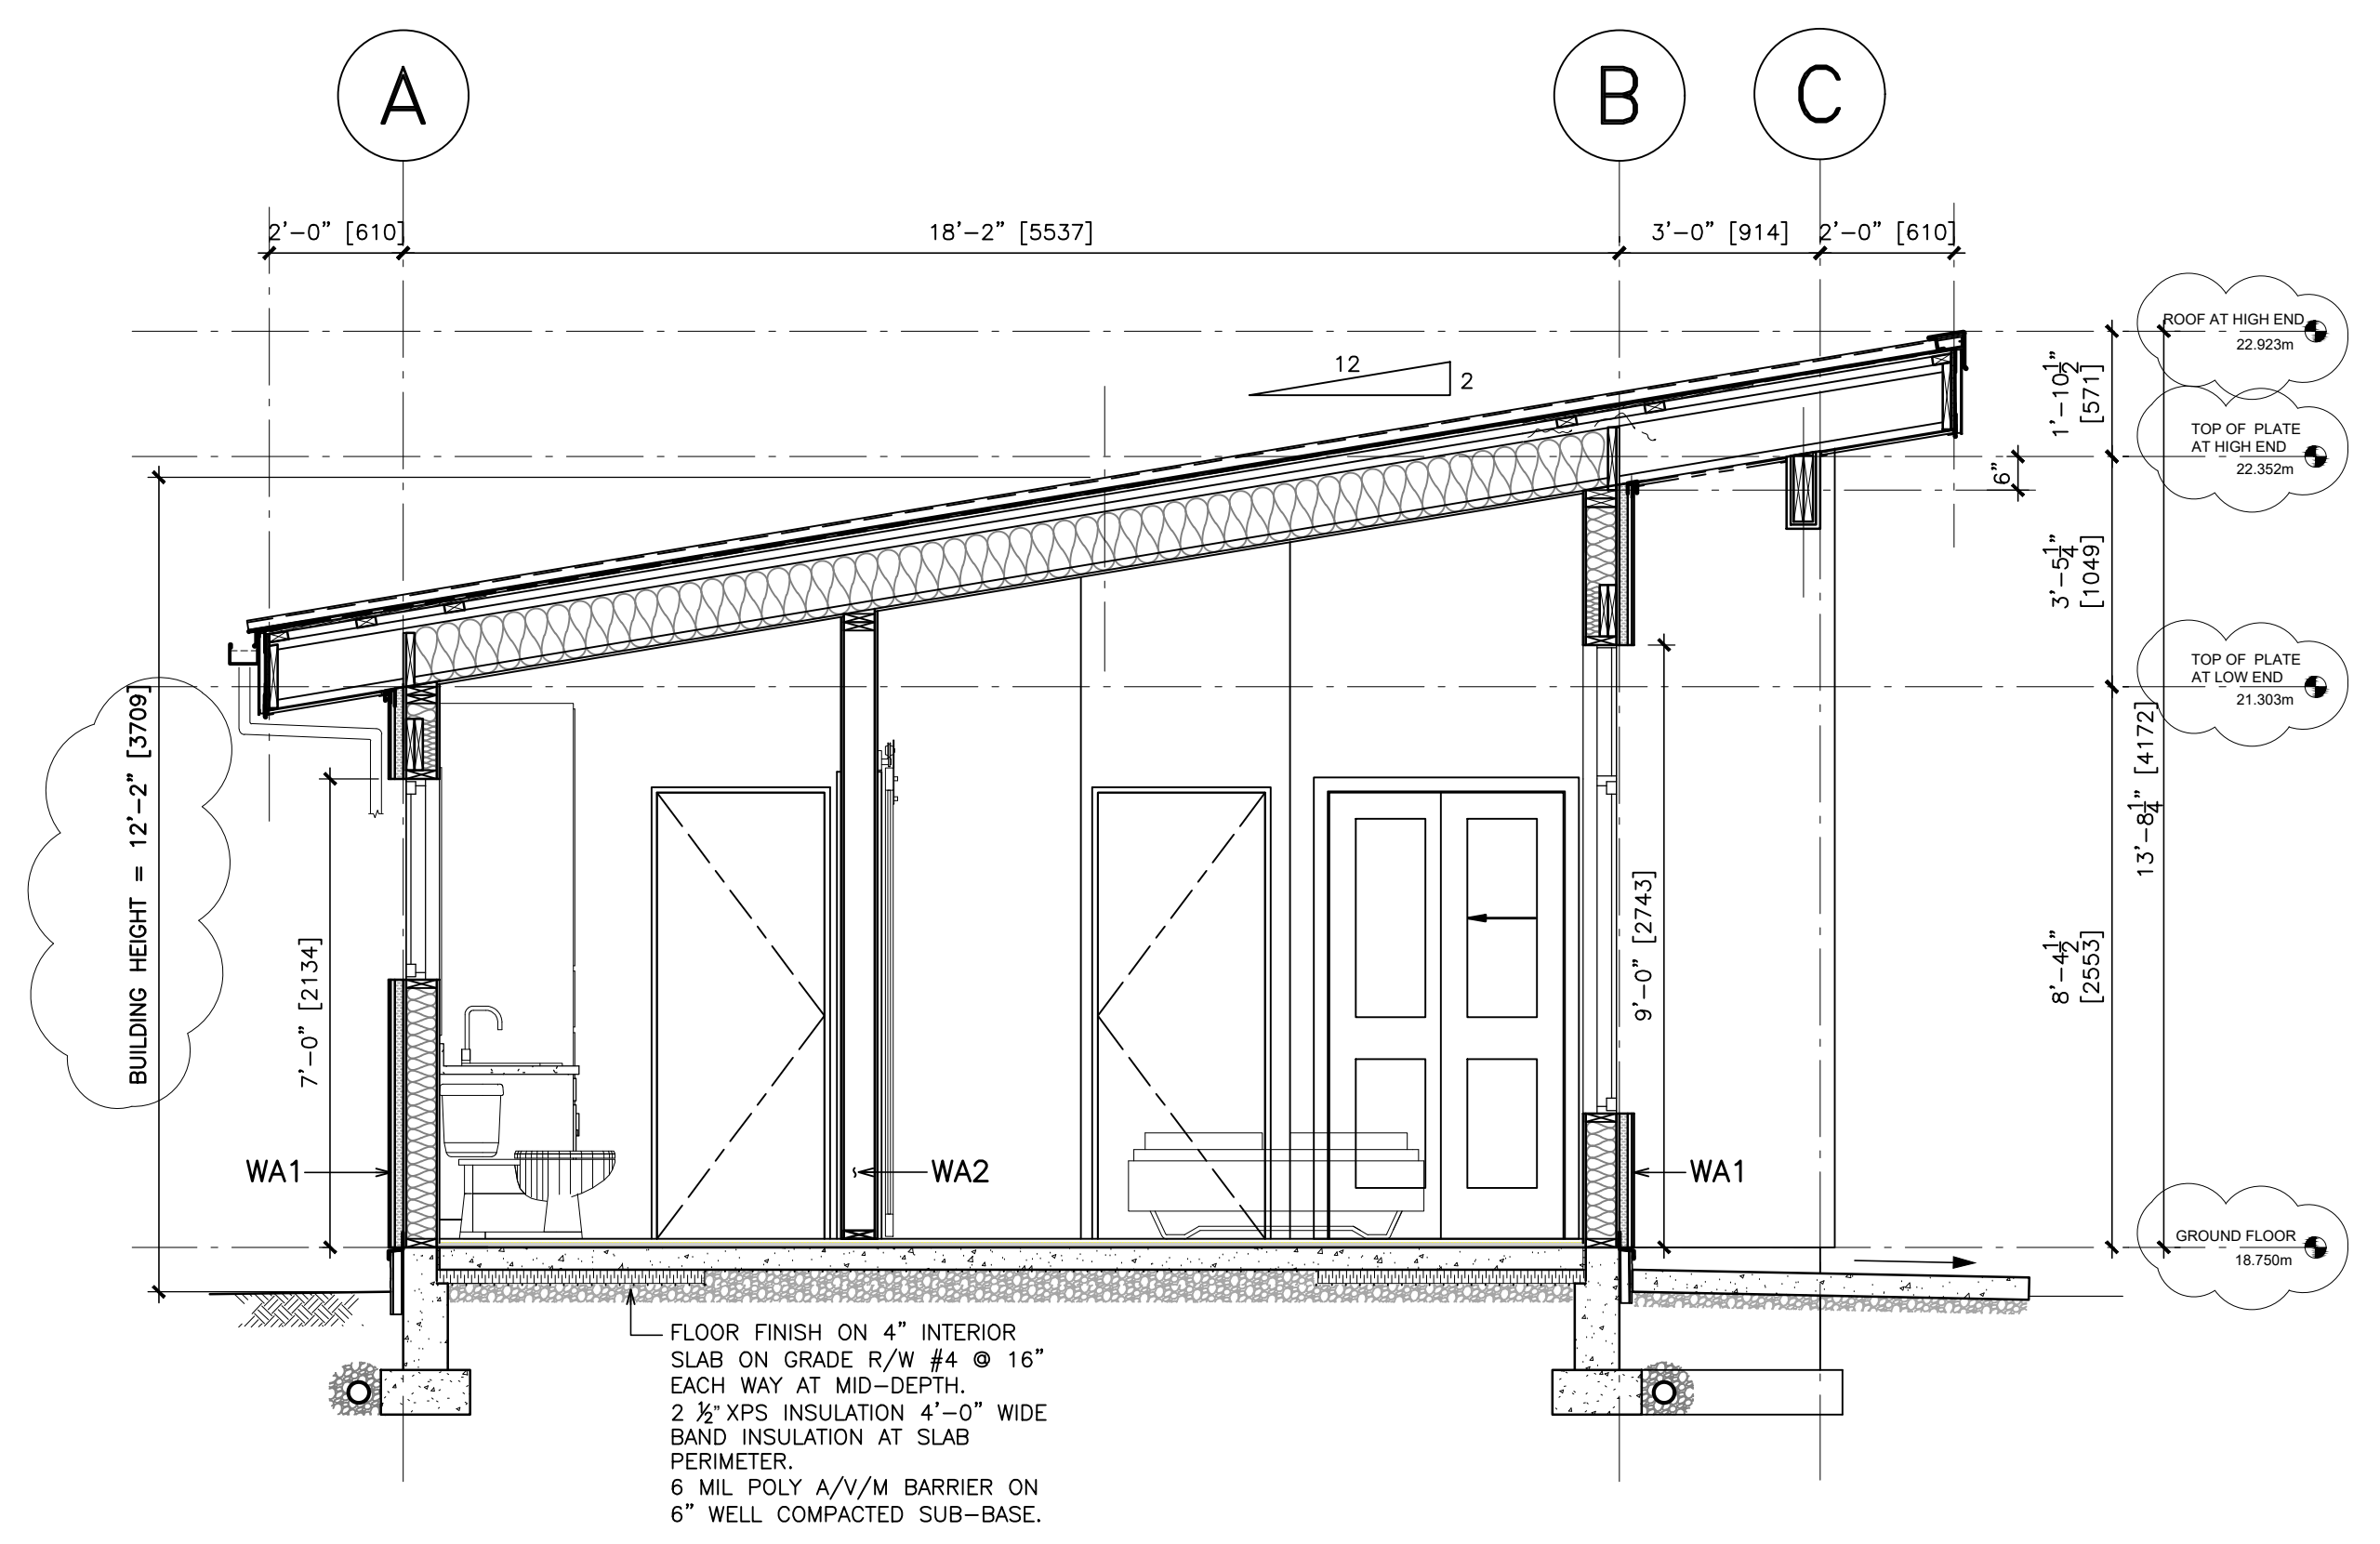

3	Issued for Variance Application	2023/09/05	LL
2	Re-issued for Delegated Development Permit	2023/06/29	LL
1	Delegated Development Permit	2022/10/3	LL
No.	Revision	Date	By

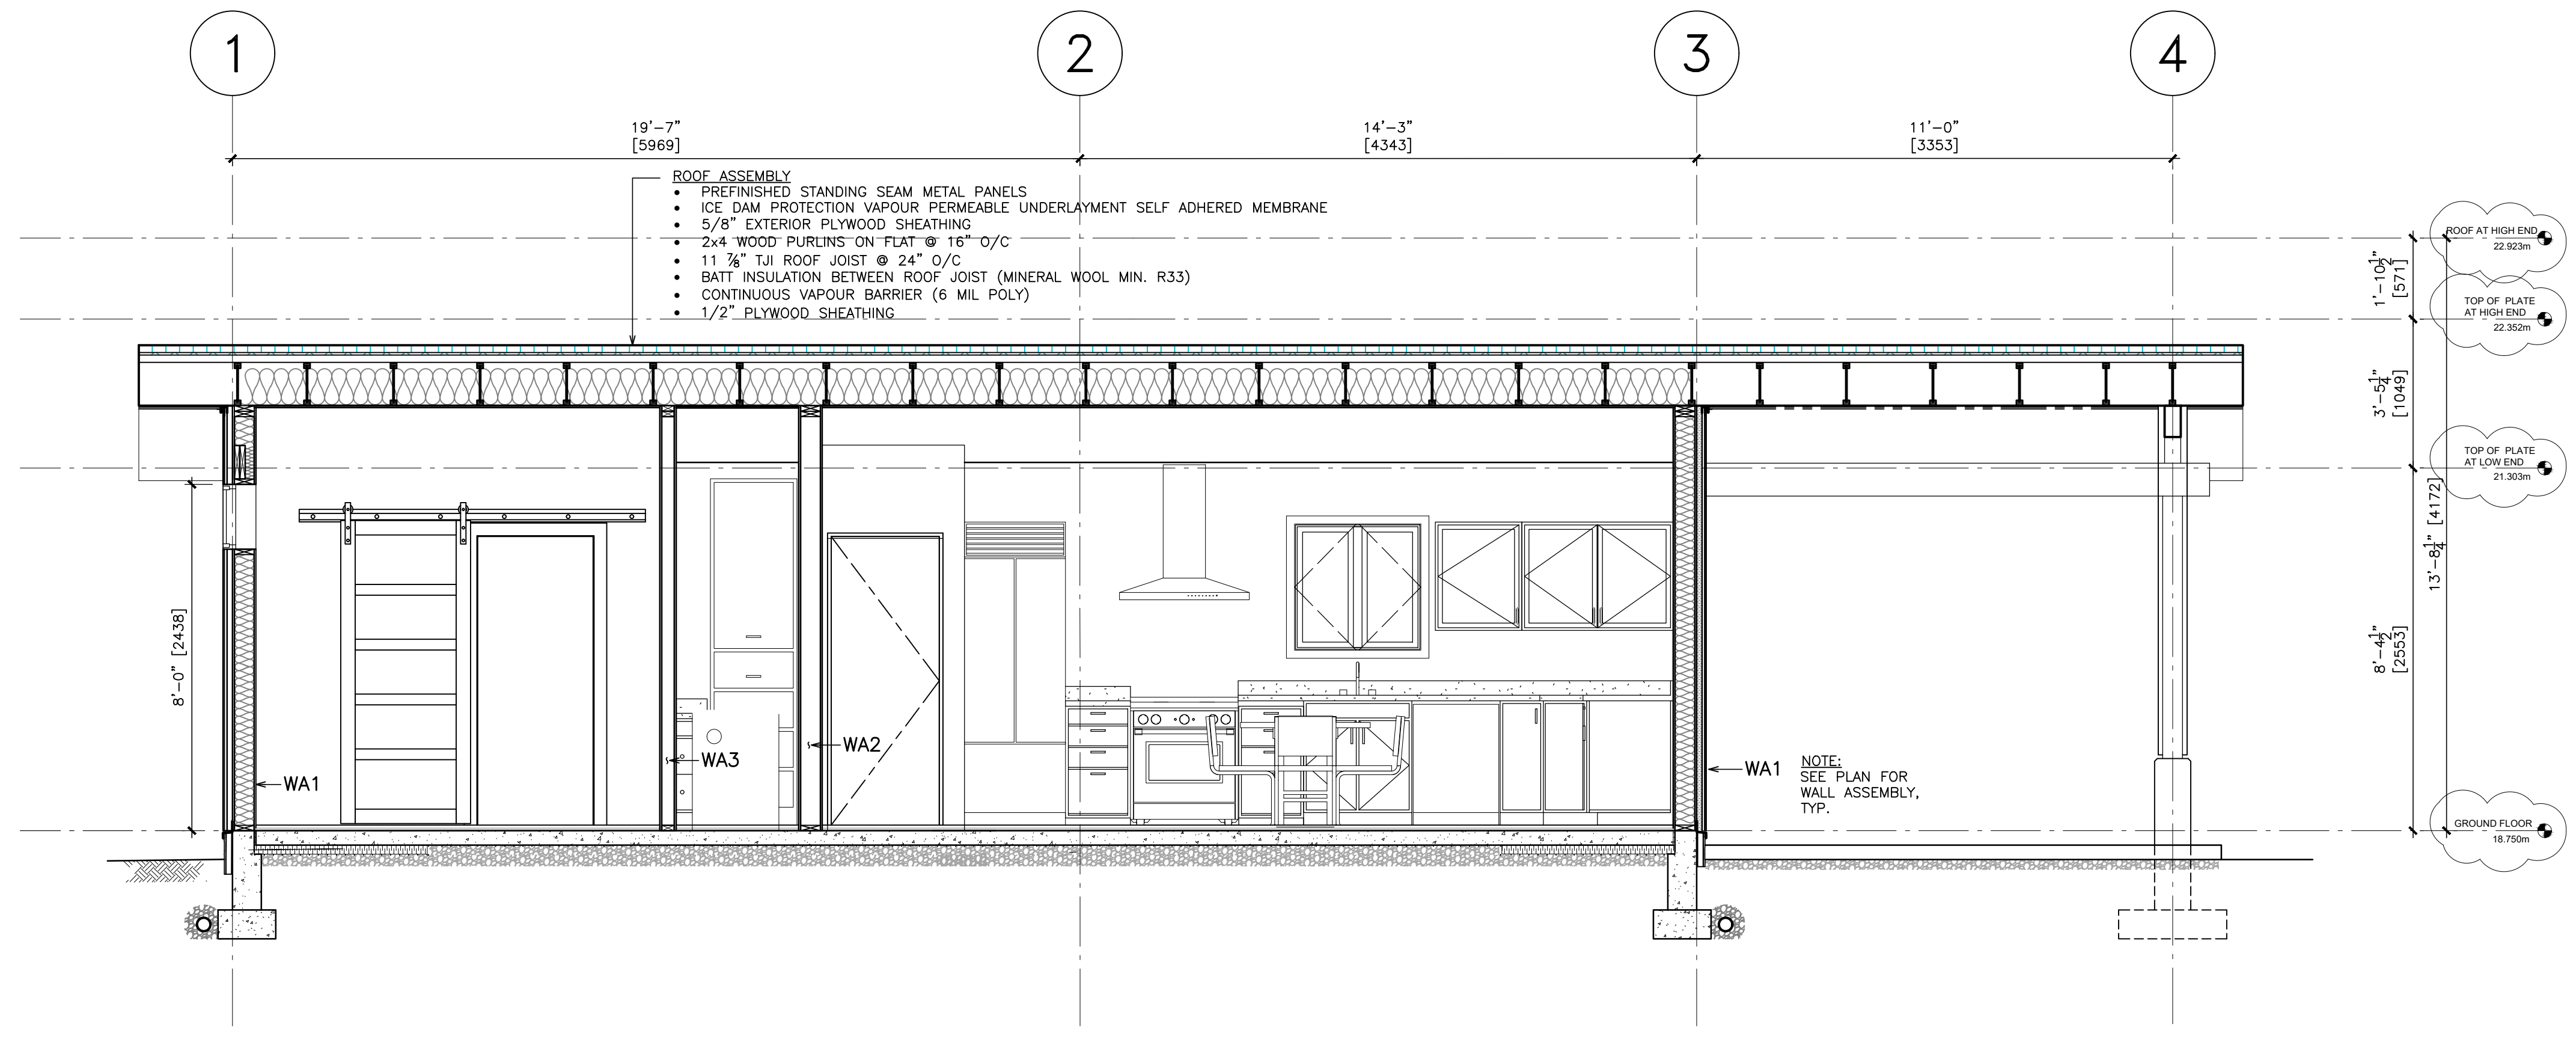

Project Name
READ RESIDENCE - GARDEN SUITE

965 COWICHAN STREET, VICTORIA BC


Sheet Title
BUILDING SECTIONS

Drawn By LL Scale AS SHOWN
 Designed By LL Date AUGUST 5, 2023
 Project Number 100
 Sheet Number Revision
A4.1


Drawing Notes

All drawings, plans, models, designs, specifications and other documents prepared by Lane Design and used in connection with this project are instruments of service for the work shown in them (the "Work") and as such are and remain the property of Lane Design whether the Work is executed or not, and Lane Design reserves the copyright in them and in the Work executed from them, and they shall not be used for any other work or project.


The general contractor is responsible for confirming and correlating dimensions at the job site. The designer will not be responsible for construction means, methods, techniques, sequences or procedures, or safety precautions and programs in connection with the project.

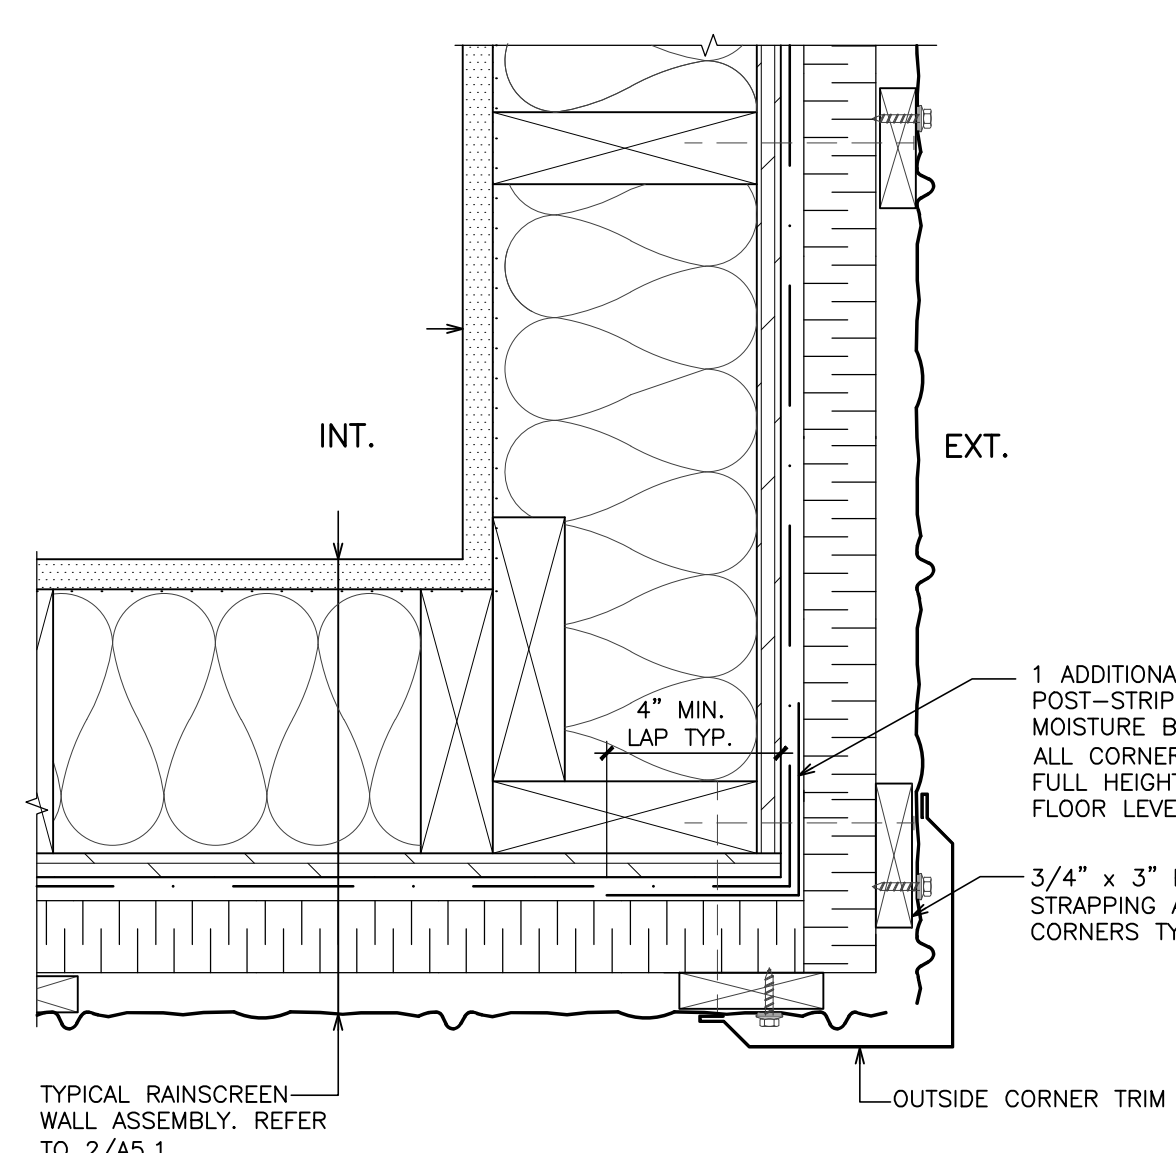


4 WALL AT OUTSIDE CORNER - PLAN
A5.1 3" = 1'-0"

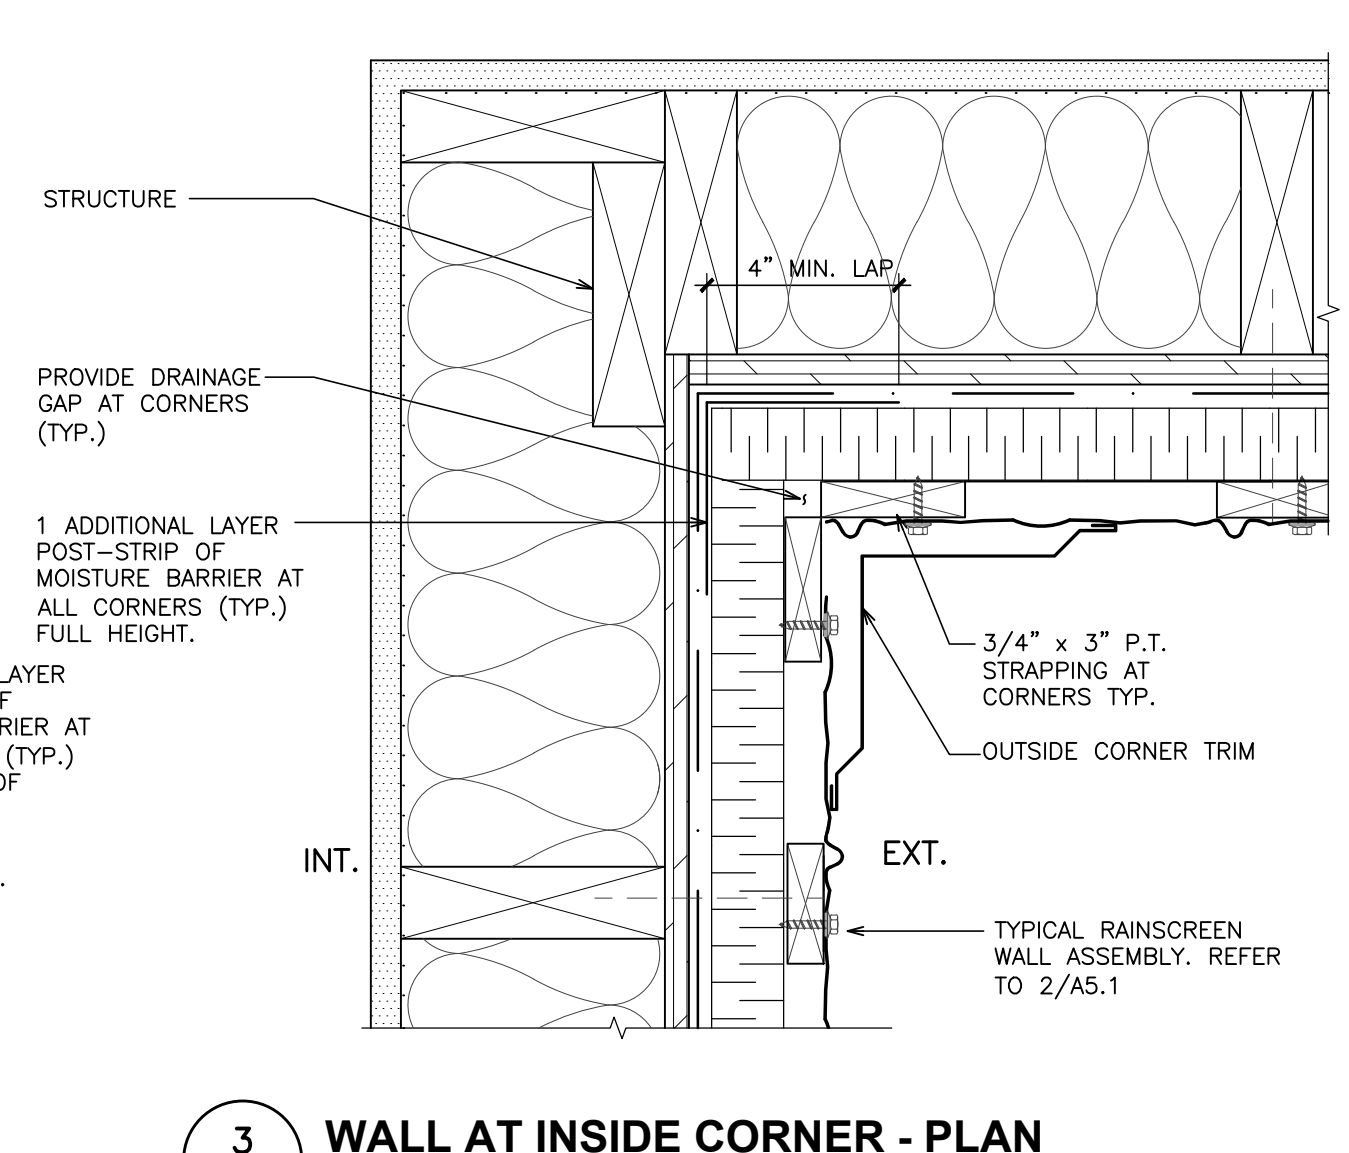


3 WALL AT INSIDE CORNER - PLAN
A5.1 3" = 1'-0"

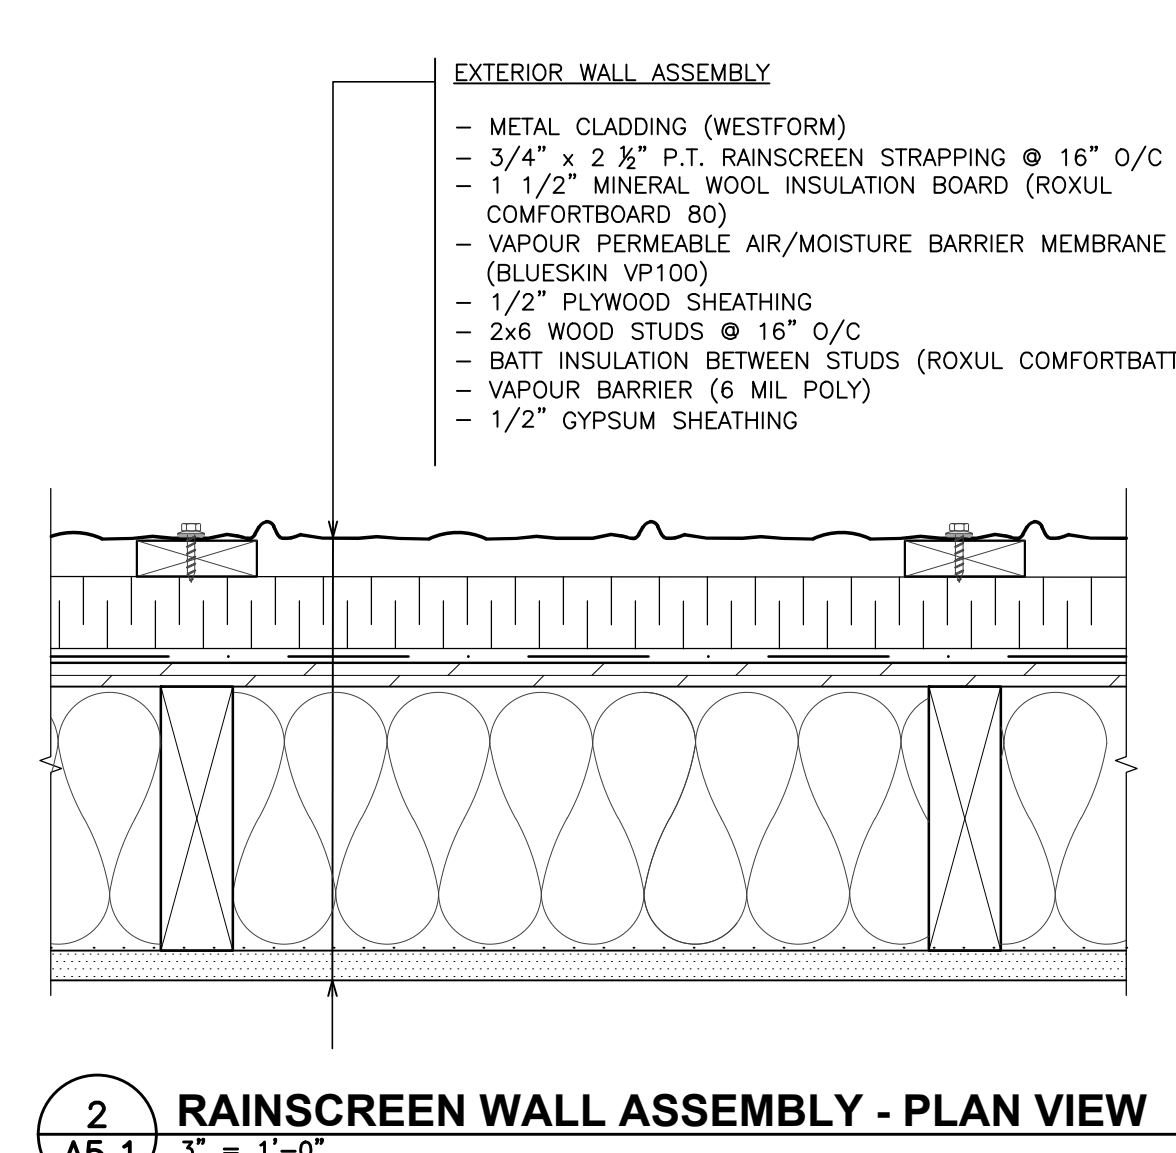


2 RAINSCREEN WALL ASSEMBLY - PLAN VIEW
A5.1 3" = 1'-0"

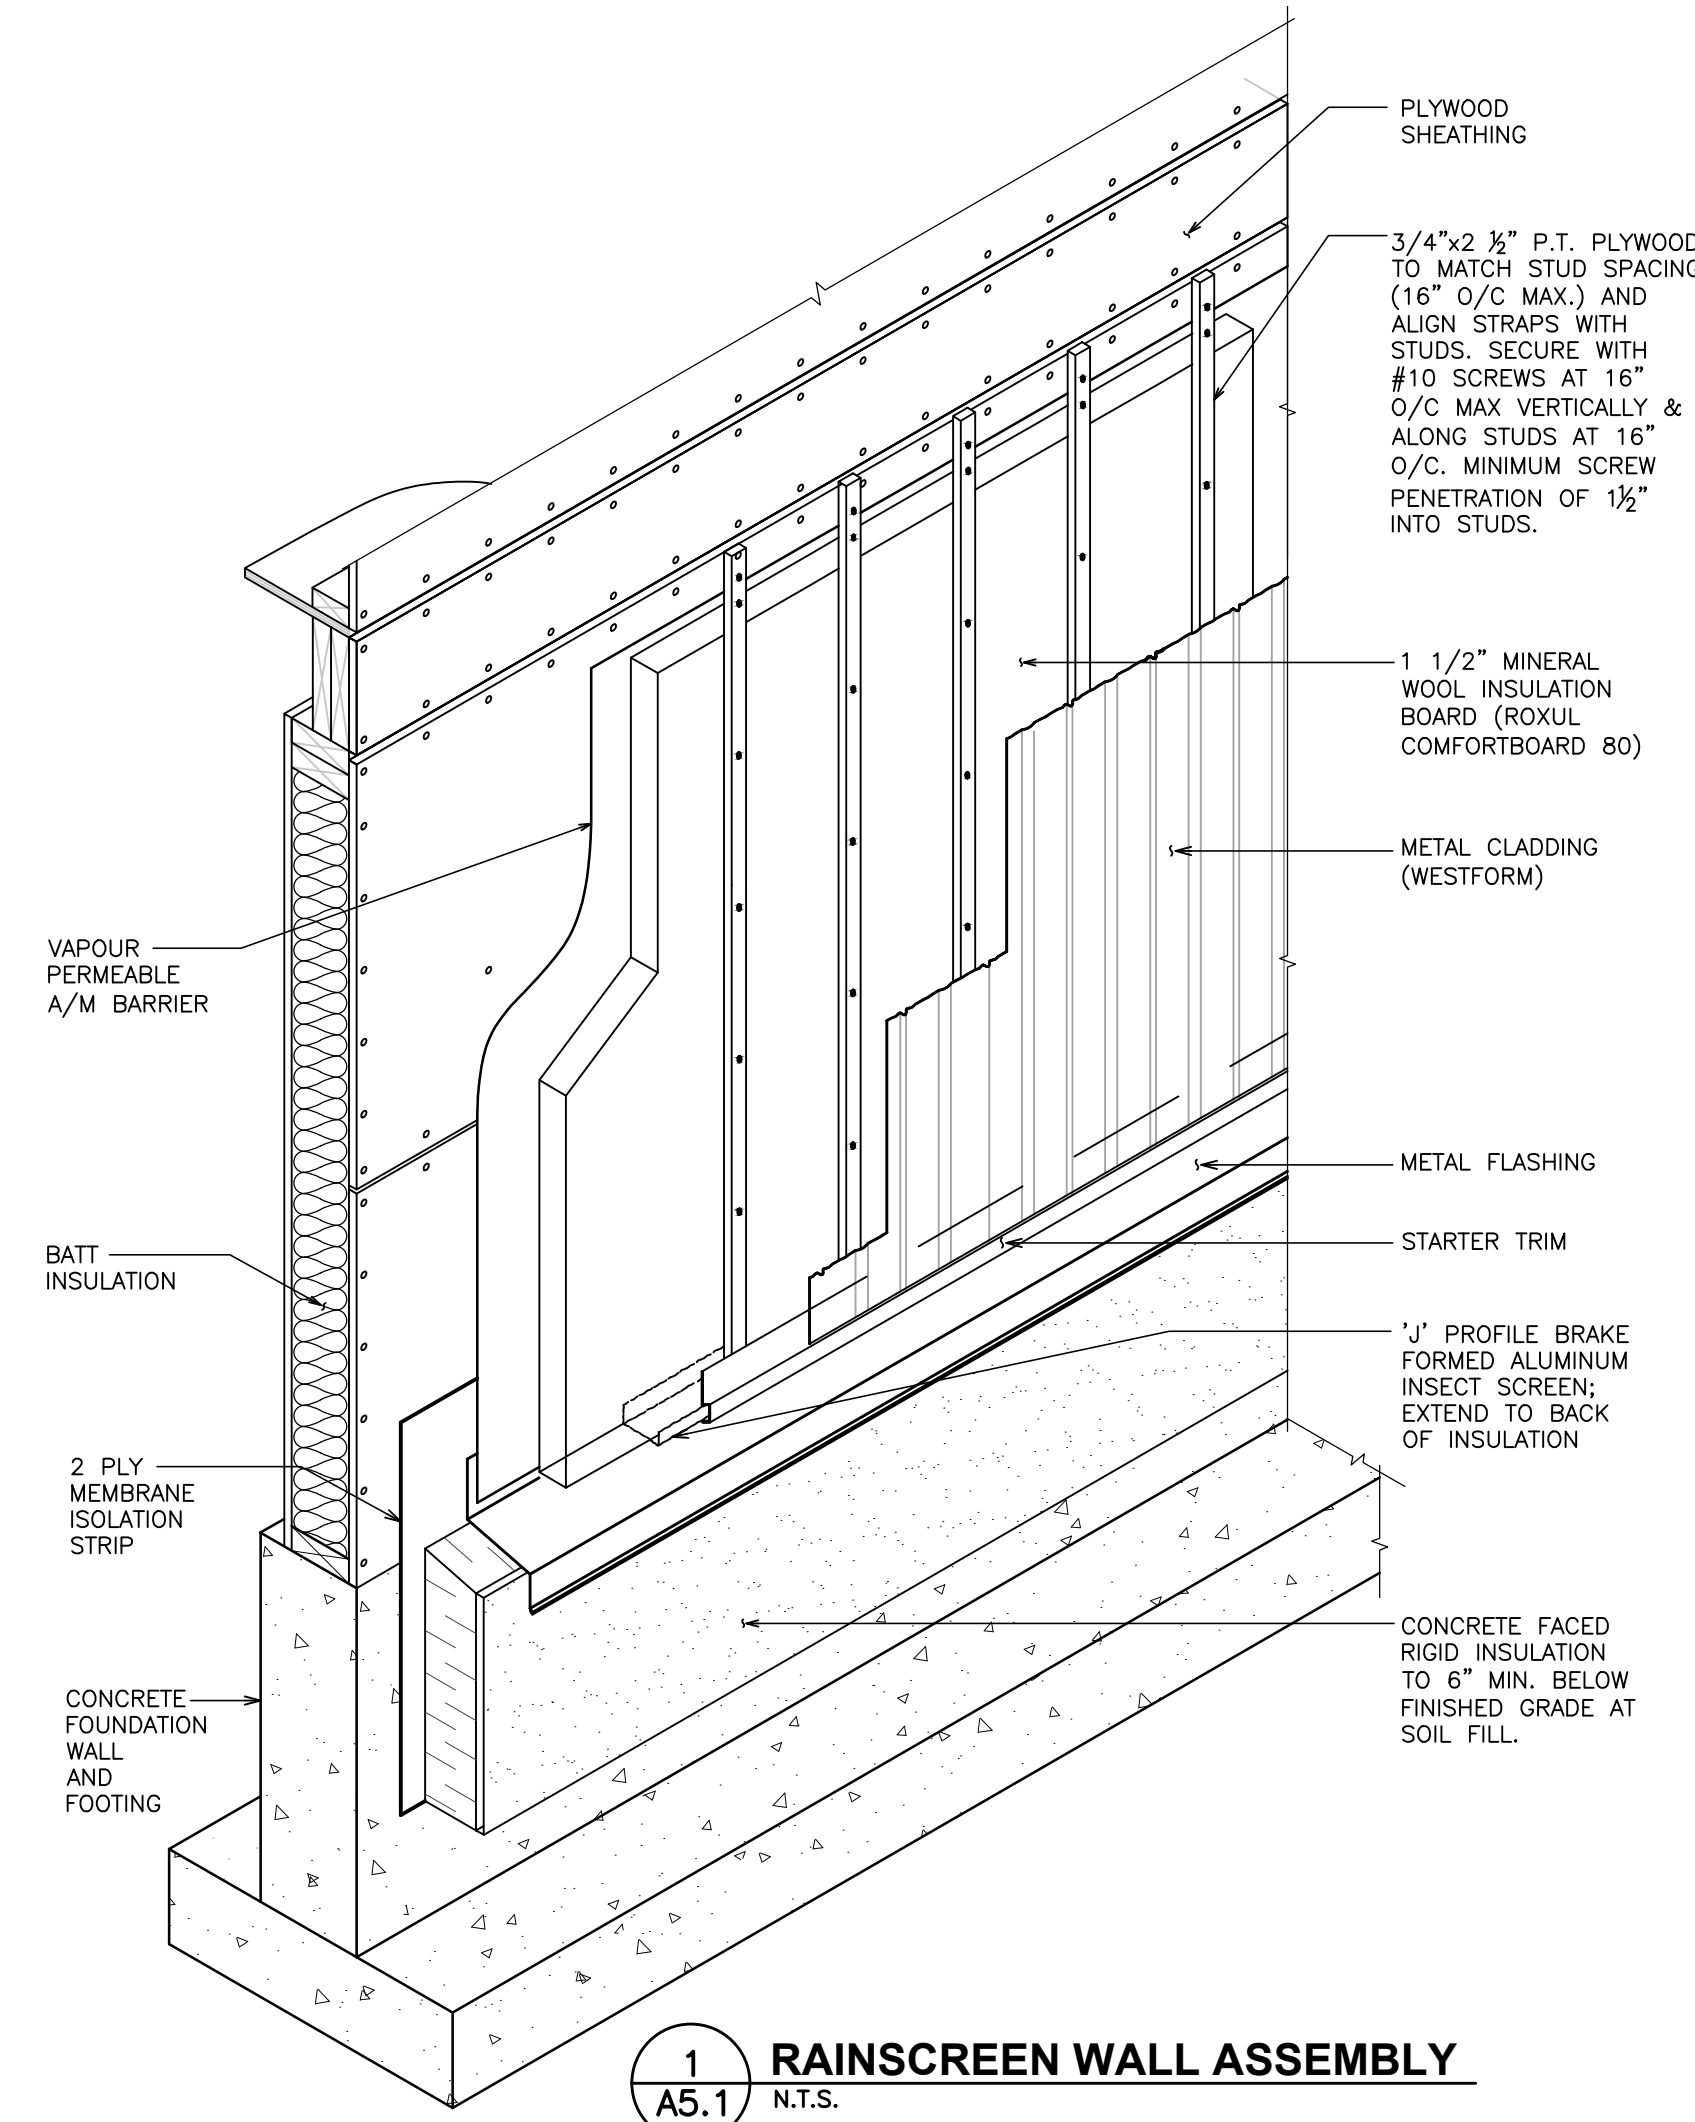


1 RAINSCREEN WALL ASSEMBLY
A5.1 N.T.S.

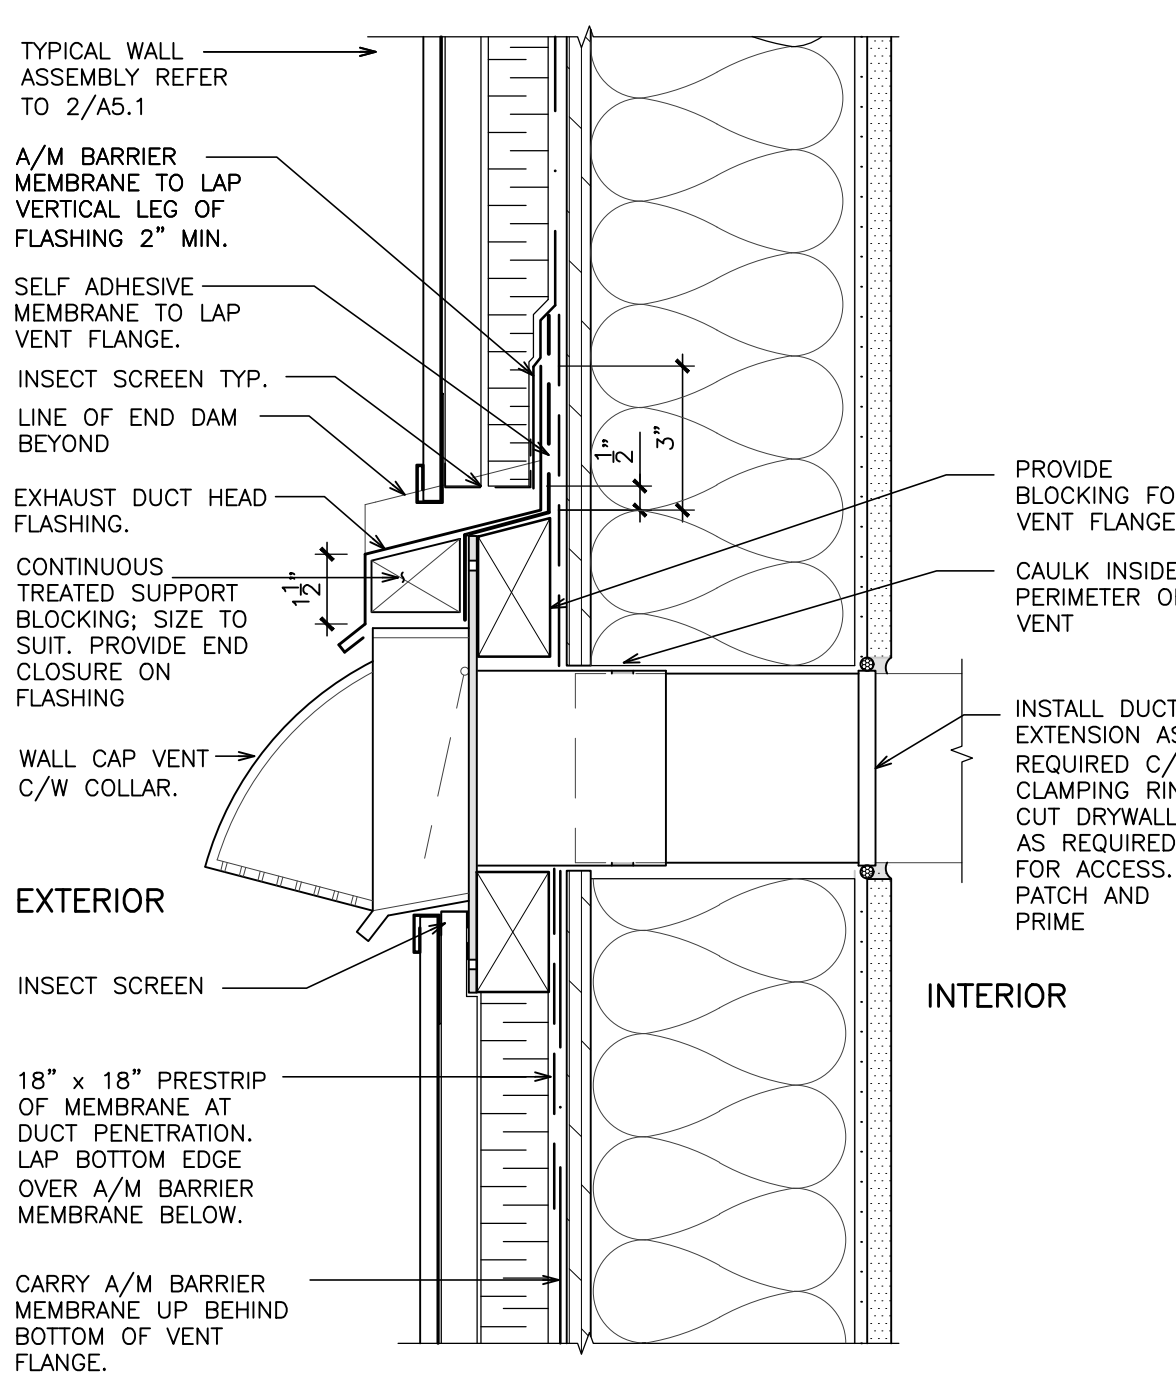


7 TYPICAL WALL VENT PENETRATION
A5.1 3" = 1'-0"

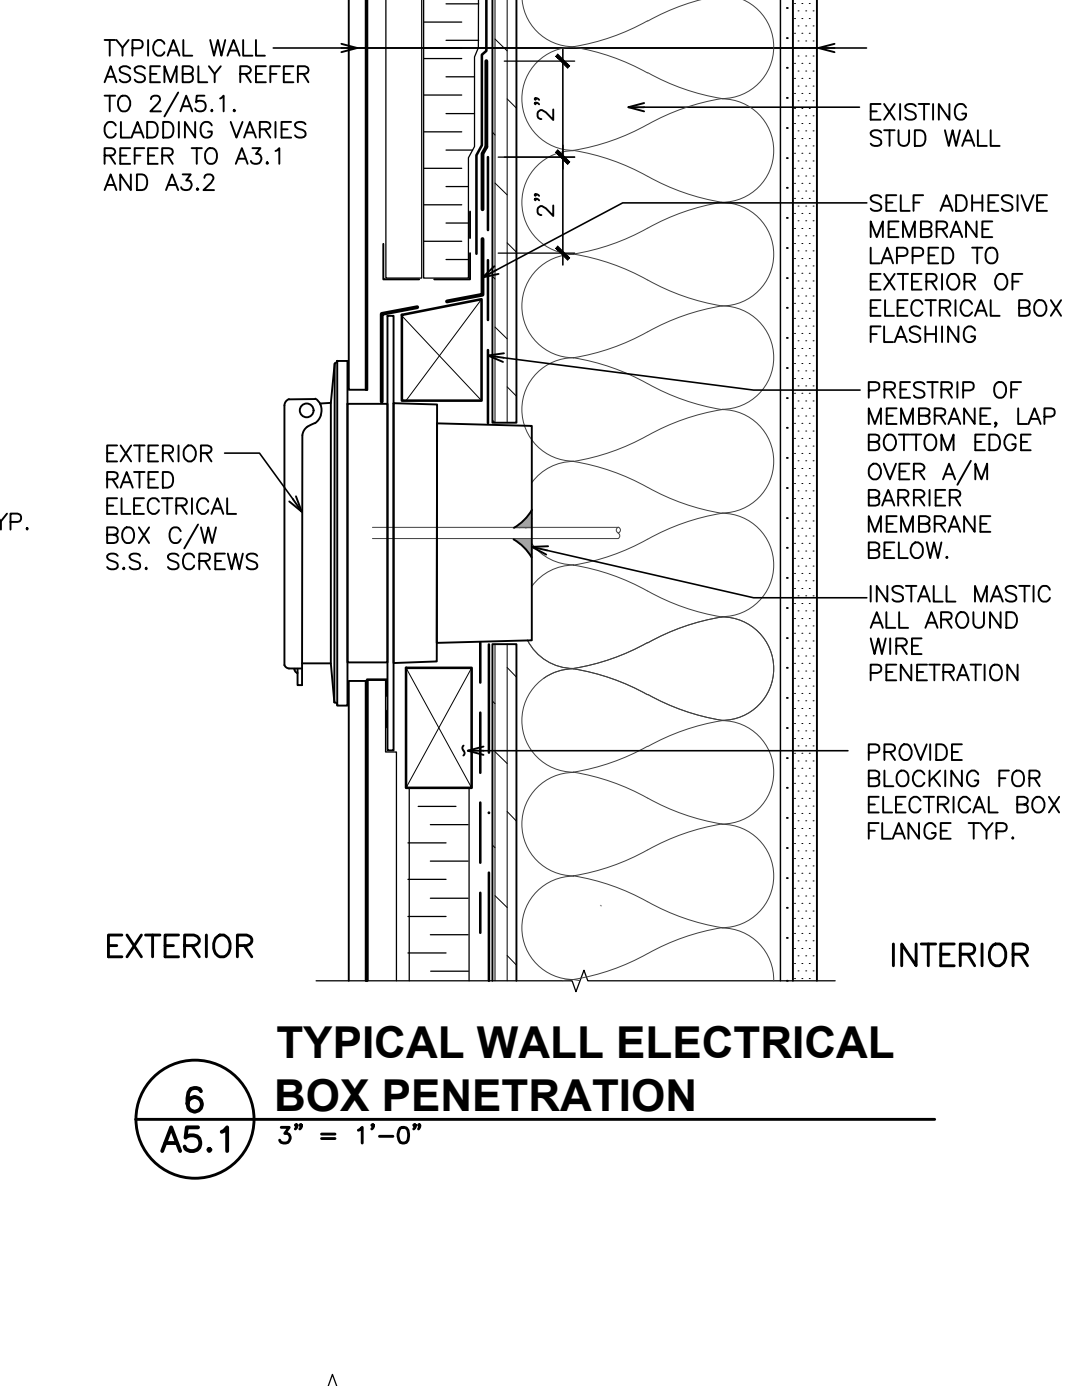

6 TYPICAL WALL ELECTRICAL BOX PENETRATION
A5.1 3" = 1'-0"

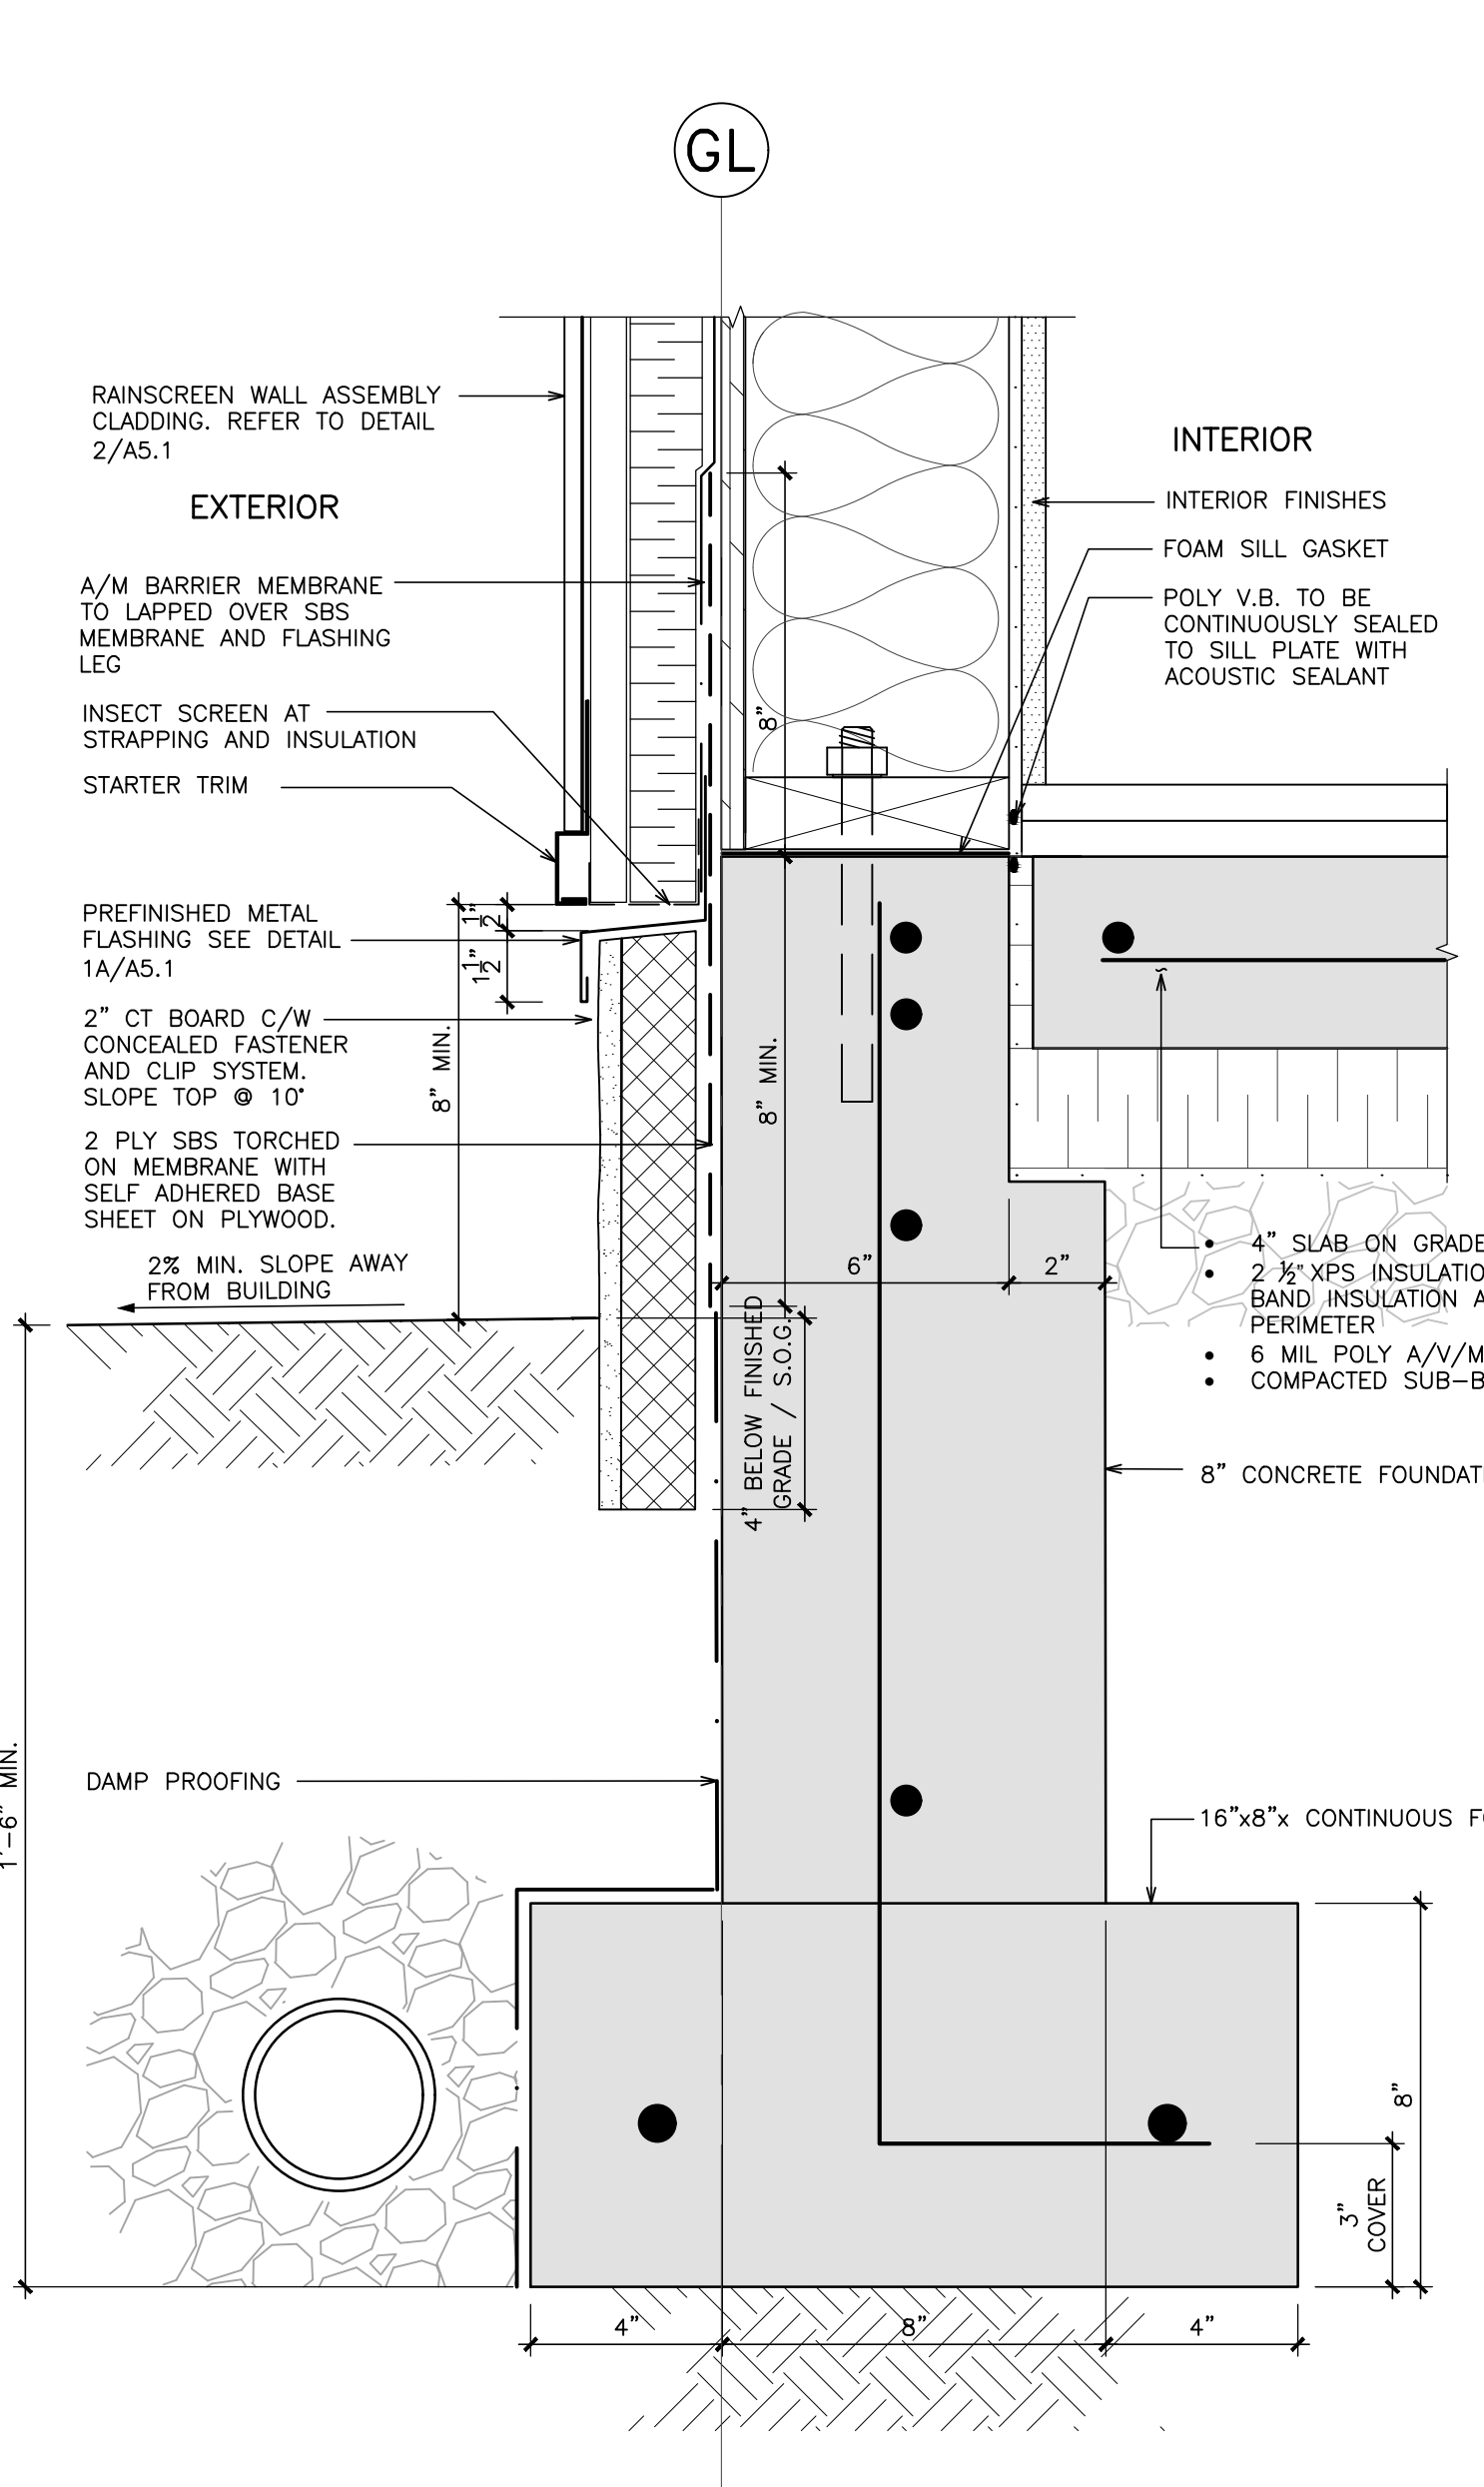

5 BASE OF WALL
A5.1 3" = 1'-0"

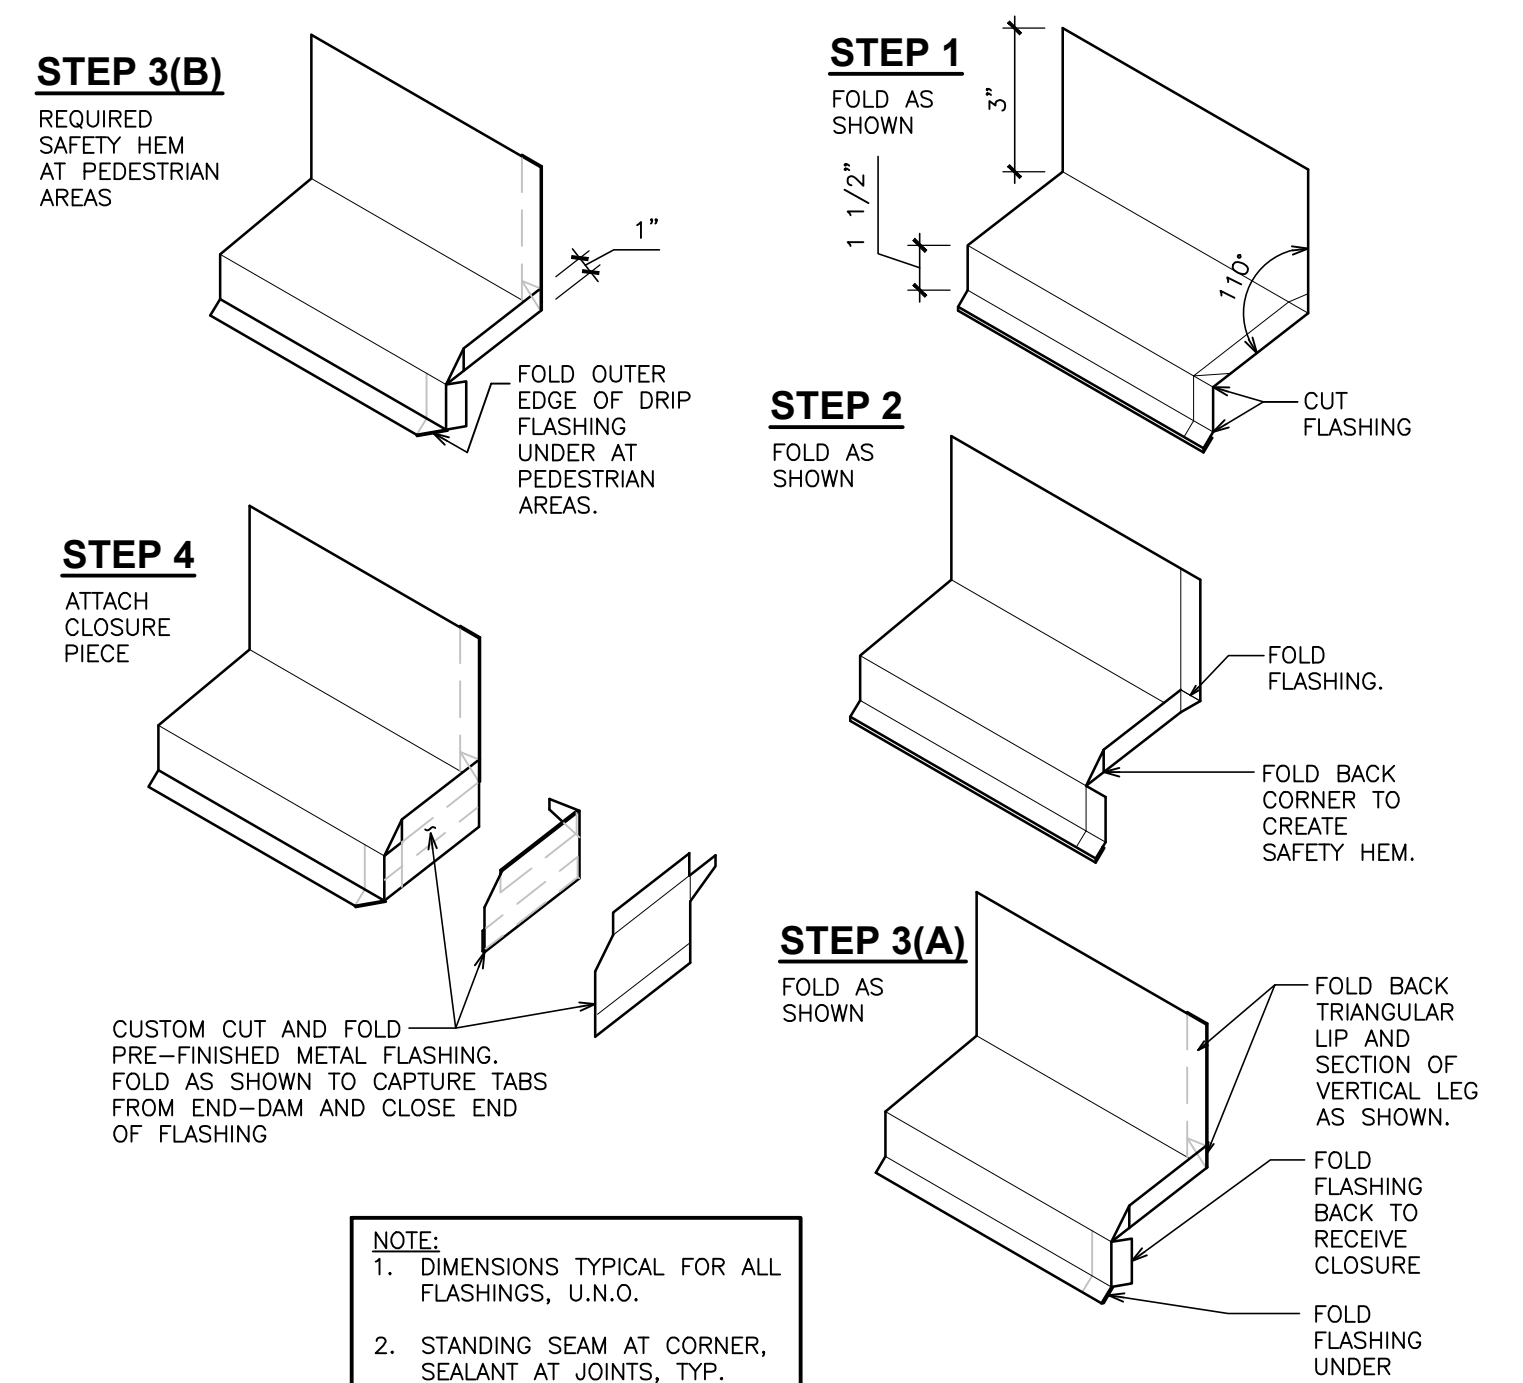

1A TYPICAL FLASHING END DAM FORMATION
A5.1 N.T.S.

No.	Revision	Date	By
3	Issued for Variance Application	2023/09/05	LL
2	Re-issued for Delegated Development Permit	2023/06/29	LL
1	Delegated Development Permit	2022/10/3	LL

Project Name
READ RESIDENCE - GARDEN SUITE

965 COWICHAN STREET, VICTORIA BC

Sheet Title
DETAILS

Drawn By **LL** Scale **AS SHOWN**

Designed By **LL** Date **AUGUST 5, 2023**



Project Number **100**

Sheet Number **A5.1** Revision

Drawing Notes

All drawings, plans, models, designs, specifications and other documents prepared by Lane Design and used in connection with this project are instruments of service for the work shown in them (the "Work") and as such are and remain the property of Lane Design whether the Work is executed or not, and Lane Design reserves the copyright in them and in the Work executed from them, and they shall not be used for any other work or project.



The general contractor is responsible for confirming and correlating dimensions at the job site. The designer will not be responsible for construction means, methods, techniques, sequences or procedures, or safety precautions and programs in connection with the project.

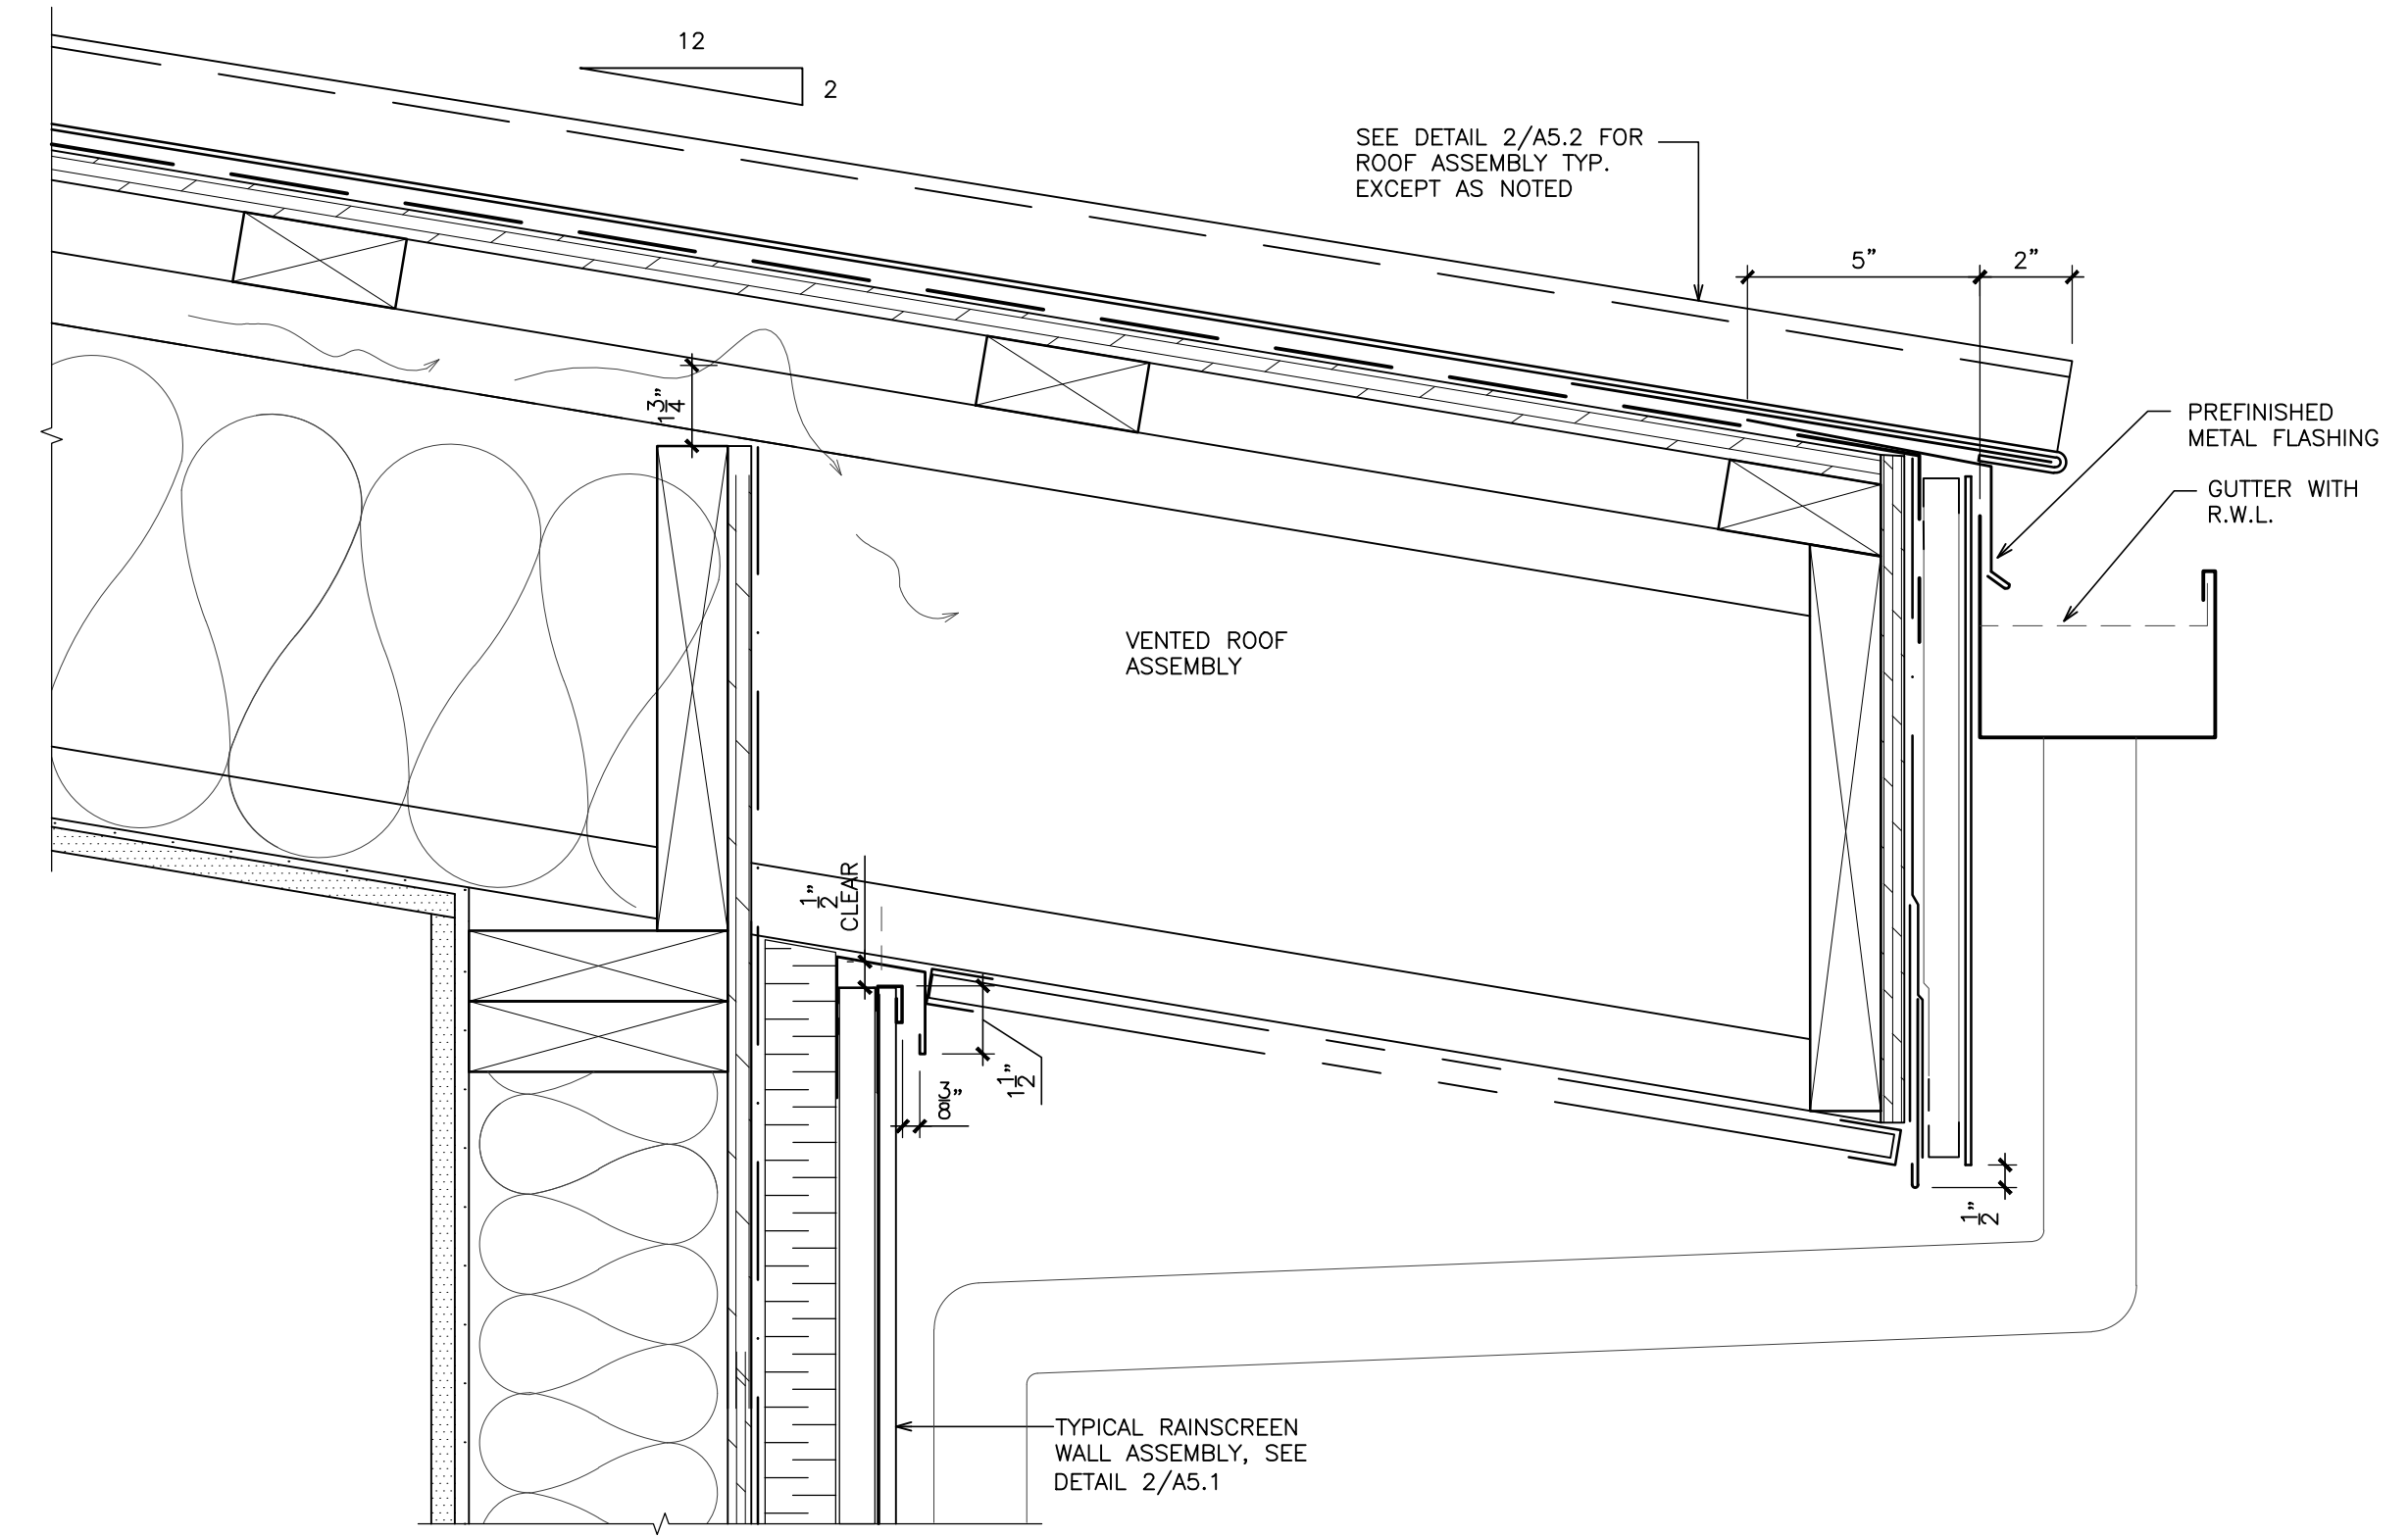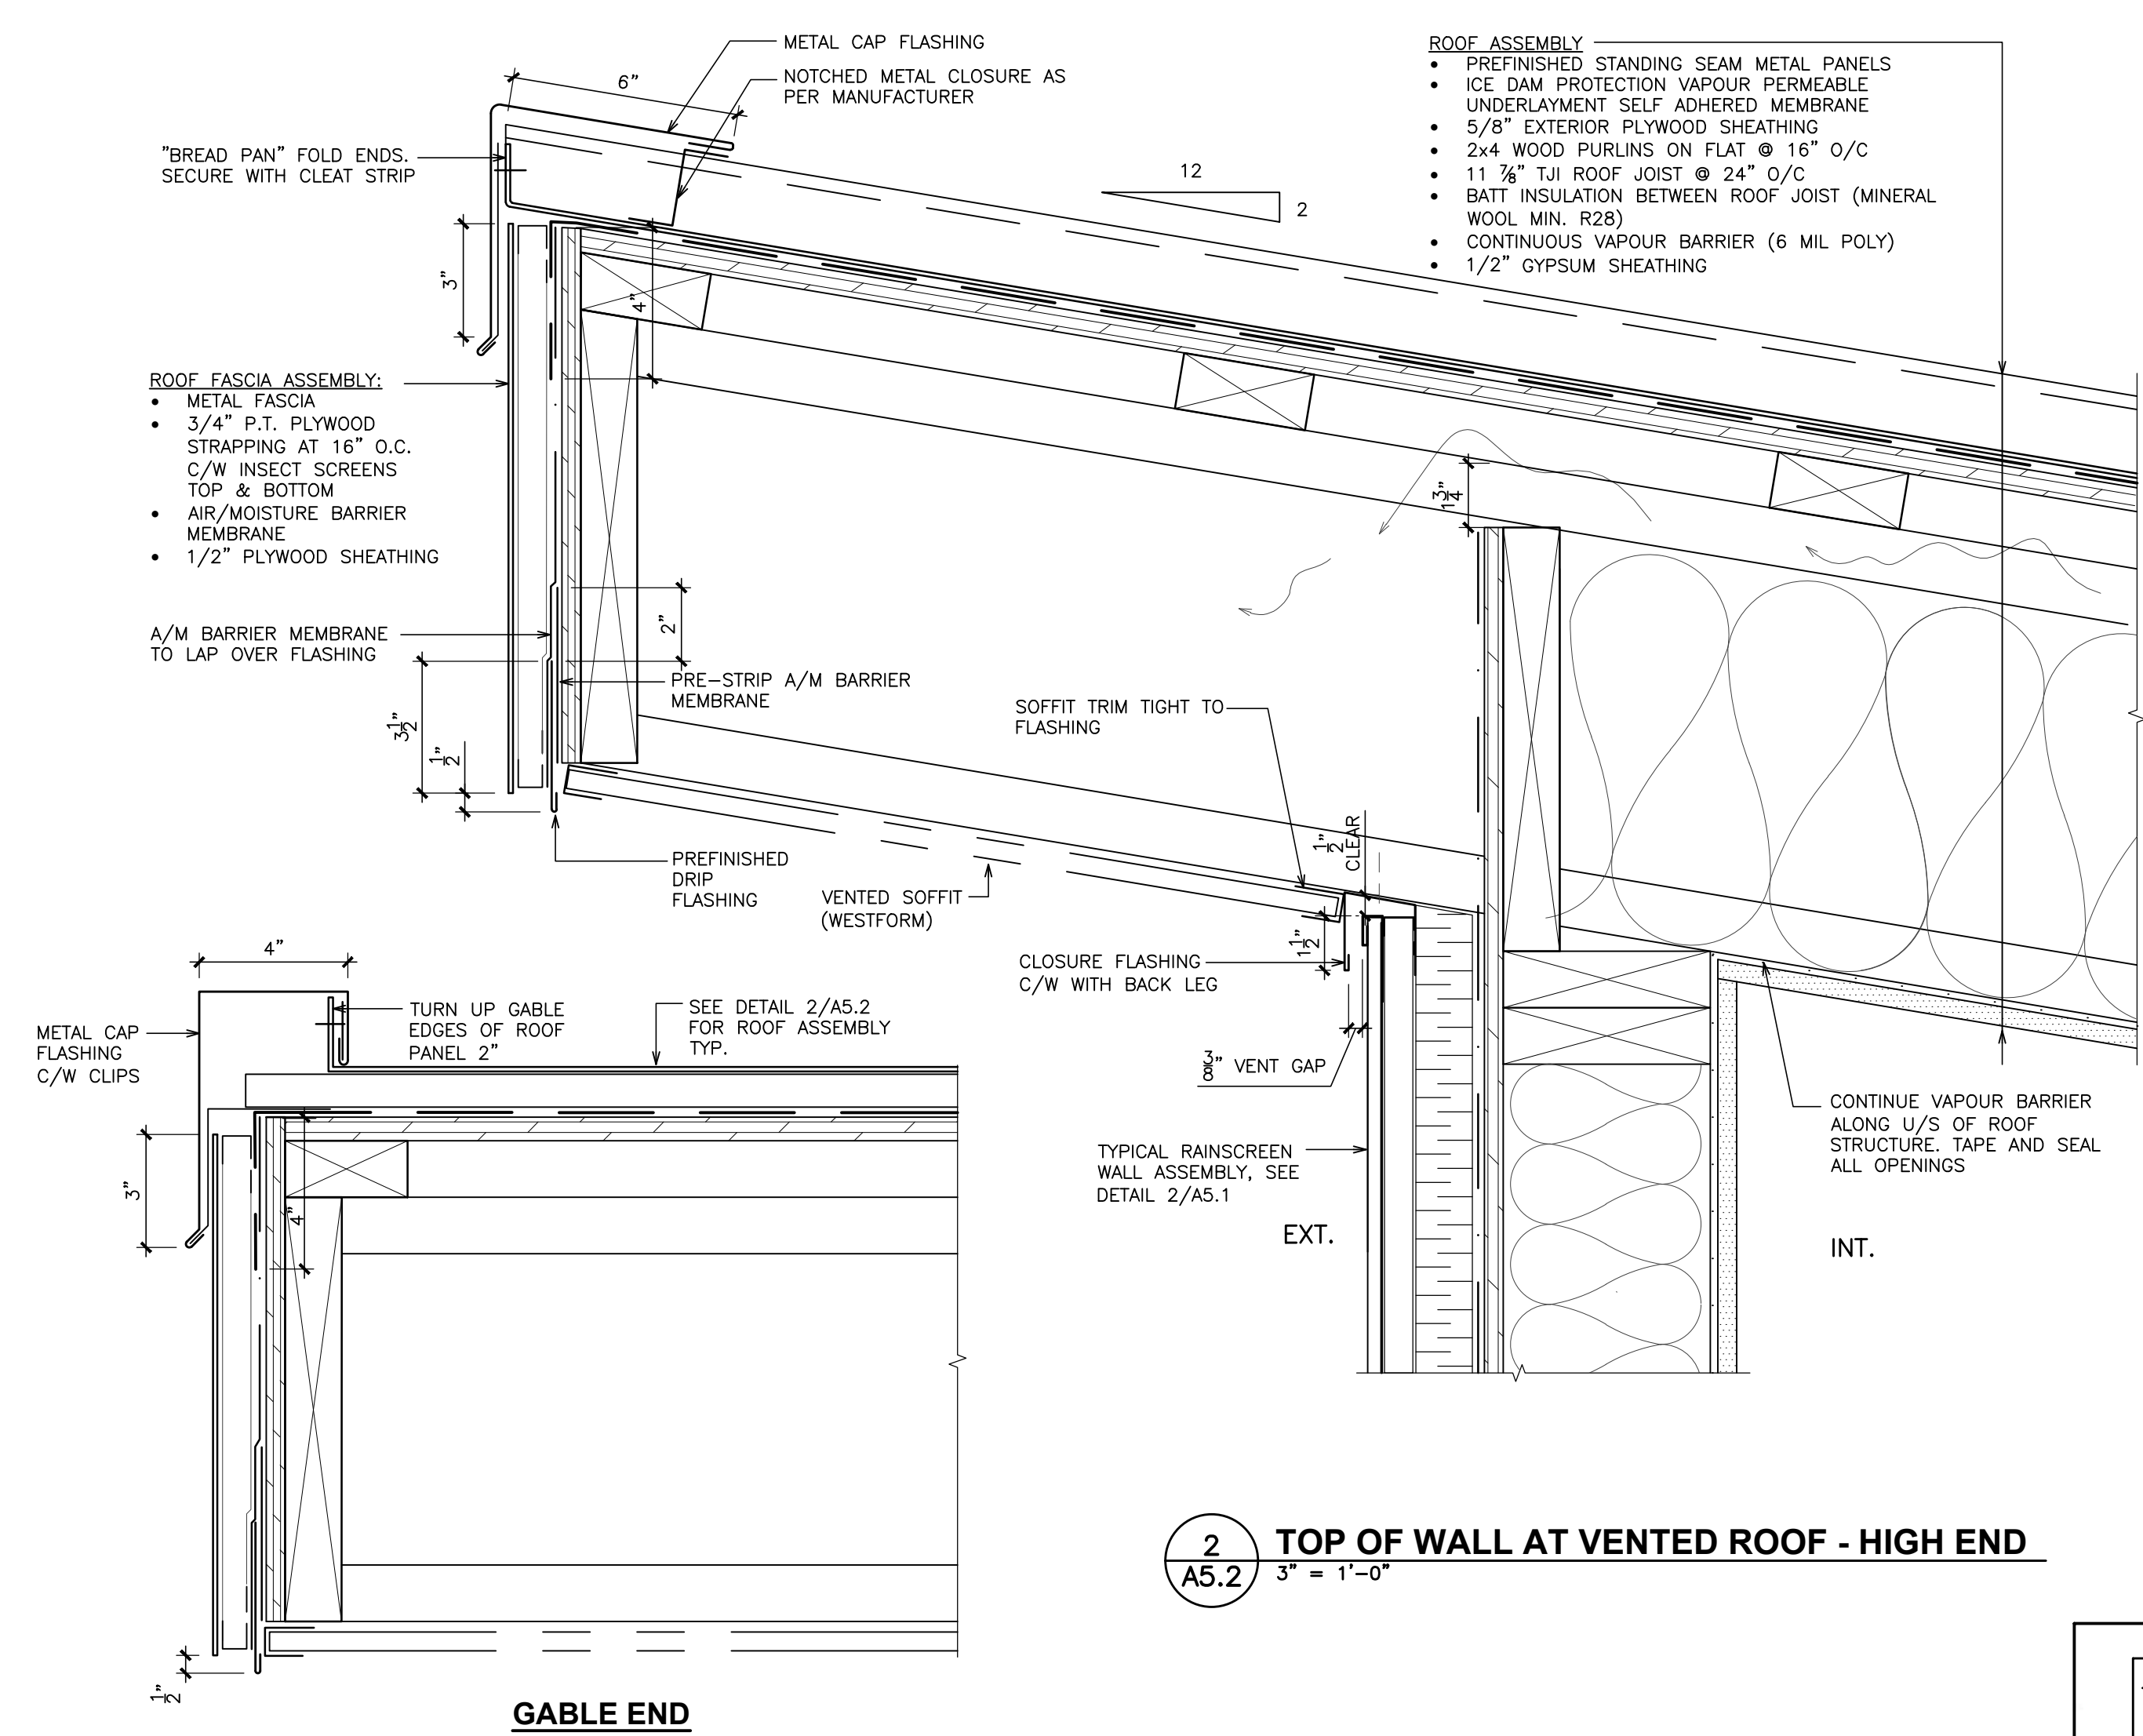


1 TOP OF WALL AT VENTED ROOF - LOW END
3" = 1'-0"

2 TOP OF WALL AT VENTED ROOF - HIGH END
3" = 1'-0"

GABLE END

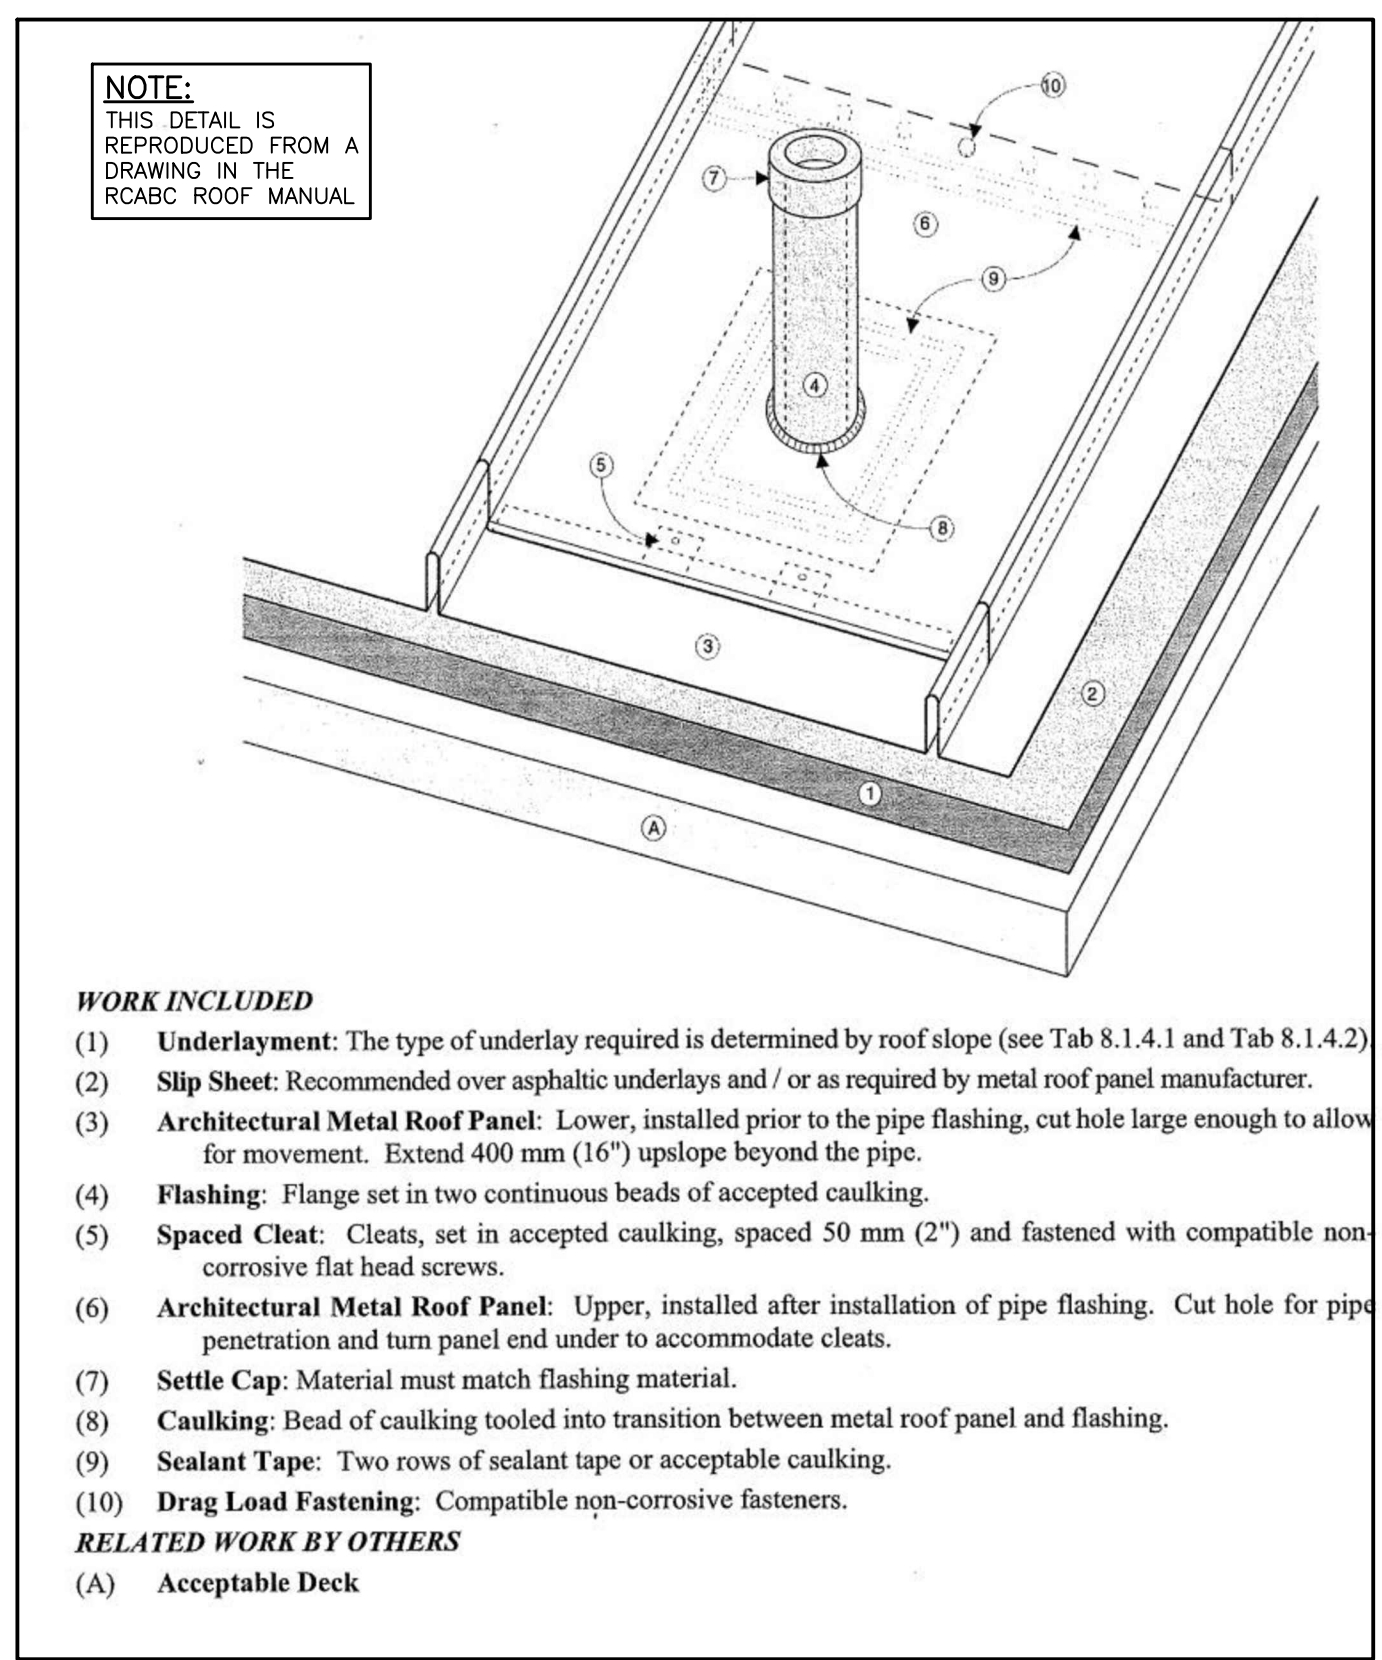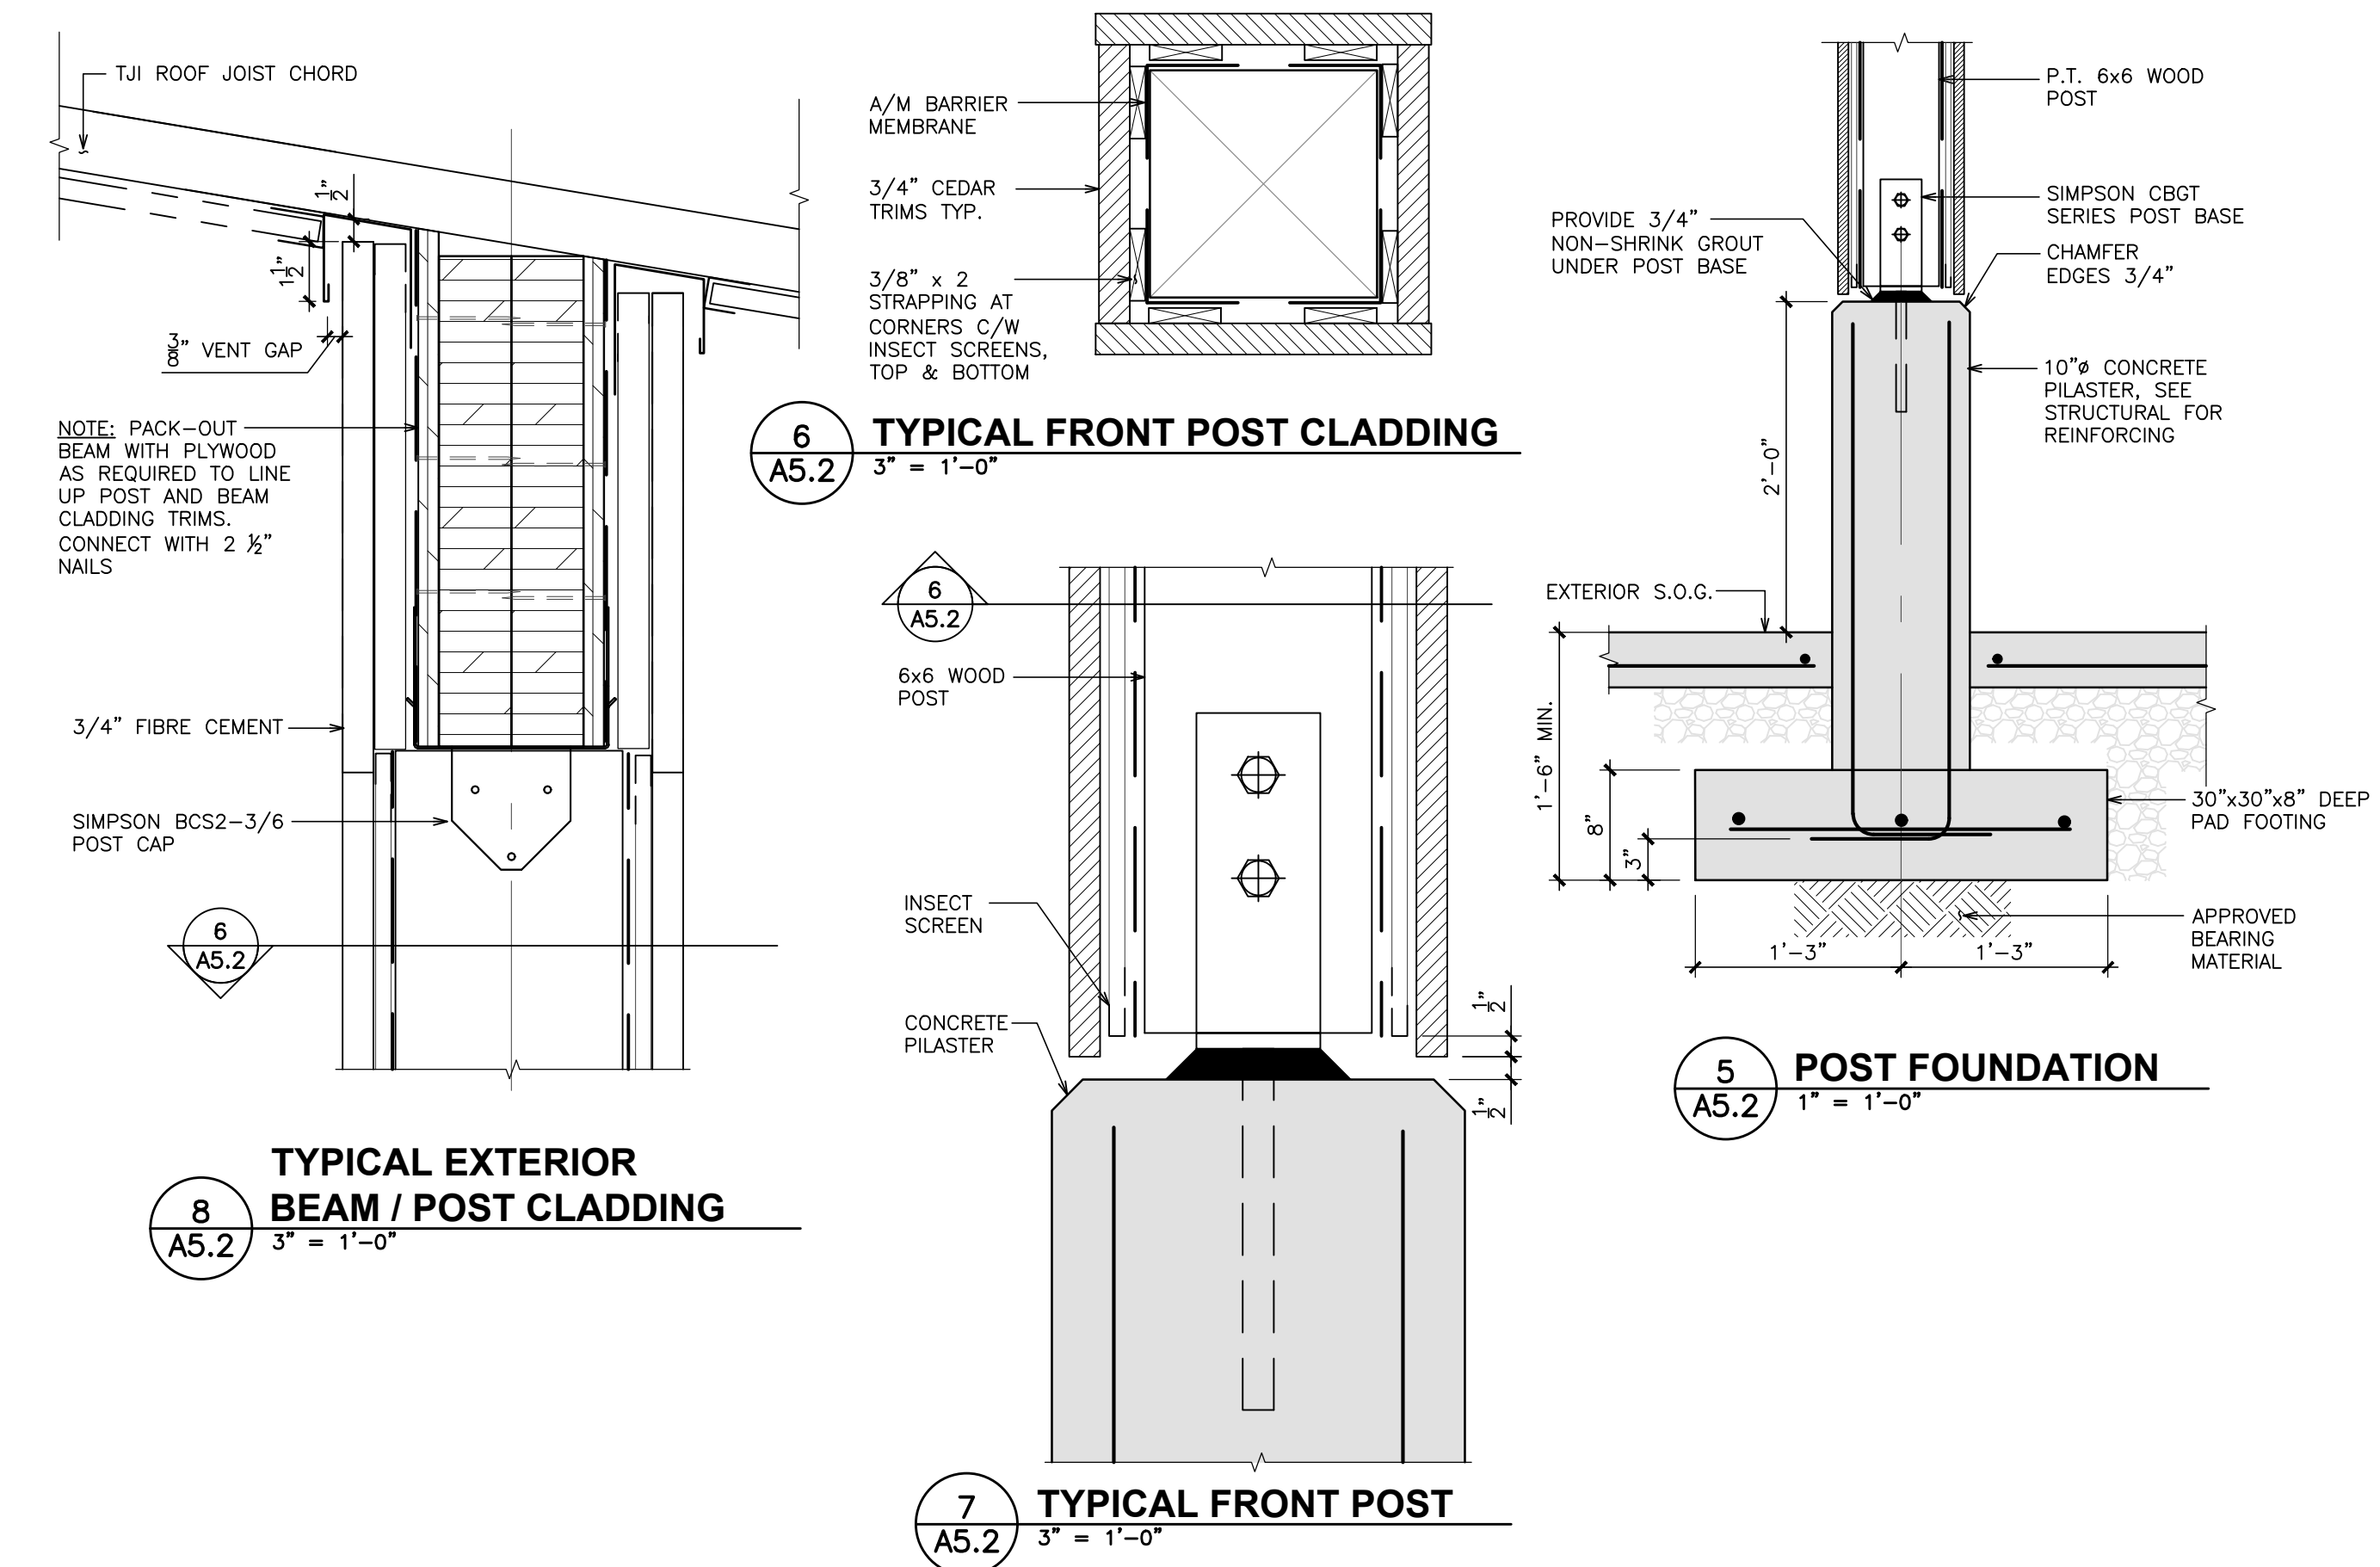

4 PIPE PENETRATION THROUGH ROOF
N.T.S.

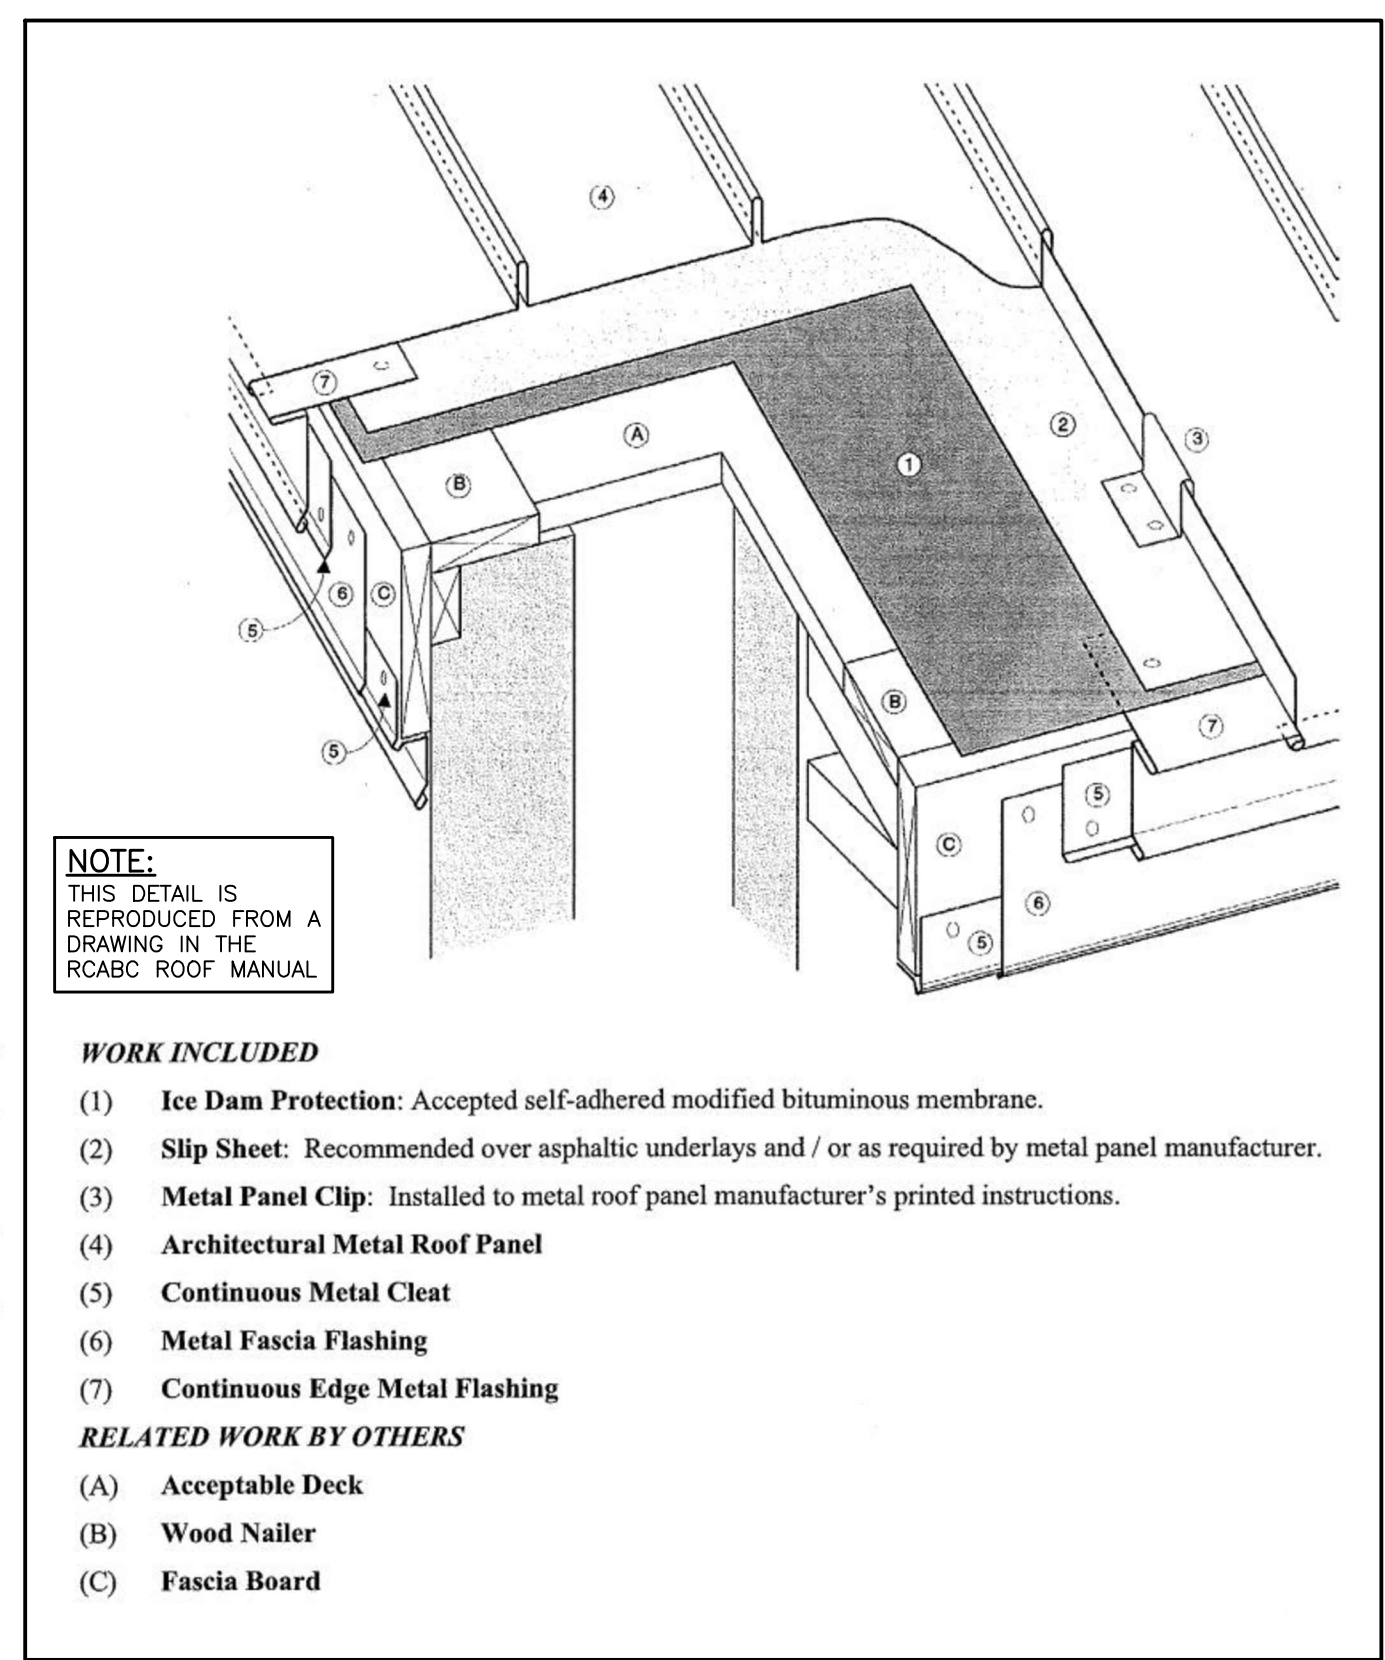

3 EAVE & GABLE FLASHING - STANDING SEAM ROOF
N.T.S.

3	Issued for Variance Application	2023/09/05	LL
2	Re-issued for Delegated Development Permit	2023/06/29	LL
1	Delegated Development Permit	2022/10/3	LL
No.	Revision	Date	By

Project Name
READ RESIDENCE - GARDEN SUITE

965 COWICHAN STREET, VICTORIA BC

Sheet Title
DETAILS

Drawn By LL Scale AS SHOWN

Designed By LL Date AUGUST 5, 2023

Project Number 100

Sheet Number 100


Revision

A5.2

Drawing Notes

All drawings, plans, models, designs, specifications and other documents prepared by Lane Design and used in connection with this project are instruments of service for the work shown in them (the "Work") and as such are and remain the property of Lane Design whether the Work is executed or not, and Lane Design reserves the copyright in them and in the Work executed from them, and they shall not be used for any other work or project.


The general contractor is responsible for confirming and correlating dimensions at the job site. The designer will not be responsible for construction means, methods, techniques, sequences or procedures, or safety precautions and programs in connection with the project.

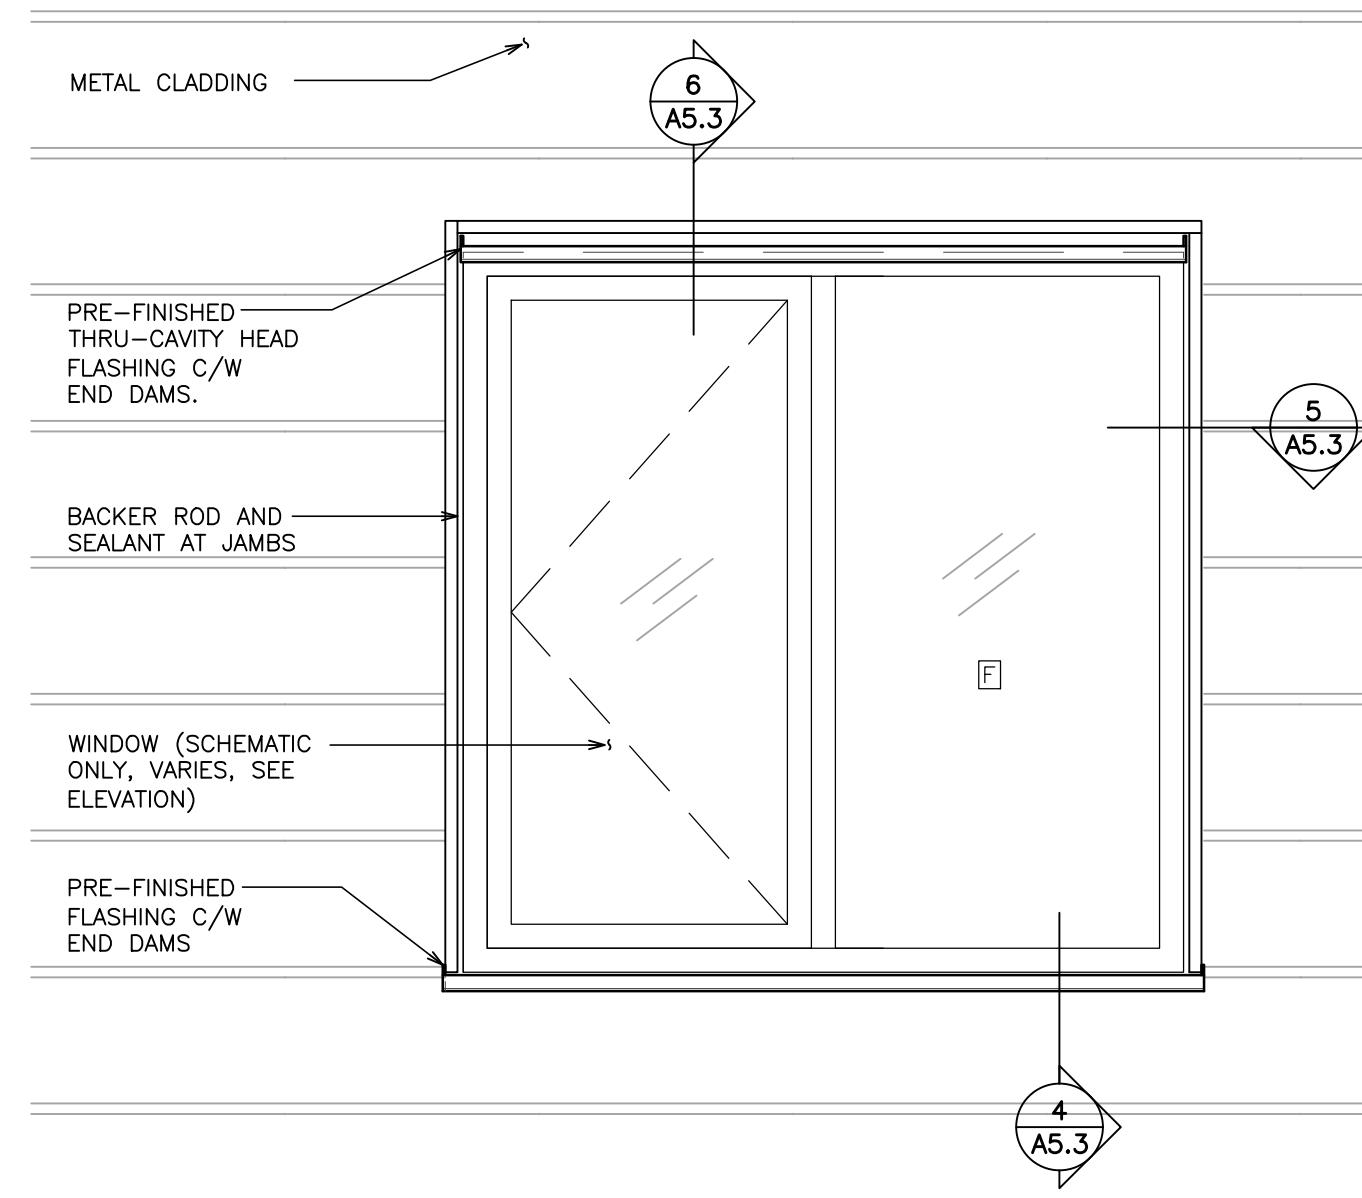


NOTE:

- WINDOW SIZE, TYPE AND ARRANGEMENT VARIES.
- CLADDING VARIES. REFER TO ELEVATIONS R-3.1 & R-3.2 FOR LOCATION OF CLADDINGS RELATIVE TO WINDOW TYPES.

3 SCHEMATIC WINDOW ELEVATION
A5.3 N.T.S.

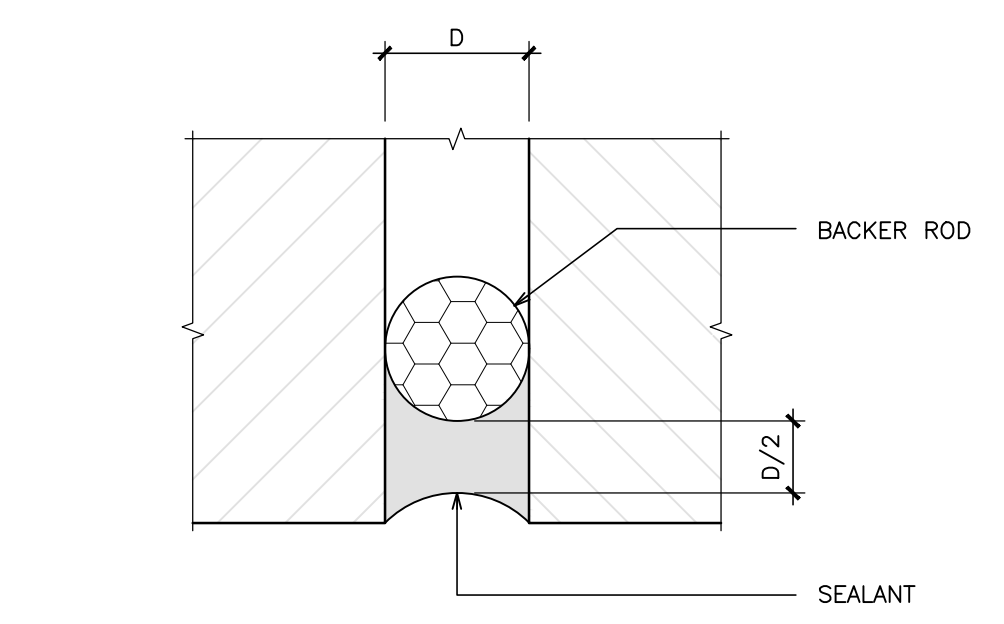

2 TYPICAL BACKER ROD AND SEALANT
A5.3 1'-0" = 1'-0"

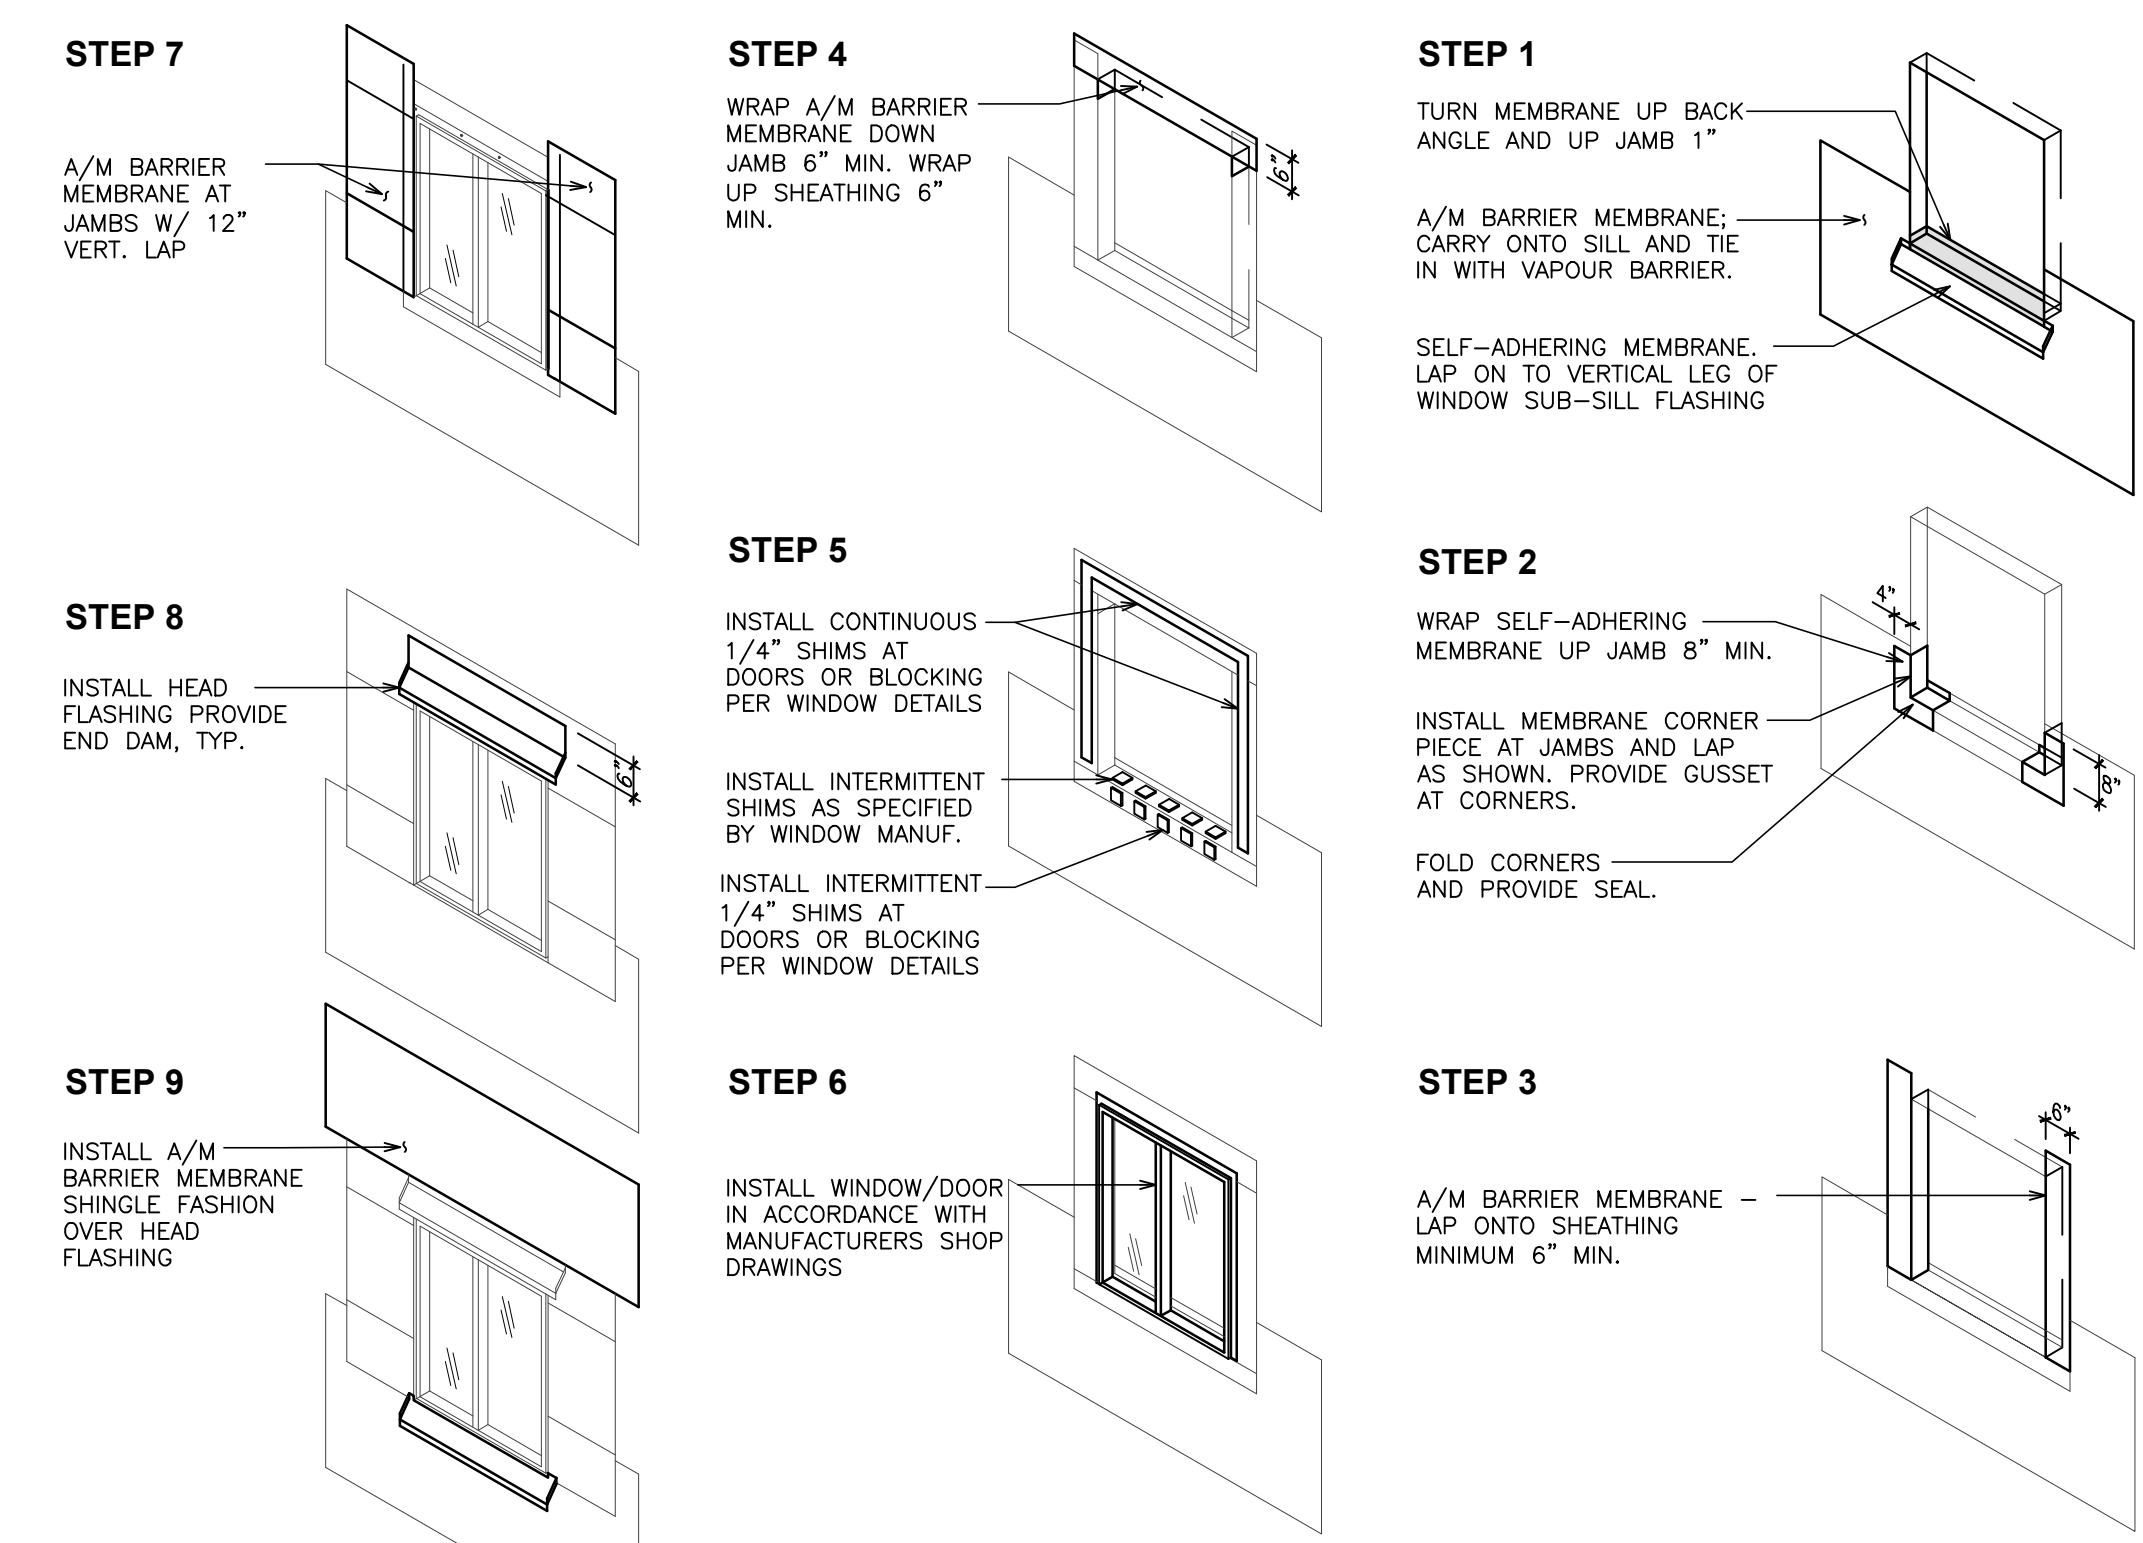


NOTE:


- REFER TO 1A/A5.1 FOR TYPICAL METAL FLASHING END DAM FORMATION.
- REFER TO TYPICAL HEAD, JAMB, AND SILL DETAILS FOR MEMBRANE APPLICATIONS.
- ENSURE THAT ALL EDGES AND CORNERS ARE WATERTIGHT, WITH THE EXCEPTION OF SILL DRAINAGE.

1 TYPICAL WINDOW / DOOR INSTALLATION SEQUENCE
A5.3 N.T.S.


3	Issued for Variance Application	2023/09/05	LL
2	Re-issued for Delegated Development Permit	2023/06/29	LL
1	Delegated Development Permit	2022/10/3	LL
No.	Revision	Date	By

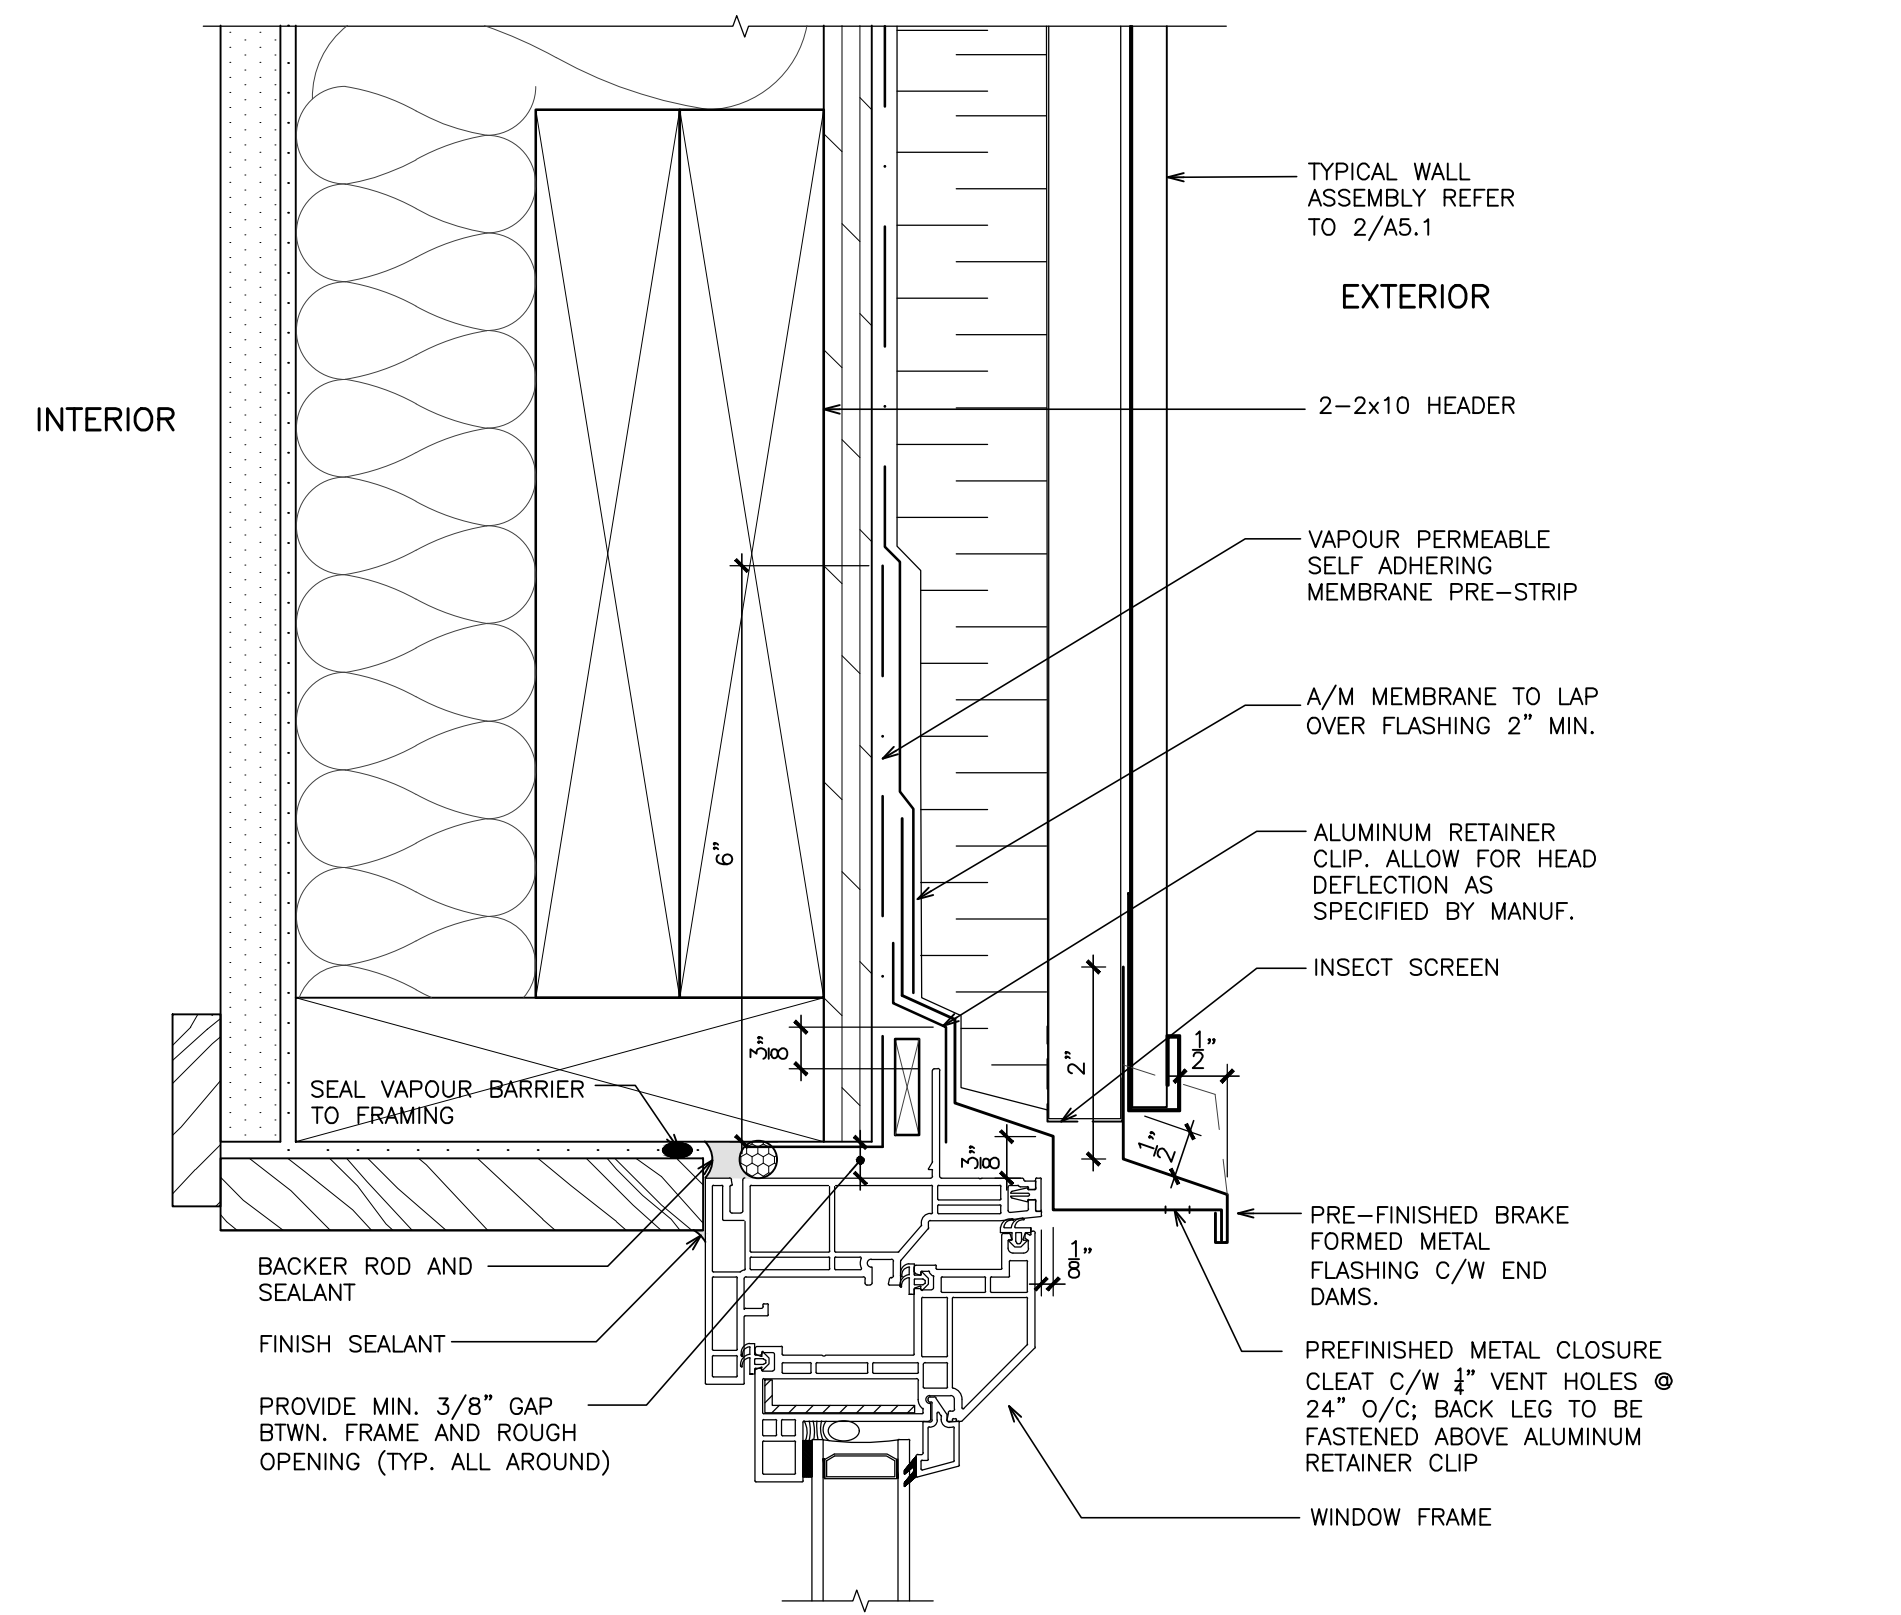

6 WINDOW HEAD
A5.3 6" = 1'-0"

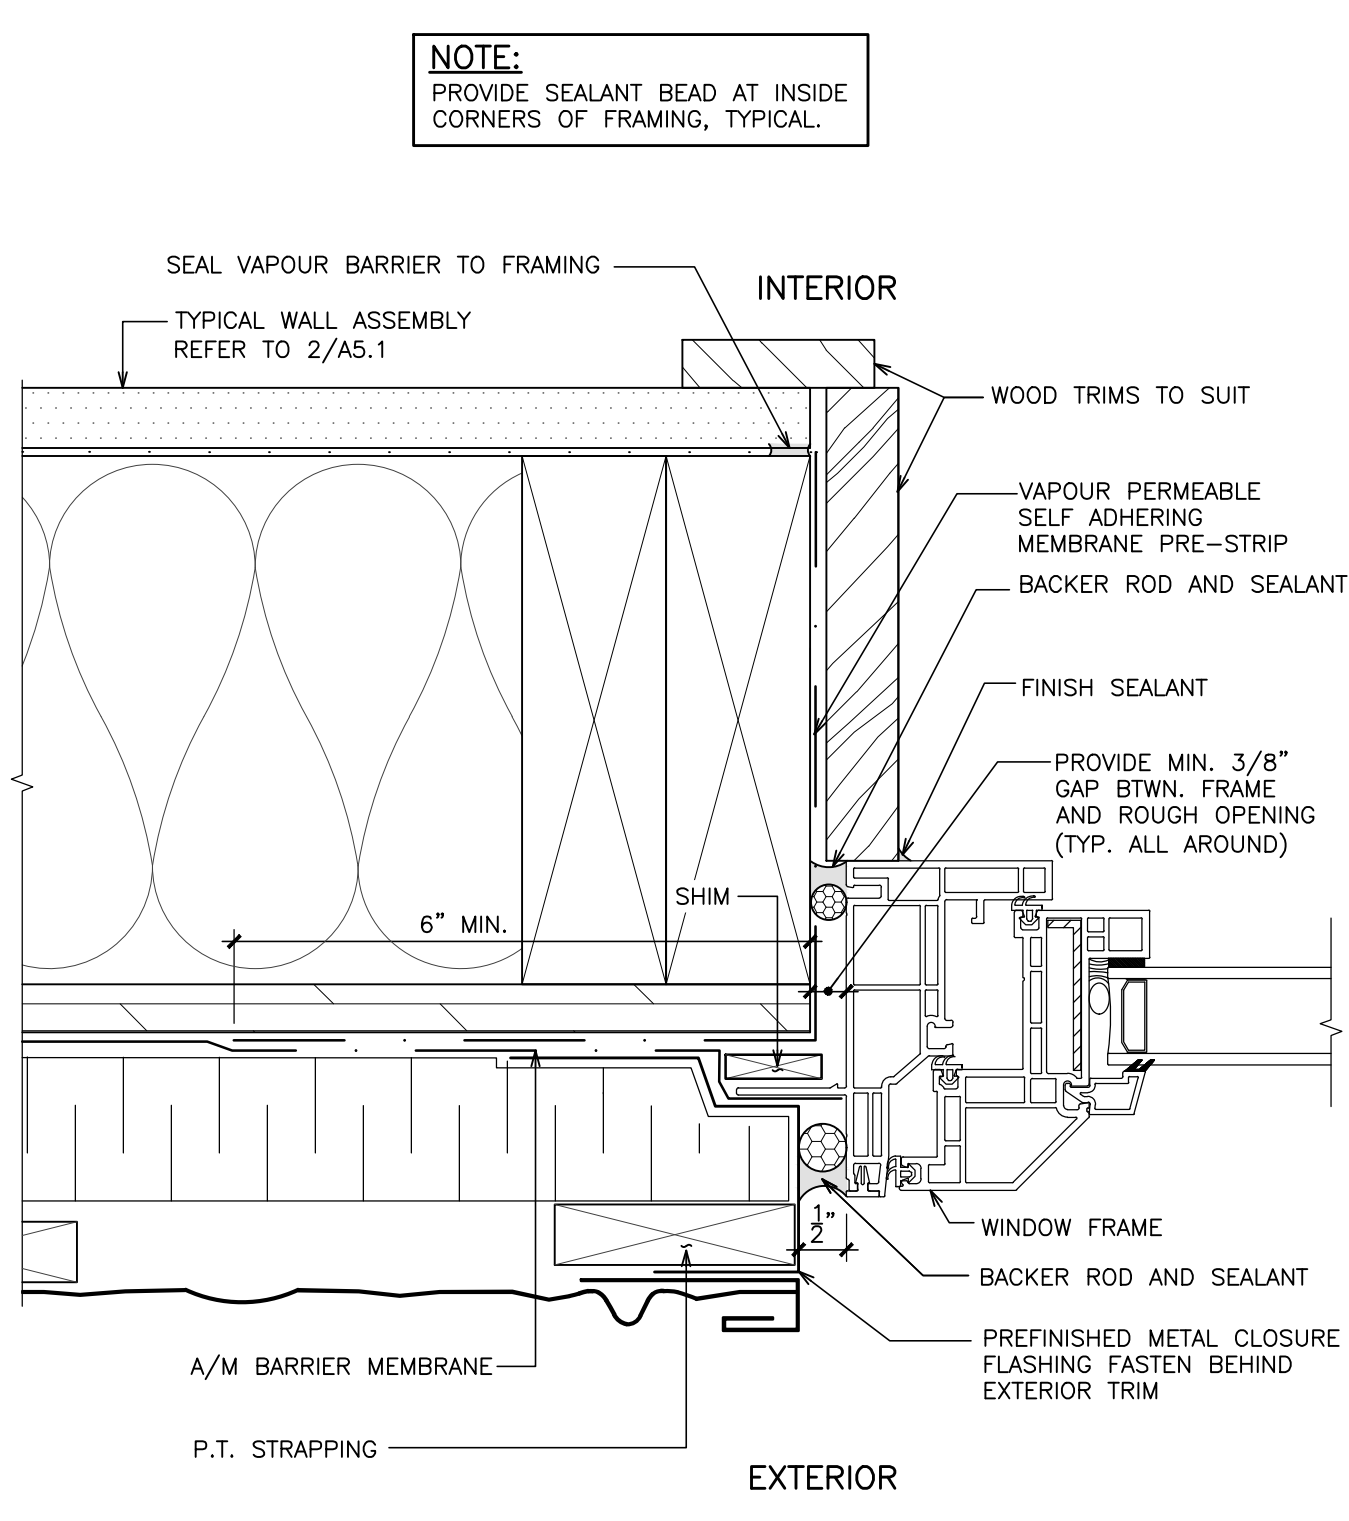

5 WINDOW JAMB
A5.3 6" = 1'-0"

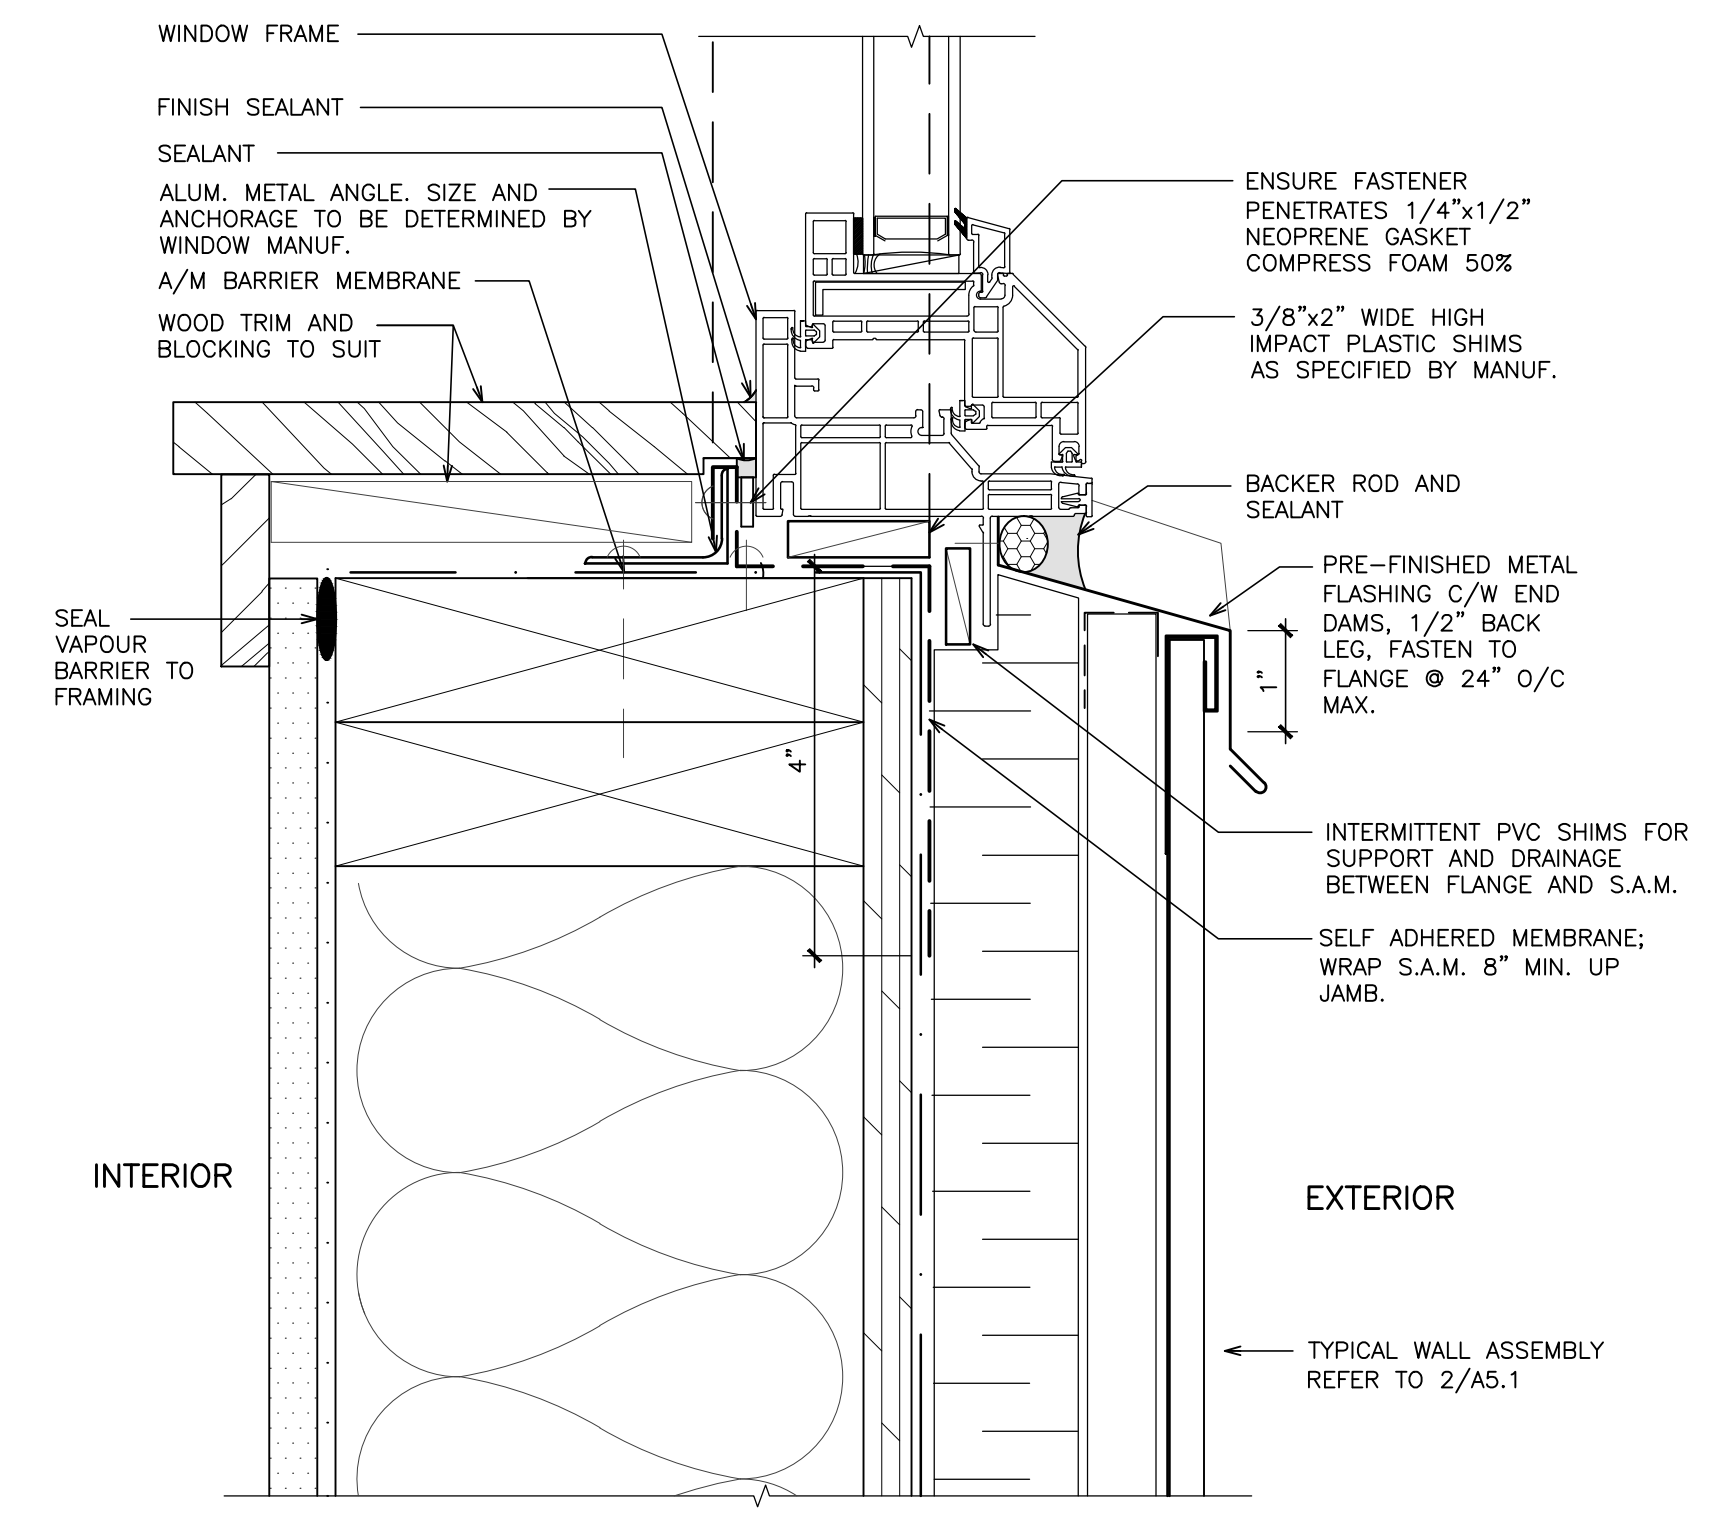

4 WINDOW SILL
A5.3 6" = 1'-0"

Project Name
READ RESIDENCE - GARDEN SUITE


965 COWICHAN STREET, VICTORIA BC

Sheet Title
WINDOW DETAILS

Drawn By LL Scale AS SHOWN
Designed By LL Date AUGUST 5, 2023
Project Number 100


Sheet Number
A5.3

Revision

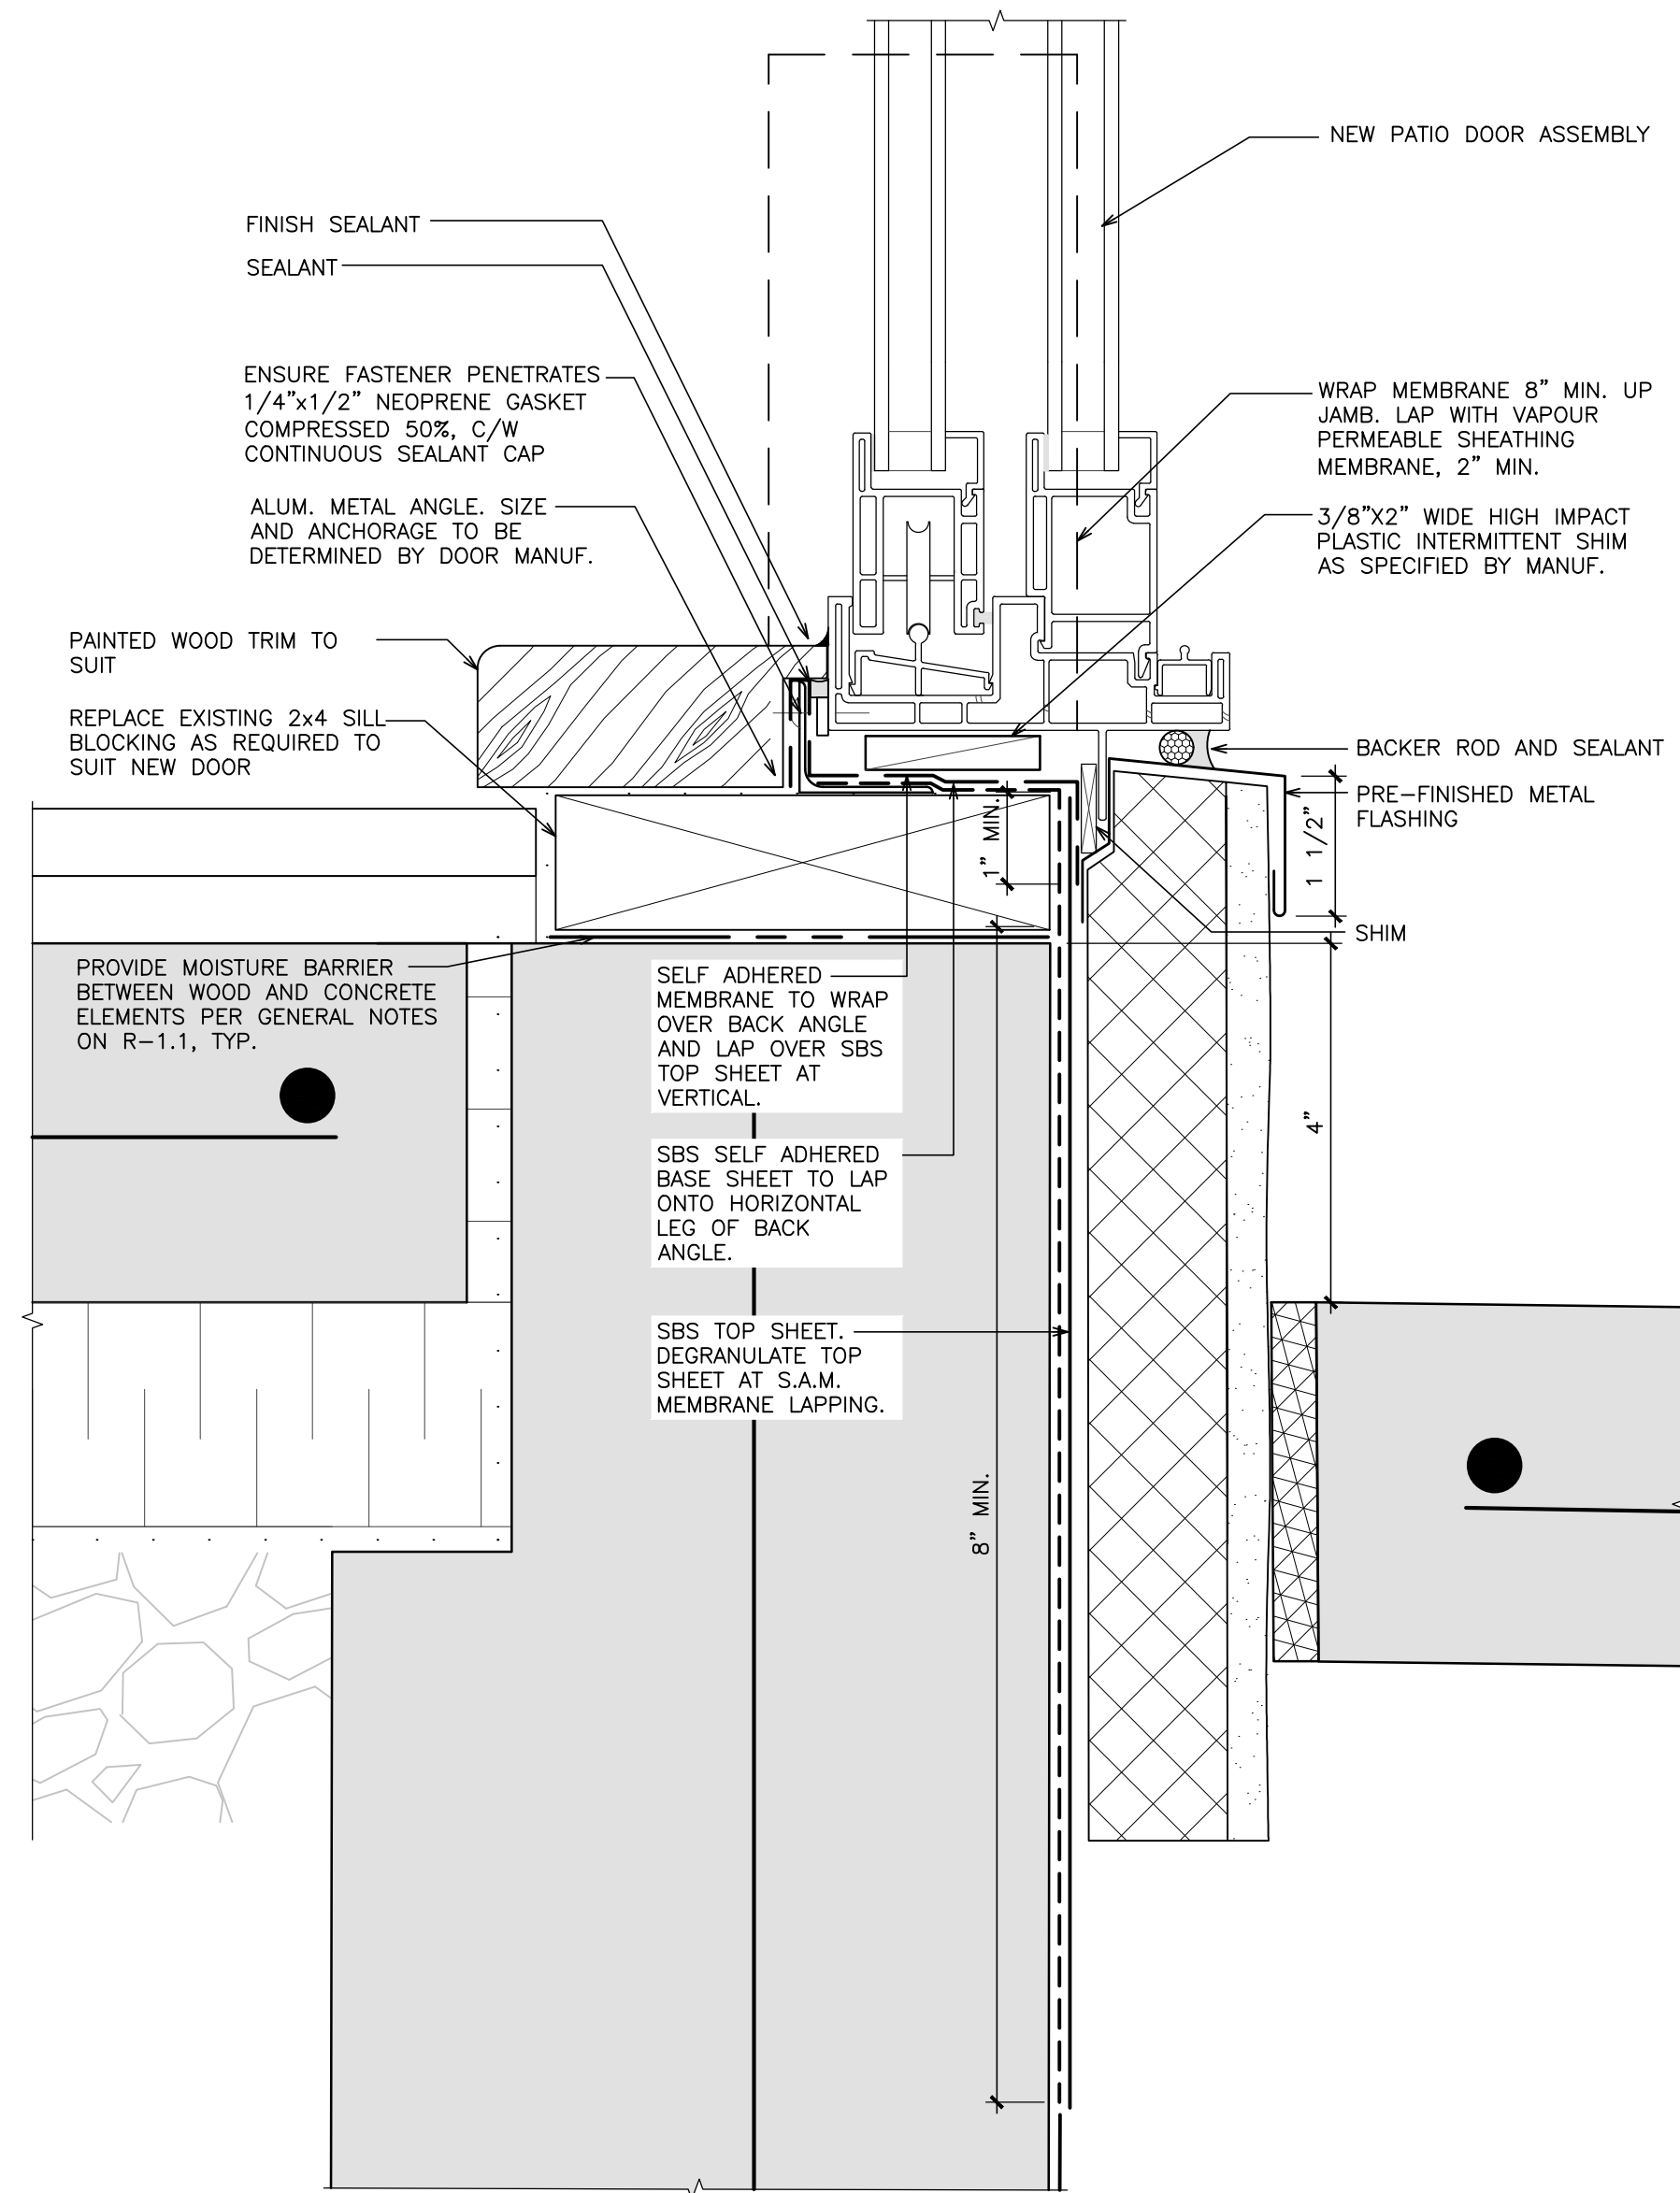


2 SLIDING DOOR SILL
6" = 1'-0"


NOTE:
PROVIDE SEALANT BEAD AT INSIDE CORNERS OF FRAMING, TYPICAL.

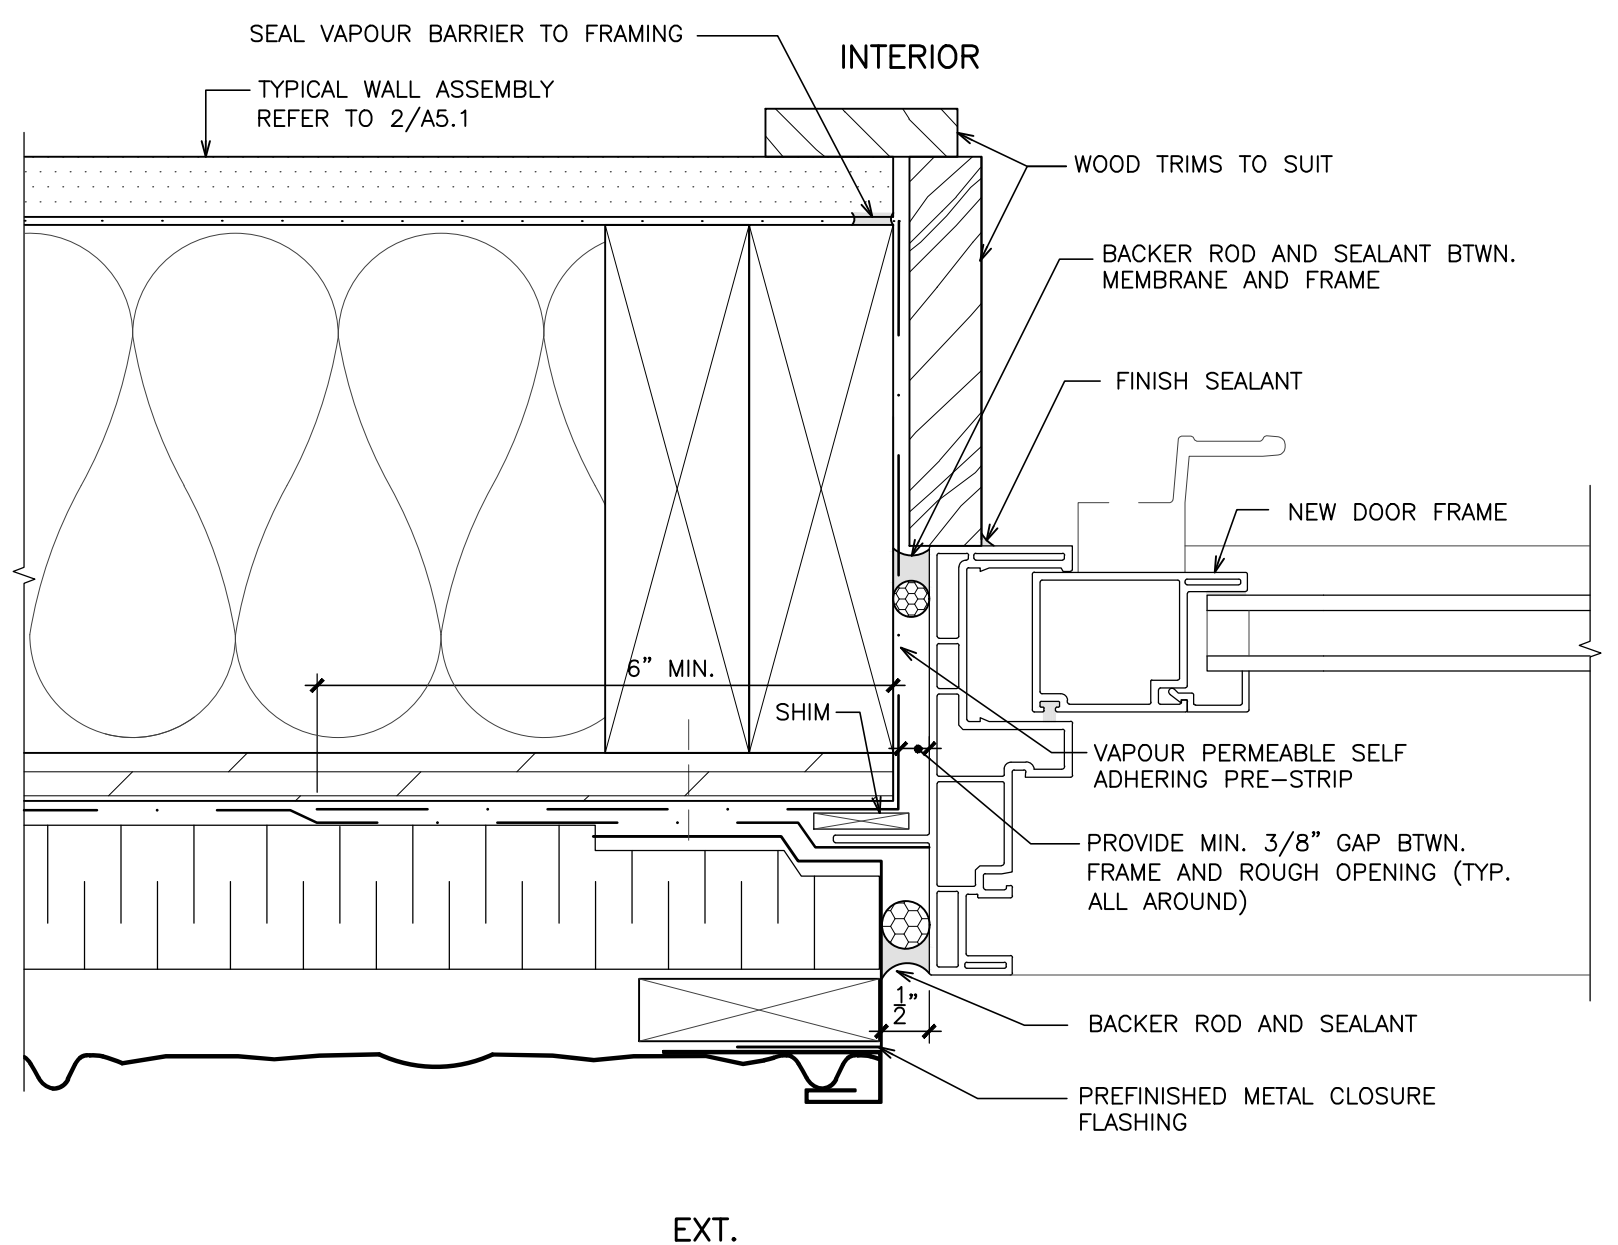

4 SLIDING DOOR JAMB
6" = 1'-0"

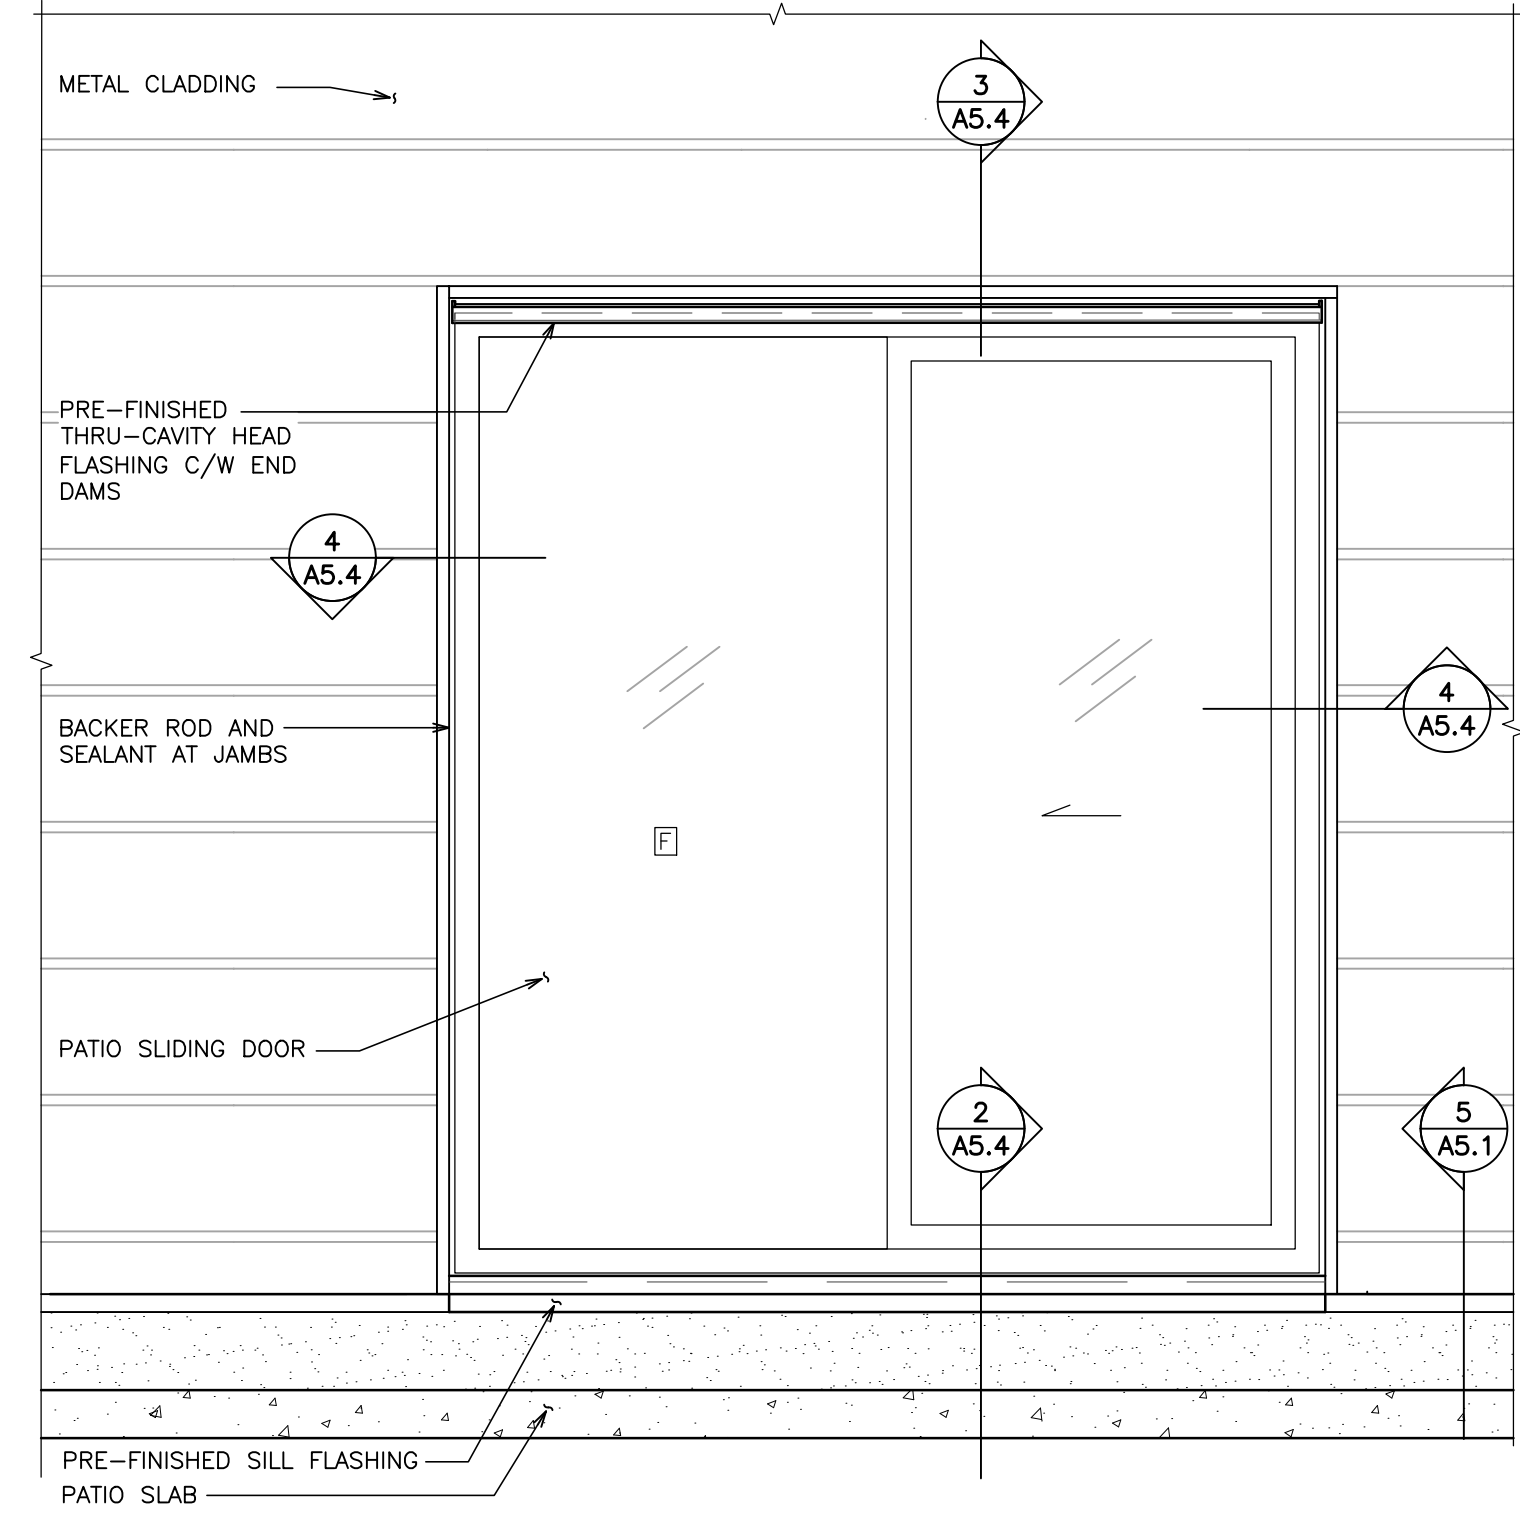

1 SCHEMATIC SLIDING DOOR ELEVATION
N.T.S.

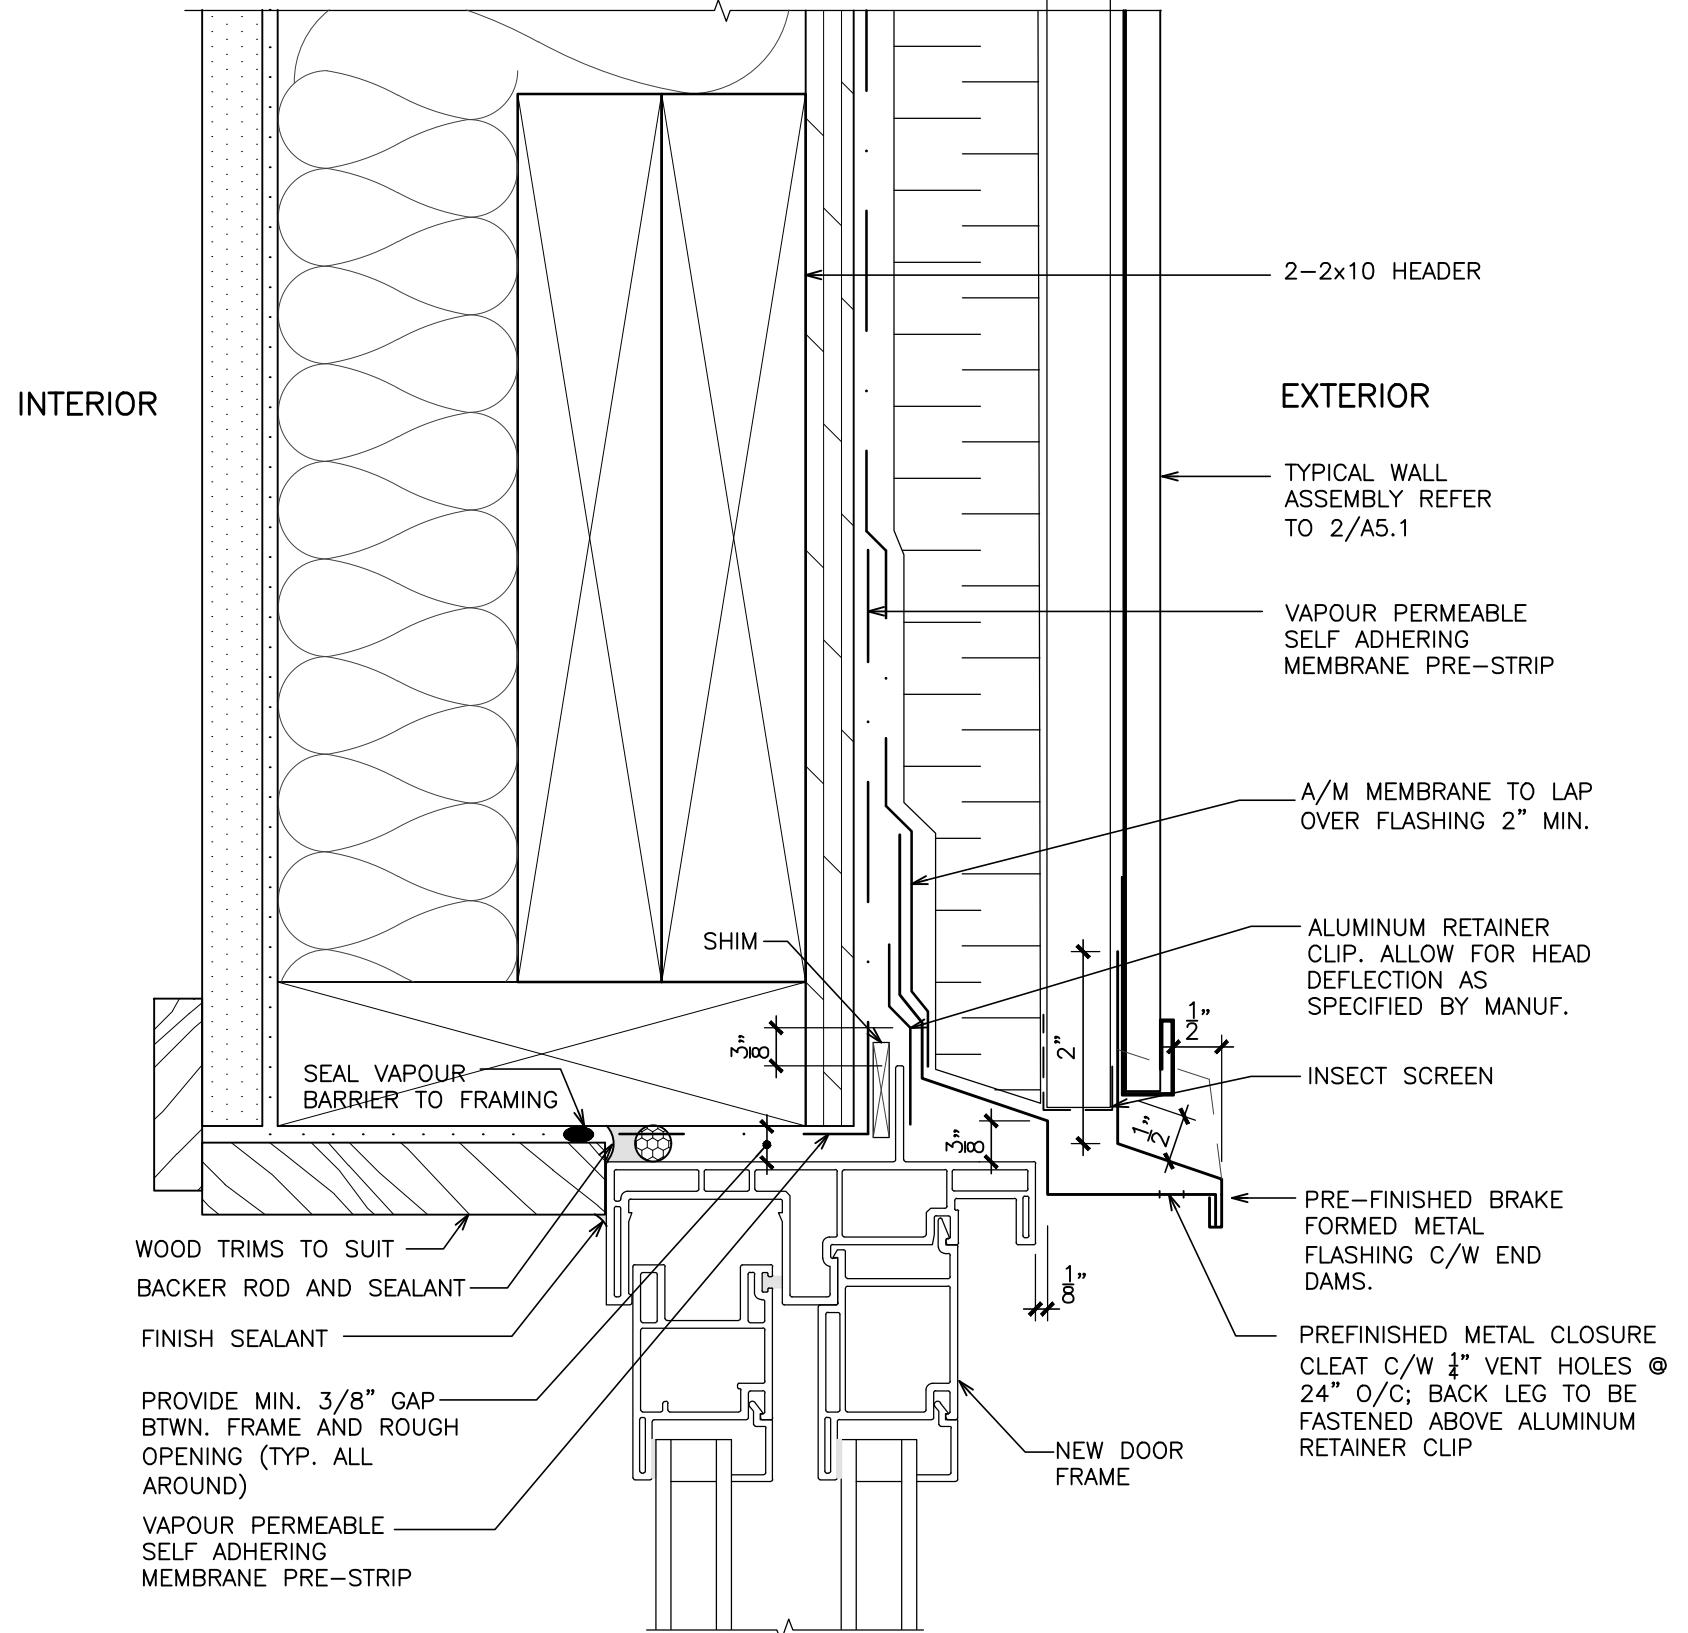


3 SLIDING DOOR HEAD
6" = 1'-0"

Drawing Notes
All drawings, plans, models, designs, specifications and other documents prepared by Lane Design and used in connection with this project are instruments of service for the work shown in them (the "Work") and as such are and remain the property of Lane Design whether the Work is executed or not, and Lane Design reserves the copyright in them and in the Work executed from them, and they shall not be used for any other work or project.
The general contractor is responsible for confirming and correlating dimensions at the job site. The designer will not be responsible for construction means, methods, techniques, sequences or procedures, or safety precautions and programs in connection with the project.


3	Issued for Variance Application	2023/09/05	LL
2	Re-issued for Delegated Development Permit	2023/06/29	LL
1	Delegated Development Permit	2022/10/3	LL
No.	Revision	Date	By

Project Name
READ RESIDENCE - GARDEN SUITE
965 COWICHAN STREET, VICTORIA BC
Sheet Title
SLIDING DOOR DETAILS


Drawn By LL Scale AS SHOWN
Designed By LL Date AUGUST 5, 2023
Project Number 100
Sheet Number Revision
A5.4

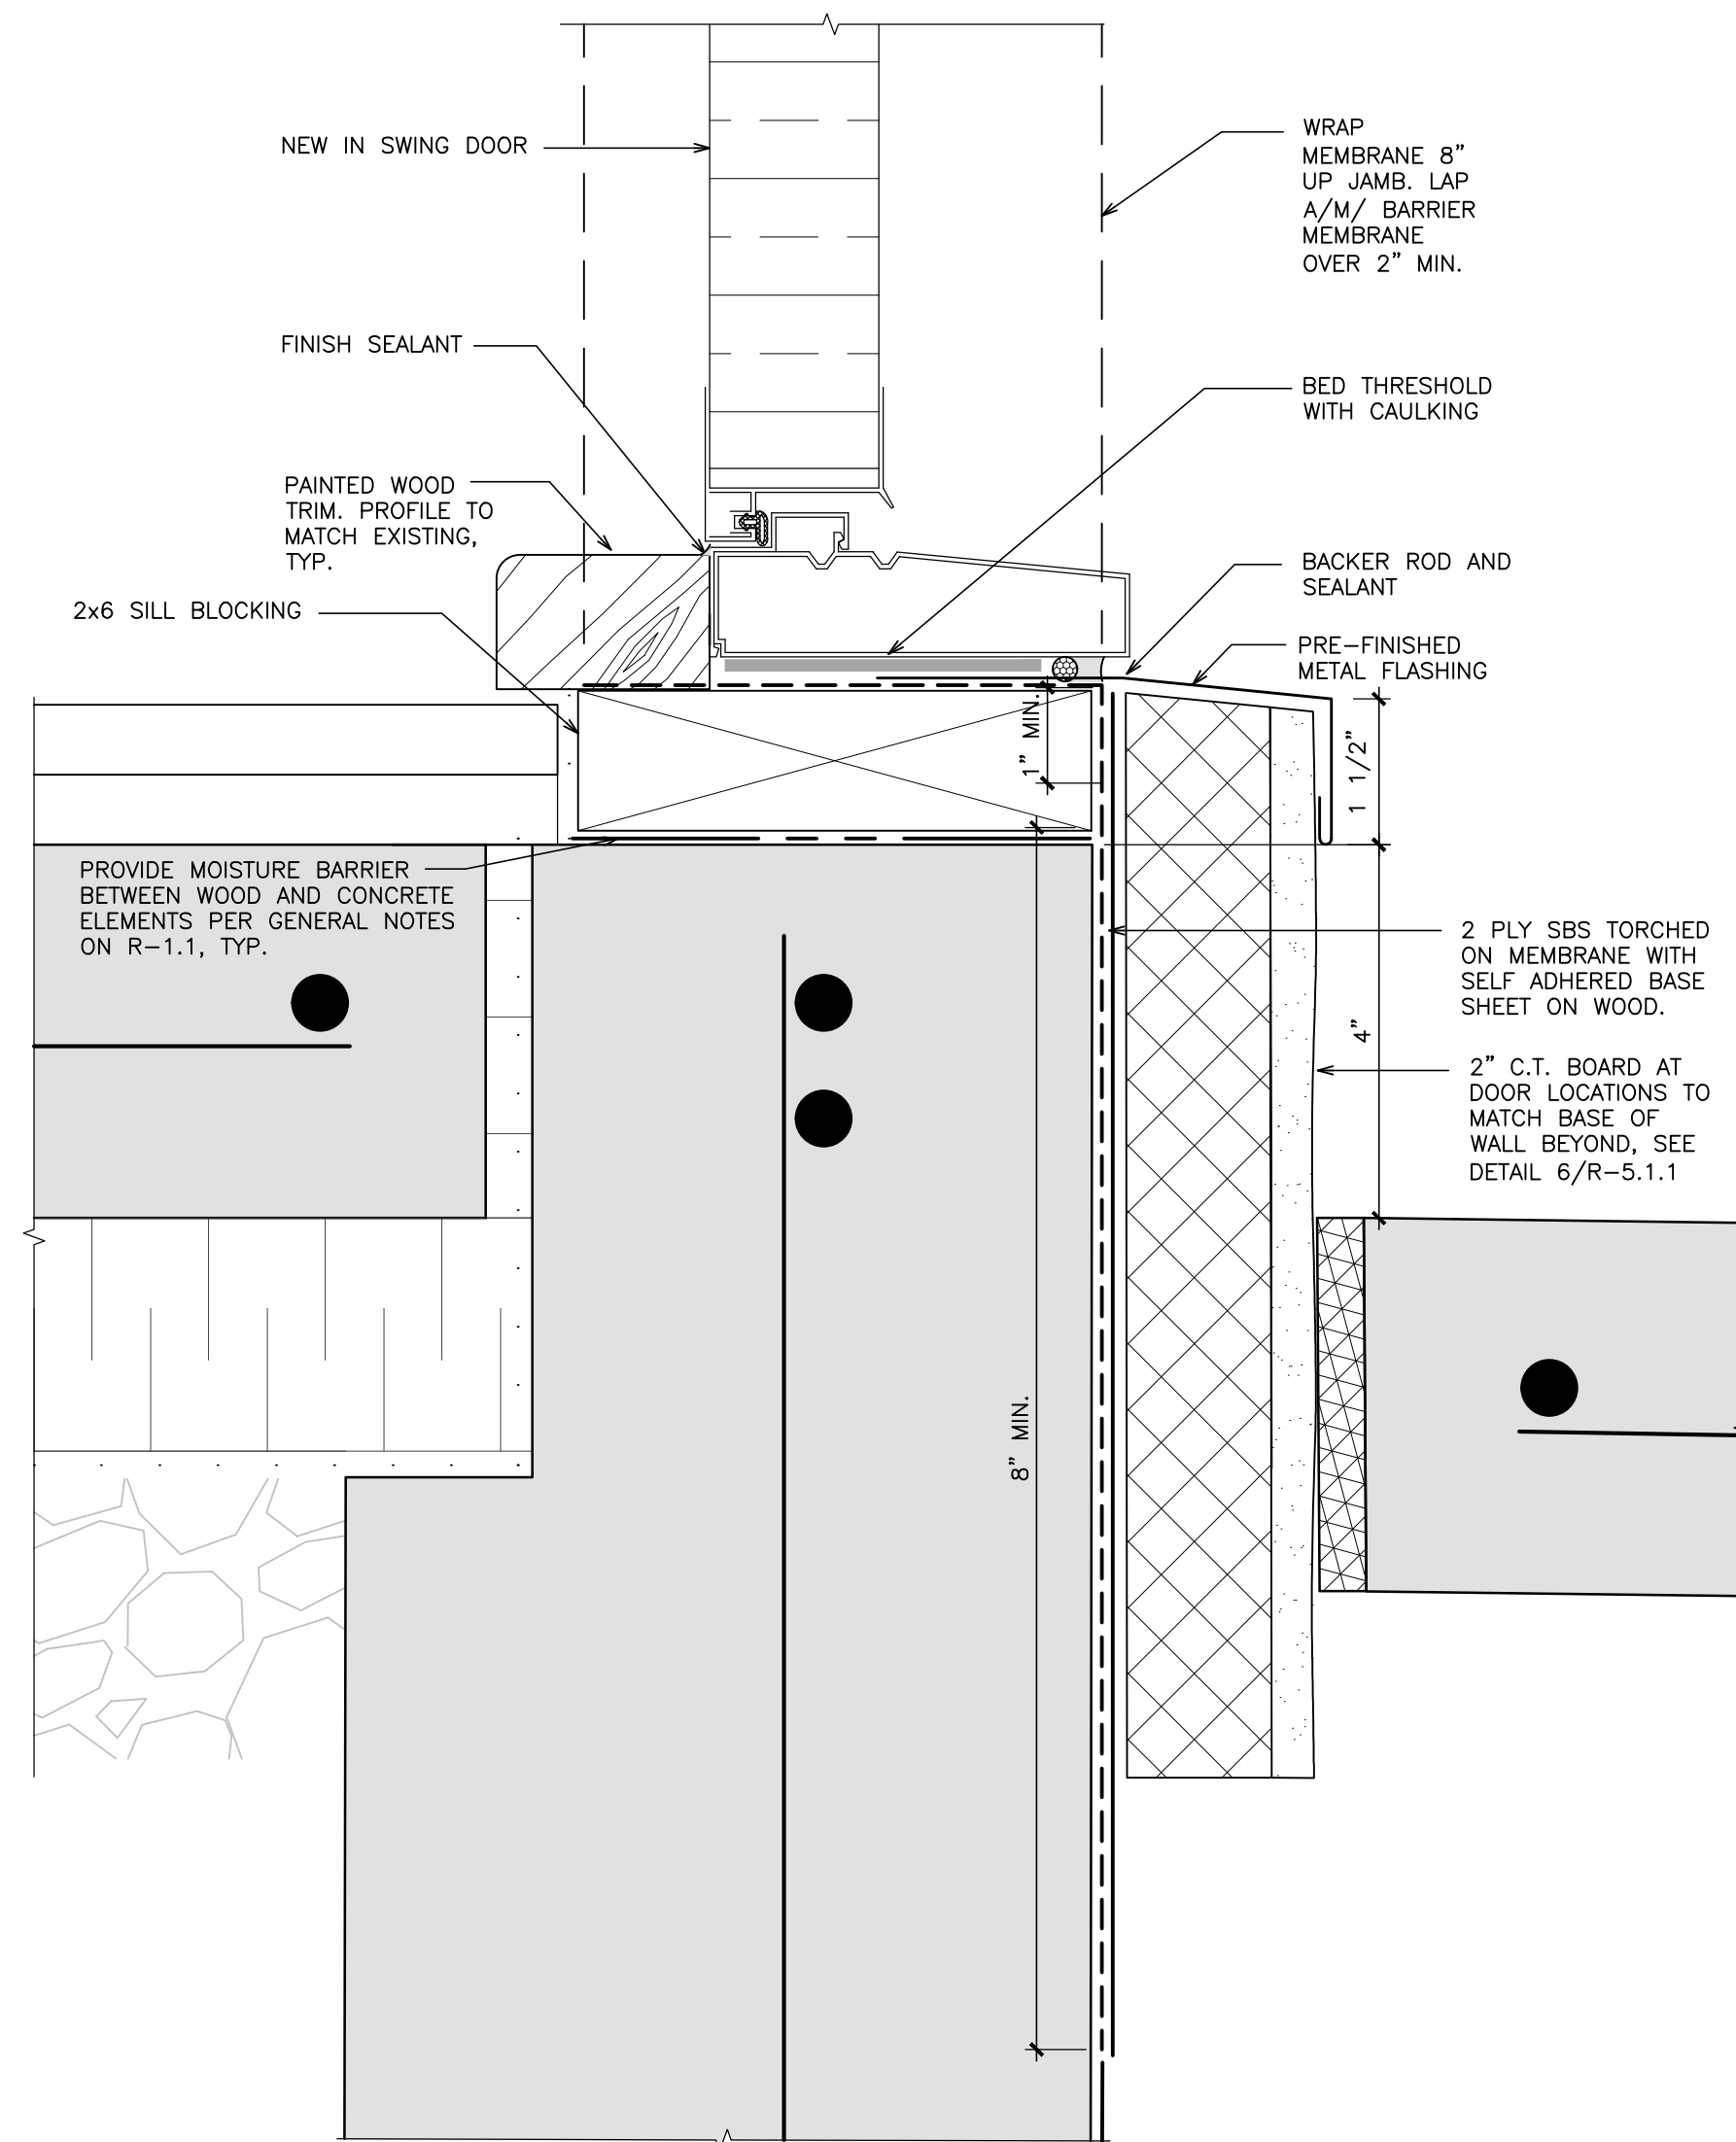


2
A5.5
SWING DOOR SILL
6" = 1'-0"

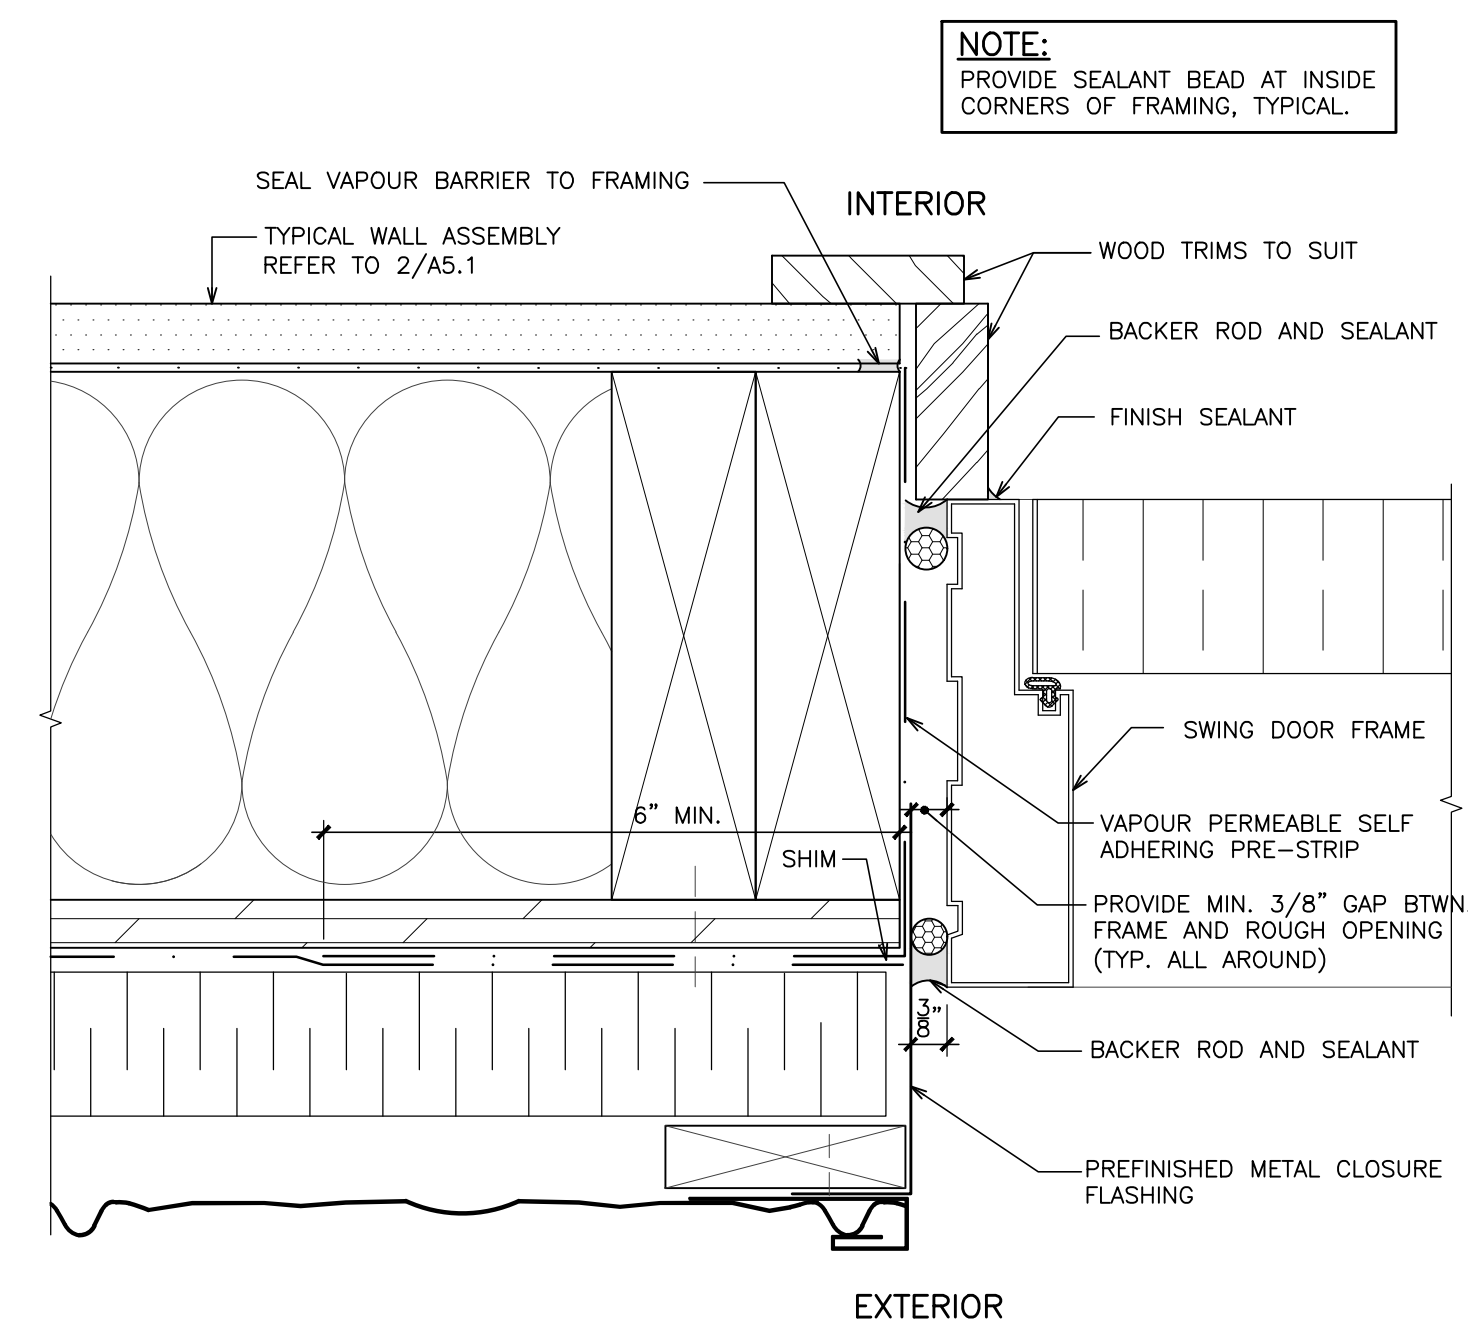

4
A5.5
SWING DOOR JAMB
6" = 1'-0"

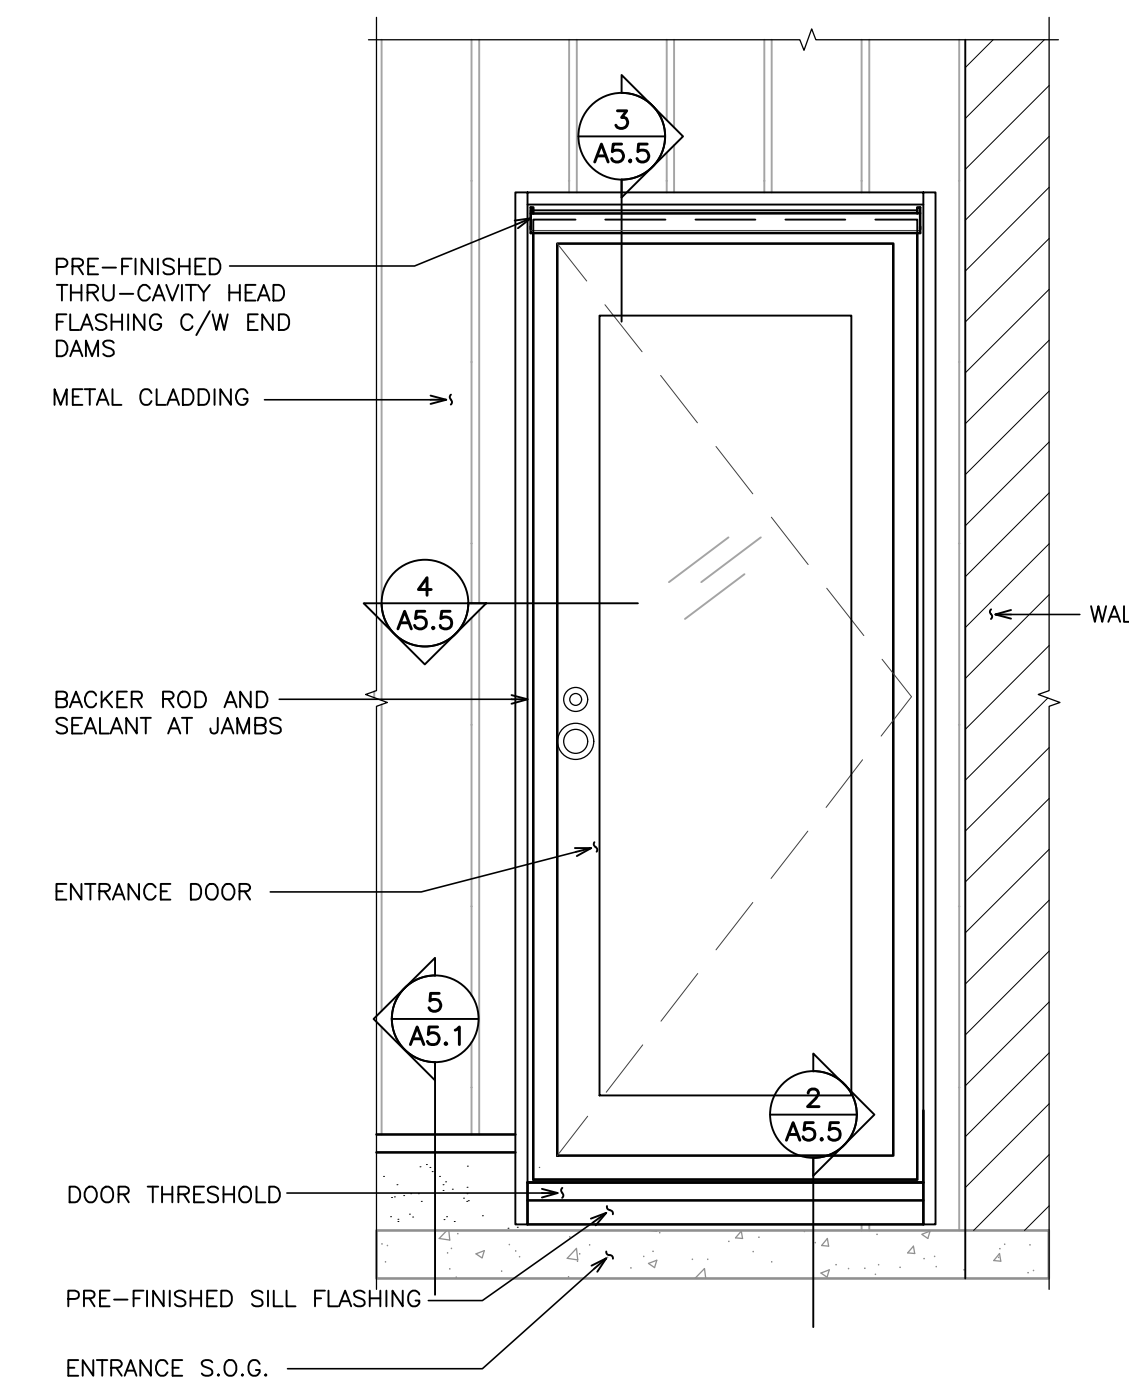

1
A5.5
SCHEMATIC SWING DOOR ELEVATION
N.T.S.

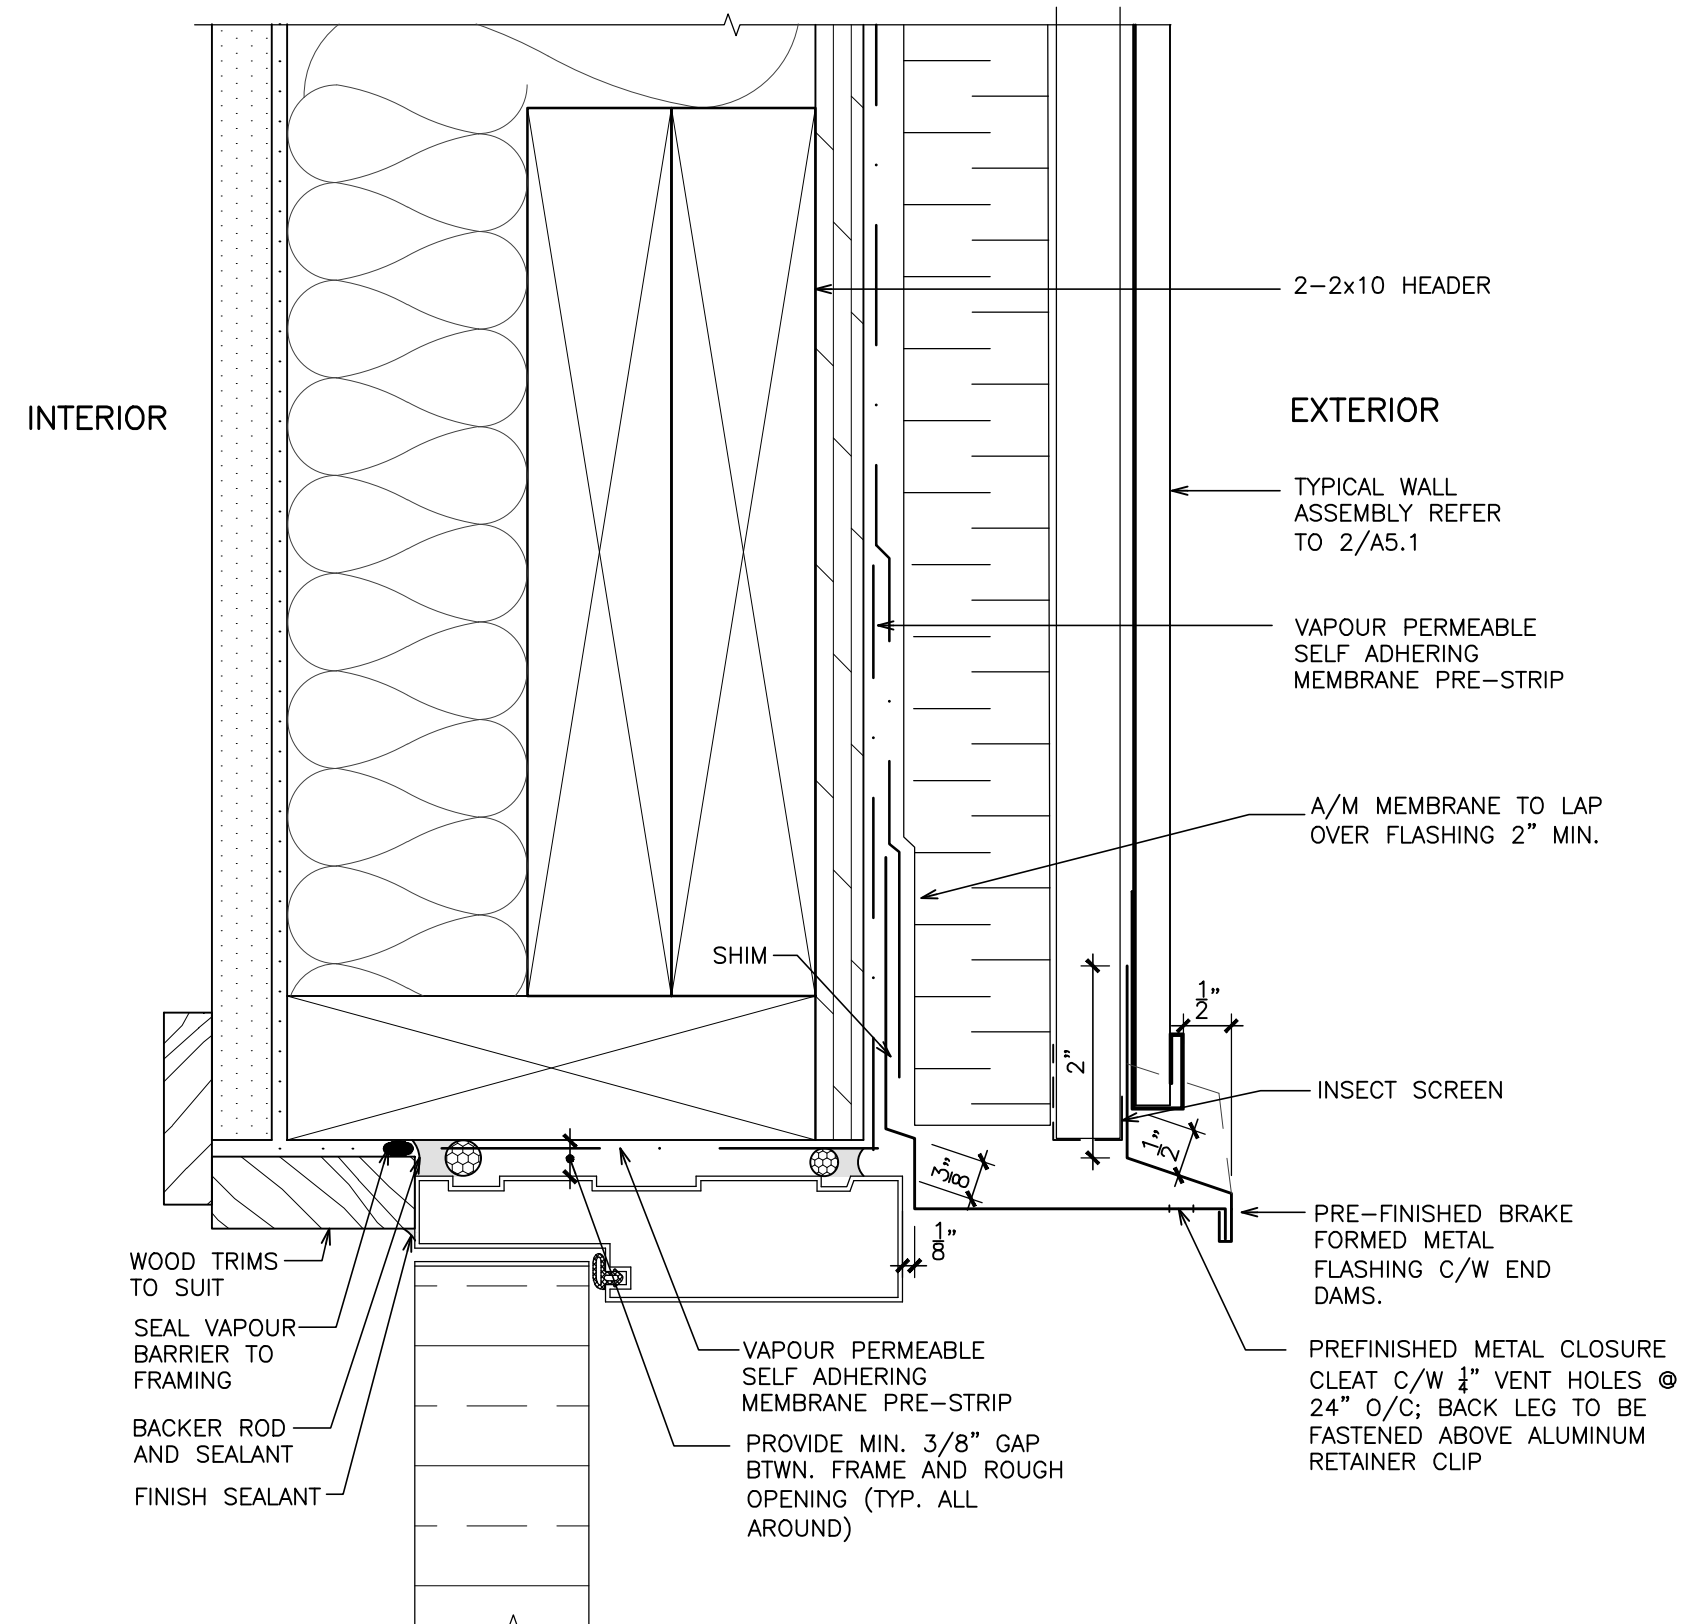

3
A5.5
SWING DOOR HEAD
6" = 1'-0"

Drawing Notes

All drawings, plans, models, designs, specifications and other documents prepared by Lane Design and used in connection with this project are instruments of service for the work shown in them (the "Work") and as such are and remain the property of Lane Design whether the Work is executed or not, and Lane Design reserves the copyright in them and in the Work executed from them, and they shall not be used for any other work or project.

The general contractor is responsible for confirming and correlating dimensions at the job site. The designer will not be responsible for construction means, methods, techniques, sequences or procedures, or safety precautions and programs in connection with the project.

3	Issued for Variance Application	2023/09/05	LL
2	Re-issued for Delegated Development Permit	2023/06/29	LL
1	Delegated Development Permit	2022/10/3	LL
No.	Revision	Date	By

Project Name
READ RESIDENCE - GARDEN SUITE

965 COWICHAN STREET, VICTORIA BC

Sheet Title
SWING DOOR DETAILS


Drawn By LL Scale AS SHOWN
Designed By LL Date AUGUST 5, 2023
Project Number 100
Sheet Number Revision
A5.5

WOOD FRAMING cont.

SHEATHING

- A. ROOF SHEATHING (U.N.O. ON PLAN) SLOPED ROOF (SLOPE > 15%) 1/2" PLYWOOD OR 7/16" O.S.B WITH H-CLIPS AT UNSUPPORTED JOINTS.
B. FLOOR SHEATHING (U.N.O. ON PLAN) 5/8" TONGUE AND GROOVE PLYWOOD IF NO CONCRETE TOPPING IS USED.
C. EXTERIOR WALL SHEATHING (U.N.O. ON PLAN) 3/8" PLYWOOD ON EXTERIOR SIDE. 1/2" PLYWOOD OR 7/16" O.S.B SHEATHING IF WALLS CLAD WITH VERTICAL STRAPPING OR BRICK VENEER.
D. SHEAR WALL SHEATHING SEE SHEAR WALL SCHEDULE FOR SHEATHING REQUIREMENTS AT SHEAR WALL LOCATIONS.


- 2. LAY FLOOR AND ROOF SHEATHING WITH THE SURFACE GRAIN AT RIGHT ANGLES TO THE JOISTS. STAGGER THE JOINTS PARALLEL TO THE JOISTS.

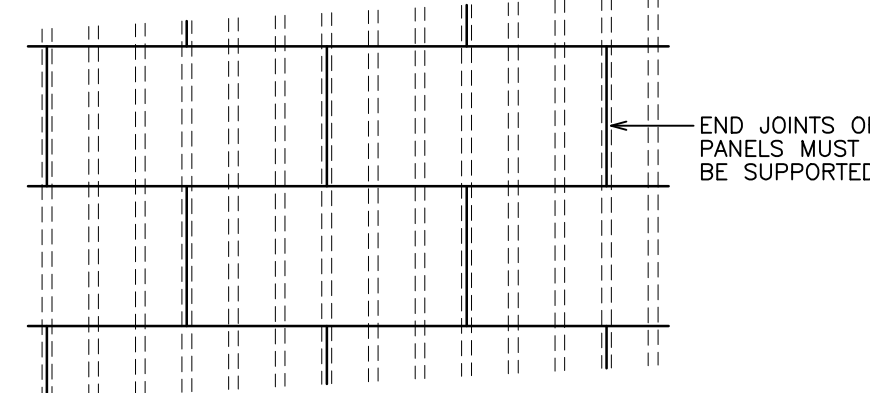

- 3. DRYWALL OR SHEATHING ON LOAD BEARING WALLS OR SHEAR WALLS SHALL BE FASTENED DIRECTLY TO THE STUDS, WITHOUT THE USE OF RESILIENT METAL CHANNELS.

SHRINKAGE

- 1. FRAMING DETAILS SHALL ENSURE UNIFORM SHRINKAGE. ADJACENT PORTIONS OF STRUCTURE SHALL BE SUPPORTED ON ROUGHLY EQUIVALENT AMOUNTS OF HORIZONTAL TIMBER (JOISTS AND SILL PLATES).
2. FRAMING DETAILS AROUND NON-SHRINKING STRUCTURAL ELEMENTS (CONCRETE, STEEL, PARALLAM, GLULAM, MICROLAM, PLYWOOD ETC.) SHALL TAKE INTO ACCOUNT THE SHRINKAGE OF THE TIMBER.

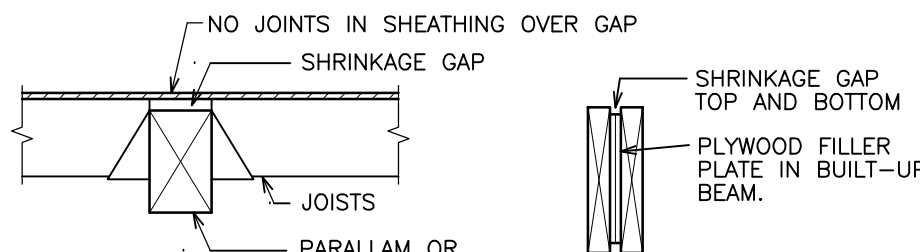


WALL ANCHORAGE

- 1. ANCHOR SILL PLATES TO CONCRETE FOUNDATIONS AS FOLLOWS:

Table with columns: LOCATION, SIZE, ANCHOR, SPACING. Rows include NON-LOAD BEARING, EXTERIOR BEARING, WALL PANEL, and SHEAR WALL.

- 2. ANCHOR BOLTS SHALL HAVE A MINIMUM 5" EMBEDMENT AND A MINIMUM 3" PROJECTION ABOVE THE CONCRETE.
3. THE ANCHOR BOLTS MAY BE CAST IN PLACE OR GROUDED INTO PREDRILLED HOLES WITH THE HILTI-HIT SYSTEM.
4. POWER DRIVEN FASTENERS TO HAVE MINIMUM 3/4" PENETRATION INTO CONCRETE.
5. ANCHOR BOLTS TO BE LOCATED WITHIN 1'-8" FROM ENDS OF WALLS.
6. MINIMUM 2 ANCHORS PER WALL OR WALL PANEL.
7. FULL WIDTH OF WALLS SHALL BEAR ON CONCRETE UNLESS NOTED OTHERWISE.
8. SEE SHEAR WALL SCHEDULE FOR ADDITIONAL ANCHORING REQUIREMENTS OF SHEAR WALLS.

NON-SHEAR WALL ANCHORAGE EXAMPLES:

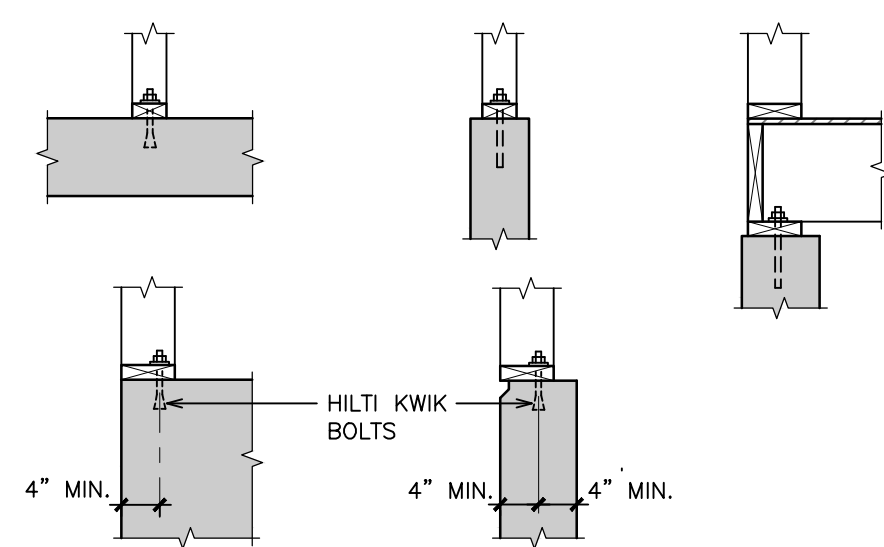


WOOD FRAMING cont.

WALLS

- 1. LOAD BEARING WALLS: DENOTED ON PLAN THIS. ALL EXTERIOR WALLS ARE LOAD BEARING.

Table showing stud and nailing requirements for different wall types: ALL FLOORS, EXTERIOR/OUTSIDE PERIMETER WALLS, INTERIOR WALLS, STAGGERED STUD CORRIDOR WALLS, DOUBLE PARTY WALLS, and 2 X 6 WALLS.


- 2. SEE ARCHITECTURAL DRAWINGS FOR LOCATIONS WHERE WIDER STUDS ARE USED (I.E. BATHROOM PLUMBING WALLS).
3. UNLESS NOTED OTHERWISE, PROVIDE A BUILT-UP STUD POST AT THE ENDS OF ALL BEAMS AND GIRDER TRUSSES FRAMING INTO A WALL.
4. NAILING OF BUILT-UP STUD POSTS SHALL CONFORM TO THE FOLLOWING SCHEDULE.

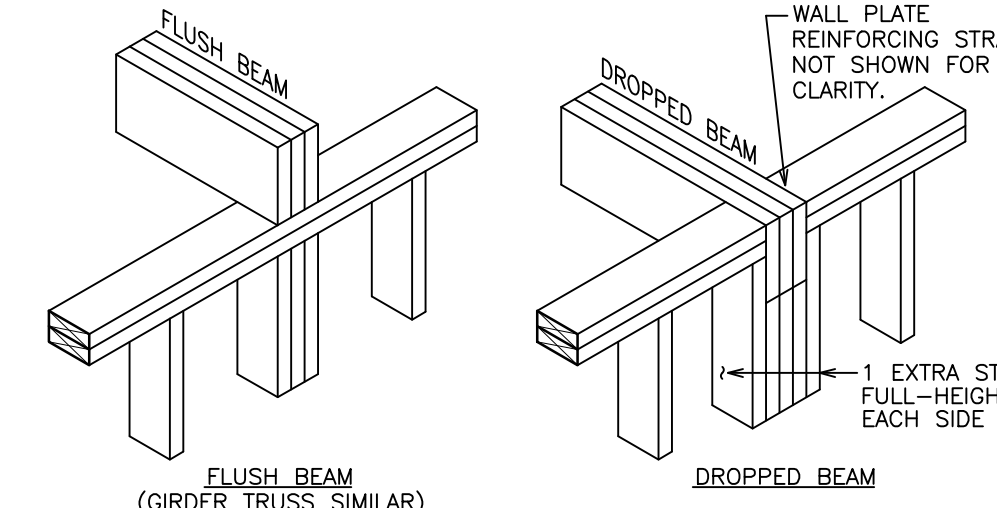


- 5. ALL POSTS AND BUILT-UP STUD POSTS SHOWN ON ANY LEVEL SHALL BE CARRIED DOWN TO THE CONCRETE UNLESS NOTED OTHERWISE.
6. ALL LOAD BEARING WALLS SHALL HAVE 2 CONTINUOUS TOP PLATES AND 1 CONTINUOUS BOTTOM PLATE.

Table showing stud and nailing requirements for different wall types: STUD, NAILING, 2 X 4, 2 X 6, and 2 X 8.

- 7. WHERE PERMANENT SHEATHING IS NOT APPLIED TO STUDS PROVIDE BLOCKING AT 3'-4" O/C FOR 2 X 4 WALLS AND 2'-0" O/C FOR 2 X 6 WALLS.
8. SILL PLATES SHALL BEAR ON A LEVEL SURFACE.
9. WHERE THE SPACING OF JOISTS OR ROOF TRUSSES MATCHES THE SPACING OF THE STUDS IN THE SUPPORTING WALL.

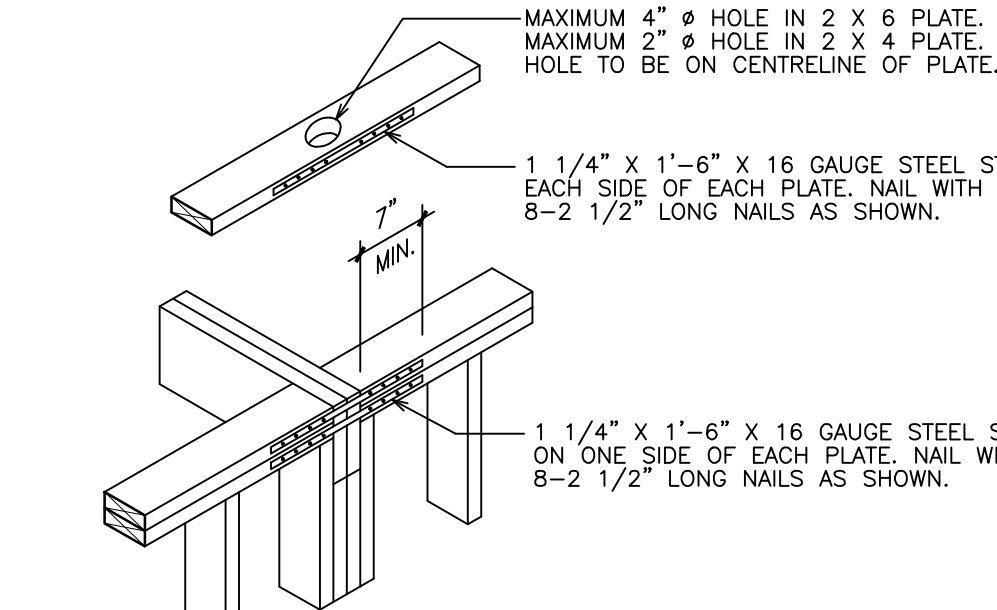

- 10. WHEN LIFT-WALL CONSTRUCTION IS USED FOR EXTERIOR WALLS, THE ADJACENT WALL PANELS SHALL BE WELL CONNECTED.

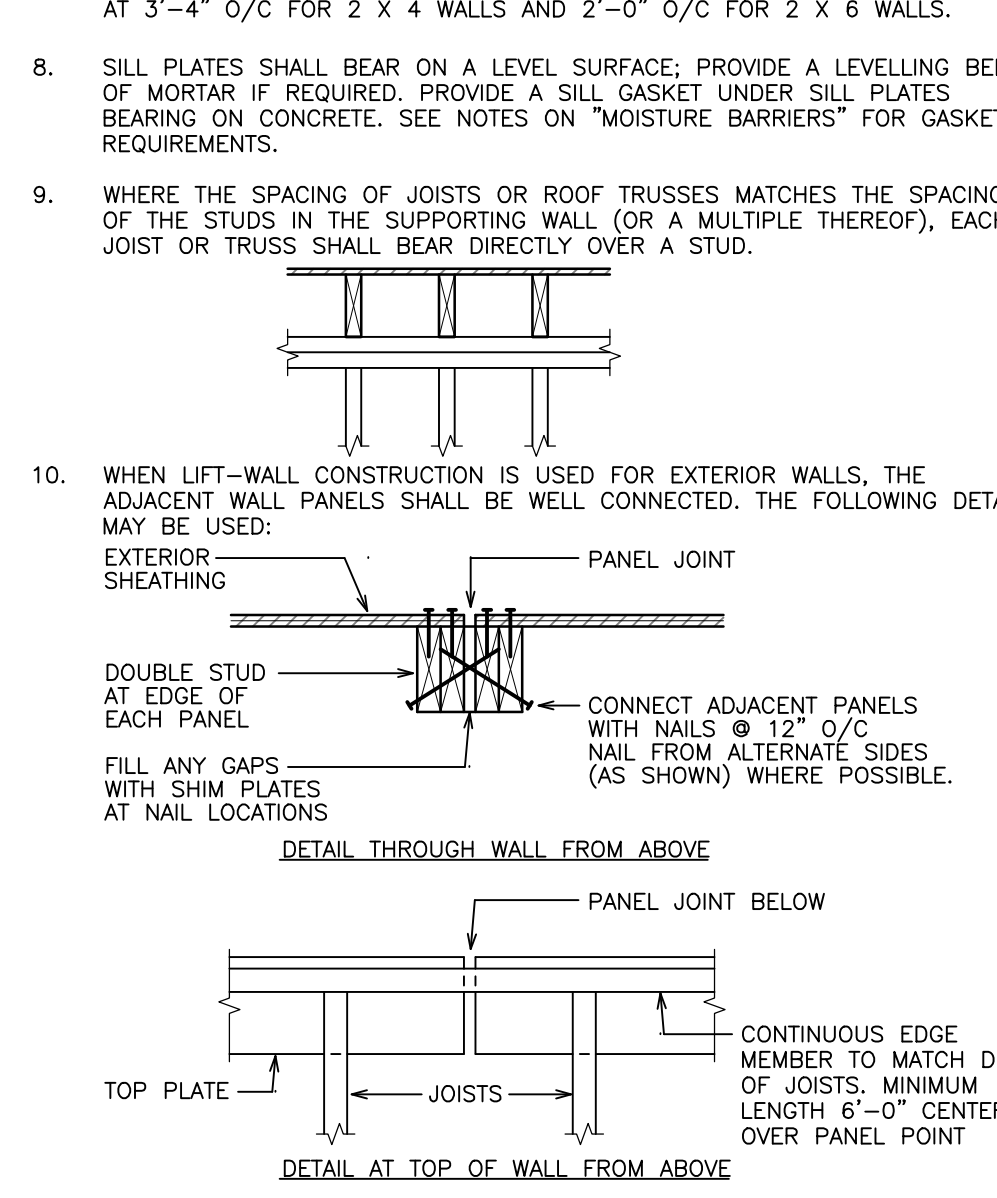


WOOD FRAMING cont.

MOISTURE BARRIERS

- 1. PROVIDE A MOISTURE BARRIER BETWEEN WOOD ELEMENTS AND ALL CONCRETE OR MASONRY.
2. DIMENSIONAL LUMBER JOISTS SHALL HAVE CROSS-BRIDGING OR FULL-DEPTH BLOCKING AT 6'-0" O/C ALONG THE SPAN FOR ALL SPANS GREATER THAN 12'-0".

JOISTS

- 1. REFER TO PLAN AND JOIST SCHEDULE FOR JOIST TYPE, SIZE, AND SPACING.
2. TRIM OPENINGS IN FLOORS AND ROOFS (I.E. STAIRS, FIREPLACES, SKYLIGHTS ETC) WITH DOUBLE JOISTS UNLESS NOTED OTHERWISE.

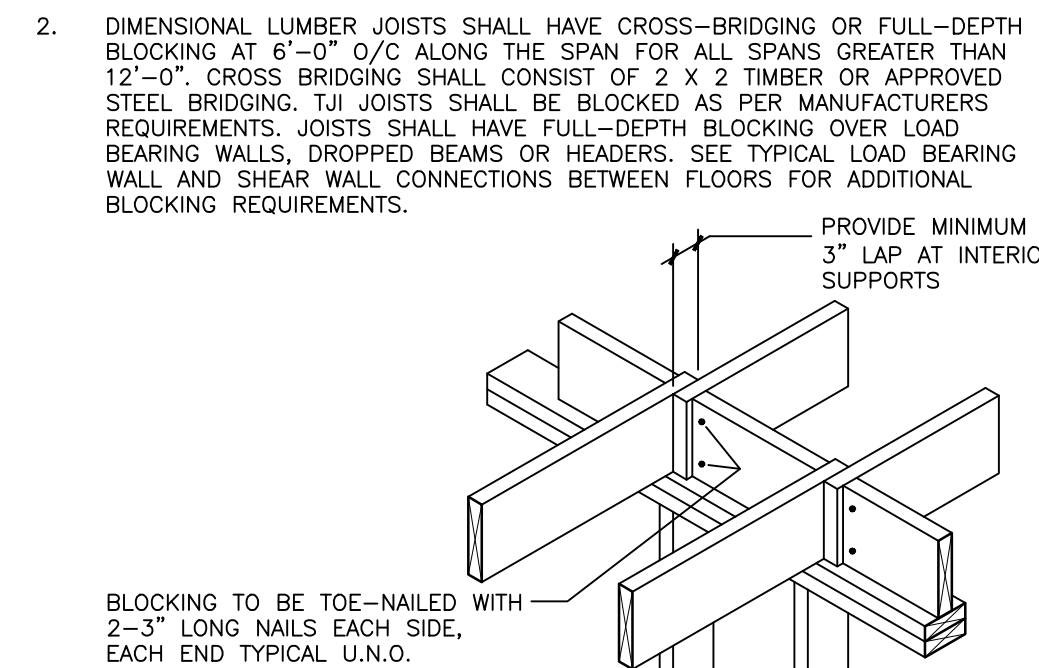

- 5. STAIRS AND STRINGERS SHALL BE FRAMED IN ACCORDANCE WITH THE BUILDING CODE PART 9, UNLESS NOTED OTHERWISE.


- 7. UNLESS NOTED OTHERWISE JOIST HANGERS OR FRAMING ANCHORS SHALL BE CAPABLE OF DEVELOPING THE SHEAR STRENGTH OF THE SUPPORTED MEMBER.

Table showing required shear resistance (lbs) for different joist sizes under working and factored loads.

- FOR I-JOISTS, HANGERS SHALL BE SPECIFIED ON ENGINEERED SHOP DRAWINGS PROVIDED BY THE JOIST SUPPLIER.

BEAMS

- 1. BUILT-UP BEAMS (I.E. 3-2 X 10) SHALL BE NAILED TOGETHER WITH 2 ROWS OF 3" NAILS.
2. FLUSH BEAMS
3. DROPPED BEAMS
4. U.N.O. ALL EXTERIOR WALL BEAMS, INTERIOR WALL BEAMS, AND DOOR HEADER BEAMS ARE DROPPED.
5. USE 2-2 X 10 BEAMS OVER ALL OPENINGS IN BEARING WALLS UNLESS NOTED OTHERWISE.

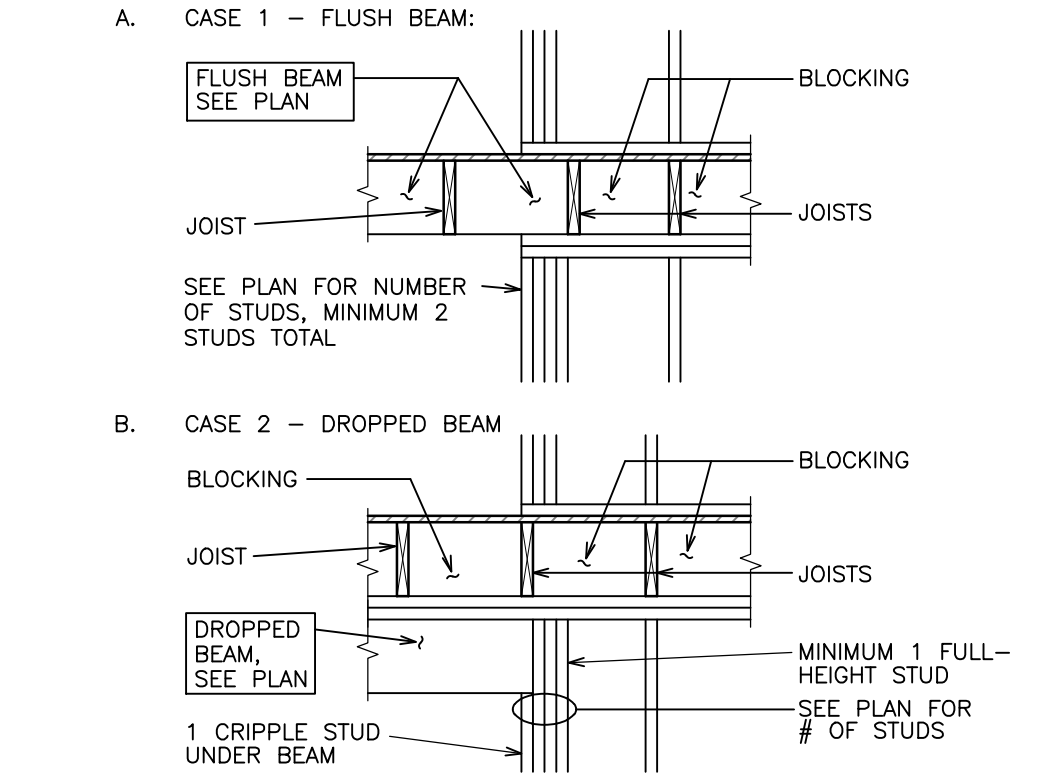

WOOD FRAMING

GENERAL

- 1. ALL DESIGN, DETAILS, MATERIALS AND CONSTRUCTION PROCEDURES SHALL CONFORM TO CURRENT EDITIONS OF THE FOLLOWING AS A MINIMUM:
- BRITISH COLUMBIA BUILDING CODE 2018 - PART 9
- CAN/CSA-086 - ENGINEERING DESIGN IN WOOD
- CSA 0121 - DOUGLAS FIR PLYWOOD
- CAN/CSA-10-4000 - PARALLAMS AND MICROLAMMS
- CAN/CSA-0122 - STRUCTURAL GLUED-LAMINATED TIMBER
- CAN/CSA-0177 - QUALIFICATION CODE FOR MANUFACTURERS OF STRUCTURAL GLUED-LAMINATED TIMBER
- CSA 0437 SERIES - STANDARDS FOR OSB AND WAFERBOARD
- CSA B111 - WIRE NAILS, SPIKES AND STAPLES
- CAN/CSA-B34 - MISCELLANEOUS BOLTS AND SCREWS
- CANADIAN WOOD-FRAME HOUSE CONSTRUCTION-CMHC
- WOOD DESIGN MANUAL - CANADIAN WOOD COUNCIL
- WOOD BUILDING TECHNOLOGY - CANADIAN WOOD COUNCIL
2. ANY CHANGES TO THE FRAMING SHOWN ON THESE DRAWINGS SHALL HAVE PRIOR WRITTEN APPROVAL OF RJC.
3. CONFIRM ALL DIMENSIONS AND OUTLINES WITH THE ARCHITECTURAL DRAWINGS.
4. ANY TIMBER NOT GRADE MARKED WILL BE REJECTED.
5. FINISHES SHALL BE DETAILED TO ACCOMMODATE SHRINKAGE OF THE TIMBER OVER TIME.
6. DO NOT COVER WOOD FRAMING WITH FINISHES UNTIL RJC'S FRAMING REVIEW IS COMPLETE.
7. NOTCHING AND DRILLING OF STRUCTURAL ELEMENTS SHALL FOLLOW THE GUIDELINES SET FORTH IN THE BUILDING CODE PART 9.
8. ALL TIMBER ELEMENTS ARE DESIGNED FOR DRY-SERVICE CONDITIONS.
9. ALL WOOD FRAME CONSTRUCTION SHALL SATISFY THE FOLLOWING CONSTRUCTION TOLERANCES AS A MINIMUM.

MATERIALS

- 1. STUDS AND BUILT-UP POSTS TO BE S-P-F #2 GRADE OR BETTER.
2. JOISTS TO BE S-P-F #2 GRADE OR BETTER.
3. BUILT-UP BEAMS AND HEADERS TO BE S-P-F #2 GRADE OR BETTER.
4. WALL PLATES TO BE S-P-F #3/STUD GRADE WALL PLATES SHALL BE KILN-DRIED AND MAY BE FINGER JOINTED EXCEPT IN SHEAR WALLS.
5. POSTS AND BEAMS TO BE S-P-F #2 GRADE OR BETTER.
6. ALL DIMENSION LUMBER TO BE SURFACED FOUR SIDES ('S4S').
7. PLYWOOD TO BE DOUGLAS FIR SHEATHING GRADE.
8. O.S.B. TO CONFORM TO CSA 0325.
9. TIMBER CONNECTION HARDWARE TO BE SIMPSON STRONG-TIE, OR EQUIVALENT APPROVED BY RJC.
10. NAILS SHALL BE COMMON ROUND STEEL WIRE NAILS.

Table showing length, diameter, and penny-weight for various sizes of nails.

- NOTE: SPIRAL OR PNEUMATIC NAILS MAY BE USED IF THEY CONFORM TO THE TABLE ABOVE.


- 11. MISCELLANEOUS STEEL TO BE CSA G40.21 OR APPROVED EQUAL.
12. ANCHOR RODS SHALL BE ASTM F1554 GRADE 36, ASTM A36, OR APPROVED EQUIVALENT.
13. BOLTS SHALL BE ASTM A307 OR APPROVED EQUAL.
14. MOISTURE CONTENT OF ALL TIMBER ELEMENTS SHALL NOT EXCEED 19% AT THE TIME OF CONSTRUCTION OR FABRICATION.
15. ALL FASTENERS AND CONNECTION HARDWARE THROUGH PRESERVATIVE TREATED MATERIALS OR OUTSIDE OF THE MOISTURE BARRIER TO BE HOT DIPPED GALVANIZED OR STAINLESS STEEL AS SPECIFIED.

NAILING

- 1. NAILING SHALL CONFORM TO THE BUILDING CODE PART 9, AND 'WOOD BUILDING TECHNOLOGY' PUBLISHED BY THE CANADIAN WOOD COUNCIL.
2. UNLESS NOTED OTHERWISE NAIL ALL WALL, FLOOR AND ROOF SHEATHING WITH 2 1/2" NAILS AT 6" O/C AT SUPPORTED EDGES OF SHEATHING SHEETS.
3. DO NOT USE PNEUMATICALLY DRIVEN NAILS IN SHEAR WALL SHEATHING UNLESS THE NAILS MEET THE LENGTH AND DIAMETER OF NOTE 10 UNDER MATERIALS.

WALLS cont.

- 8. UNLESS NOTED OTHERWISE, ALL RETAINING WALLS BELOW GRADE AND ALL EXTERIOR WALLS EXPOSED TO THE WEATHER ABOVE GRADE SHALL HAVE CONTROL JOINTS.
9. UNLESS NOTED OTHERWISE FOR EXTERIOR WALLS BELOW GRADE AND EXTERIOR WALLS EXPOSED TO WEATHER ABOVE GRADE.

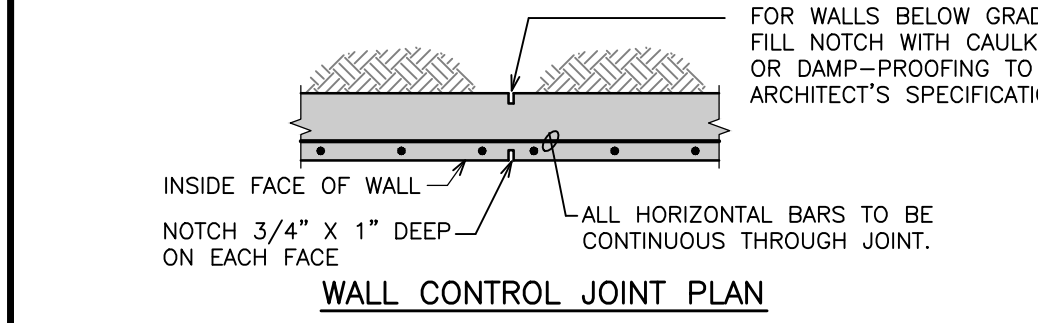

EMBEDMENT / DEVELOPMENT LENGTHS AND SPLICE LENGTHS

BASED ON CSA A23.3 WHERE EMBEDMENT OR SPLICES ARE DIMENSIONED ON THE DRAWINGS, SUCH DIMENSION SHALL APPLY. WHERE NO EMBEDMENT OR EMBEDMENT TYPE IS CALLED FOR ON THESE DRAWINGS, IT SHALL BE PER THE TABLE BELOW.

Table showing embedment and splice conditions for concrete strength and rebar designation.

POST-INSTALLED ADHESIVE AND MECHANICAL ANCHORS

- 1. MECHANICAL ANCHORS TO MEET THE ASSESSMENT CRITERIA OF ACI 355.2.
2. ADHESIVE ANCHORS TO MEET THE ASSESSMENT CRITERIA OF ACI 355.4.
3. EXCEPT WHERE NOTED OTHERWISE ON THE DRAWINGS, ANCHORS SHALL CONSIST OF THE FOLLOWING ANCHOR TYPES AS PROVIDED BY HILTI (CANADA) LTD.
4. ANCHOR CAPACITY USED IN DESIGN IS BASED ON ICC TEST REPORT DATA AND GUIDELINES PUBLISHED BY HILTI.
5. ALTERNATE FASTENING SYSTEMS PROPOSED BY THE CONTRACTOR SHALL BE SUBMITTED TO THE STRUCTURAL ENGINEER FOR REVIEW AND APPROVAL.

INSTALLATION

- 7. INSTALL ANCHORS PER THE MANUFACTURER'S INSTRUCTIONS.
8. DO NOT CUT REINFORCING BARS TO INSTALL ANCHORS UNLESS THE STRUCTURAL DRAWINGS SPECIFICALLY NOTE FOR A PARTICULAR DETAIL.
9. EXISTING REINFORCING BARS IN THE CONCRETE OR MASONRY STRUCTURE MAY CONFLICT WITH SPECIFIC ANCHOR LOCATIONS.
10. AT LOCATIONS OF INTERFERENCE BETWEEN CONCRETE ANCHORS AND EXISTING REINFORCEMENT, ADJUST PROPOSED LOCATIONS OF ANCHORS AS REQUIRED TO AVOID CUTTING REINFORCEMENT.

ON-SITE TRAINING AND CERTIFICATION

- 12. ALL PERSONNEL WHO INSTALL ANCHORS MUST HAVE RECEIVED TRAINING WITHIN THE PREVIOUS 12 MONTHS FOR THE SPECIFIC ANCHOR SYSTEM TO BE UTILIZED.
13. AT RJC'S DISCRETION, AN ANCHOR THAT APPEARS TO BE SUSPECT MAY BE SUBJECT TO PROOF LOAD TESTING, TO BE PAID FOR AT THE CONTRACTOR'S EXPENSE.

REVIEW AND TESTING OF ANCHORS

Read Jones Christoffersen Ltd. 1515 Douglas Street, Suite 330 Victoria, BC V8W 2G4 Canada tel 250-386-7794 rjc.ca

Table with columns: No., Revision, Date, By. Rows include Issued For Variance Application and Re-issued for Delegated Development Permit.

- Drawing Notes
1. All drawings, plans, models, designs, specifications and other documents prepared by Read Jones Christoffersen Ltd. ('RJC') and used in connection with this project are instruments of service for the work shown in them.
2. These drawings are 'design drawings' only. They may not be suitable for use as shop drawings.
3. Use of these drawings is limited to that identified in the Revision column.

EGBC Permit to Practice No. 1002503

READ RESIDENCE - GARDEN SUITE

965 COWICHAN STREET, VICTORIA BC



GENERAL NOTES AND TYPICAL DETAILS

Drawn By LL Scale AS SHOWN
Designed By DW Date AUGUST 5, 2023
RJC Project Number VIC.132898.0001


Sheet Number S1.2 Revision

WOOD FRAME SCHEDULE					
WOOD BEAM SCHEDULE			WOOD JOIST SCHEDULE		
MARK	SIZE	TYPE	MARK	SIZE	TYPE
B1	2 x 6	SL	B5	1 3/4" x 9 1/2"	LVL
B2	2 x 8	SL	B6	1 3/4" x 11 3/8"	LVL
B3	2 x 10	SL			
B4	2 x 12	SL			
WOOD POST SCHEDULE			ENGINEERED I-JOIST		
MARK	SIZE	TYPE	MARK	SIZE	TYPE
P1	2 x 4	SL	TJ1	11 7/8" DEEP	I-JOIST
P2	2 x 6	SL			
P3	4 x 4	SL			
P4	6 x 6	SL			


- NOTES:
- FLOOR OR ROOF FRAMING SHOWN ON THIS PLAN IS FOR THE LEVEL ABOVE. DOOR AND WINDOW HEADERS SHOWN ARE OVER THE DOOR AND WINDOW AT THIS LEVEL.
 - SEE PLAN FOR NUMBER OF LAMINATIONS REQUIRED. EXAMPLE: 3B1 = 3 - 2x6 MEMBERS
 - ABBREVIATIONS:
 SL - SAWN LUMBER LSL - LAMINATED STRAND LUMBER
 PSL - PARALLEL STRAND LUMBER LVL - LAMINATED VENEER LUMBER

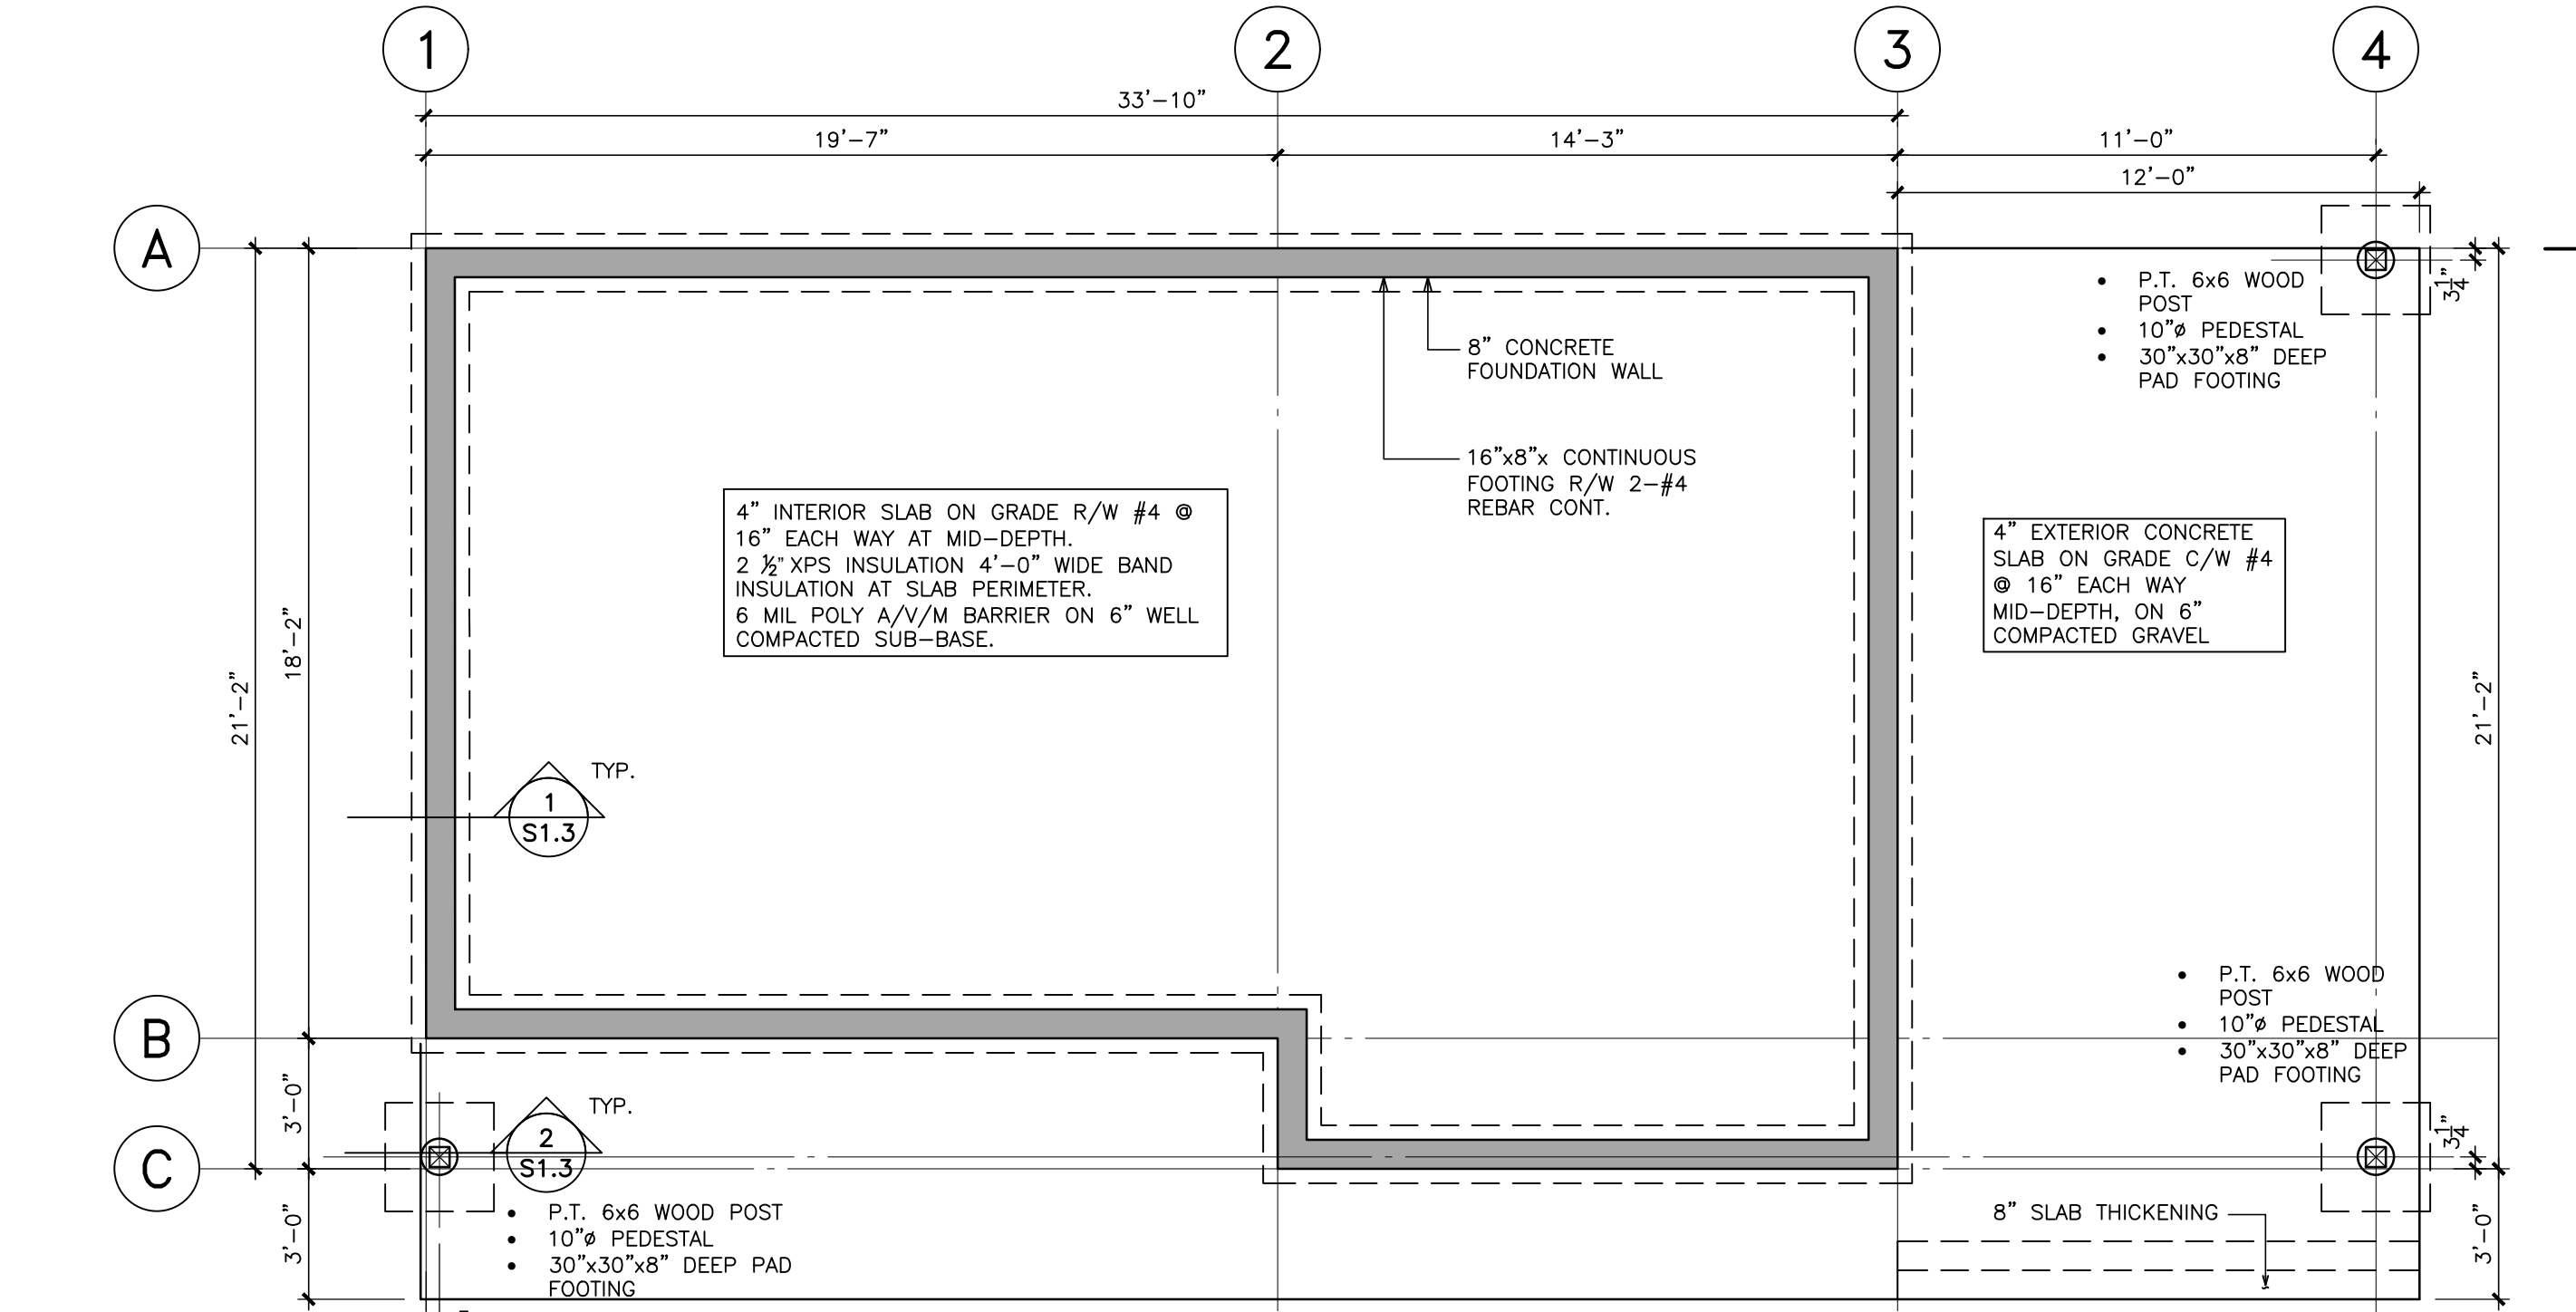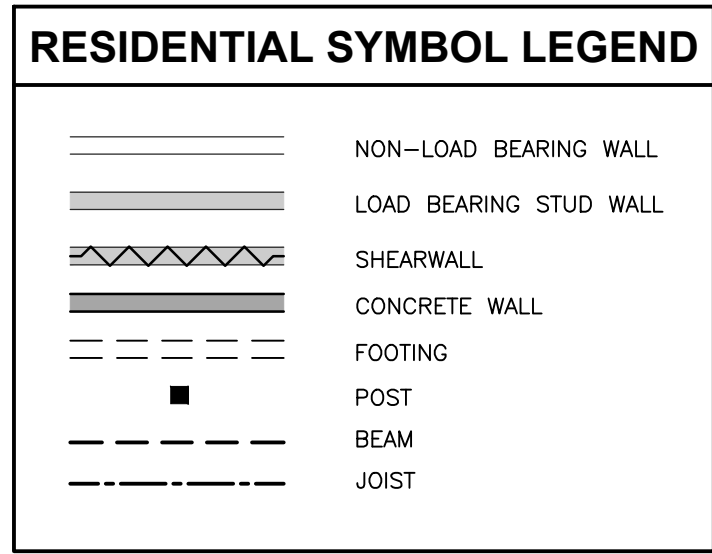


A
S1.3
1/4" = 1'-0"

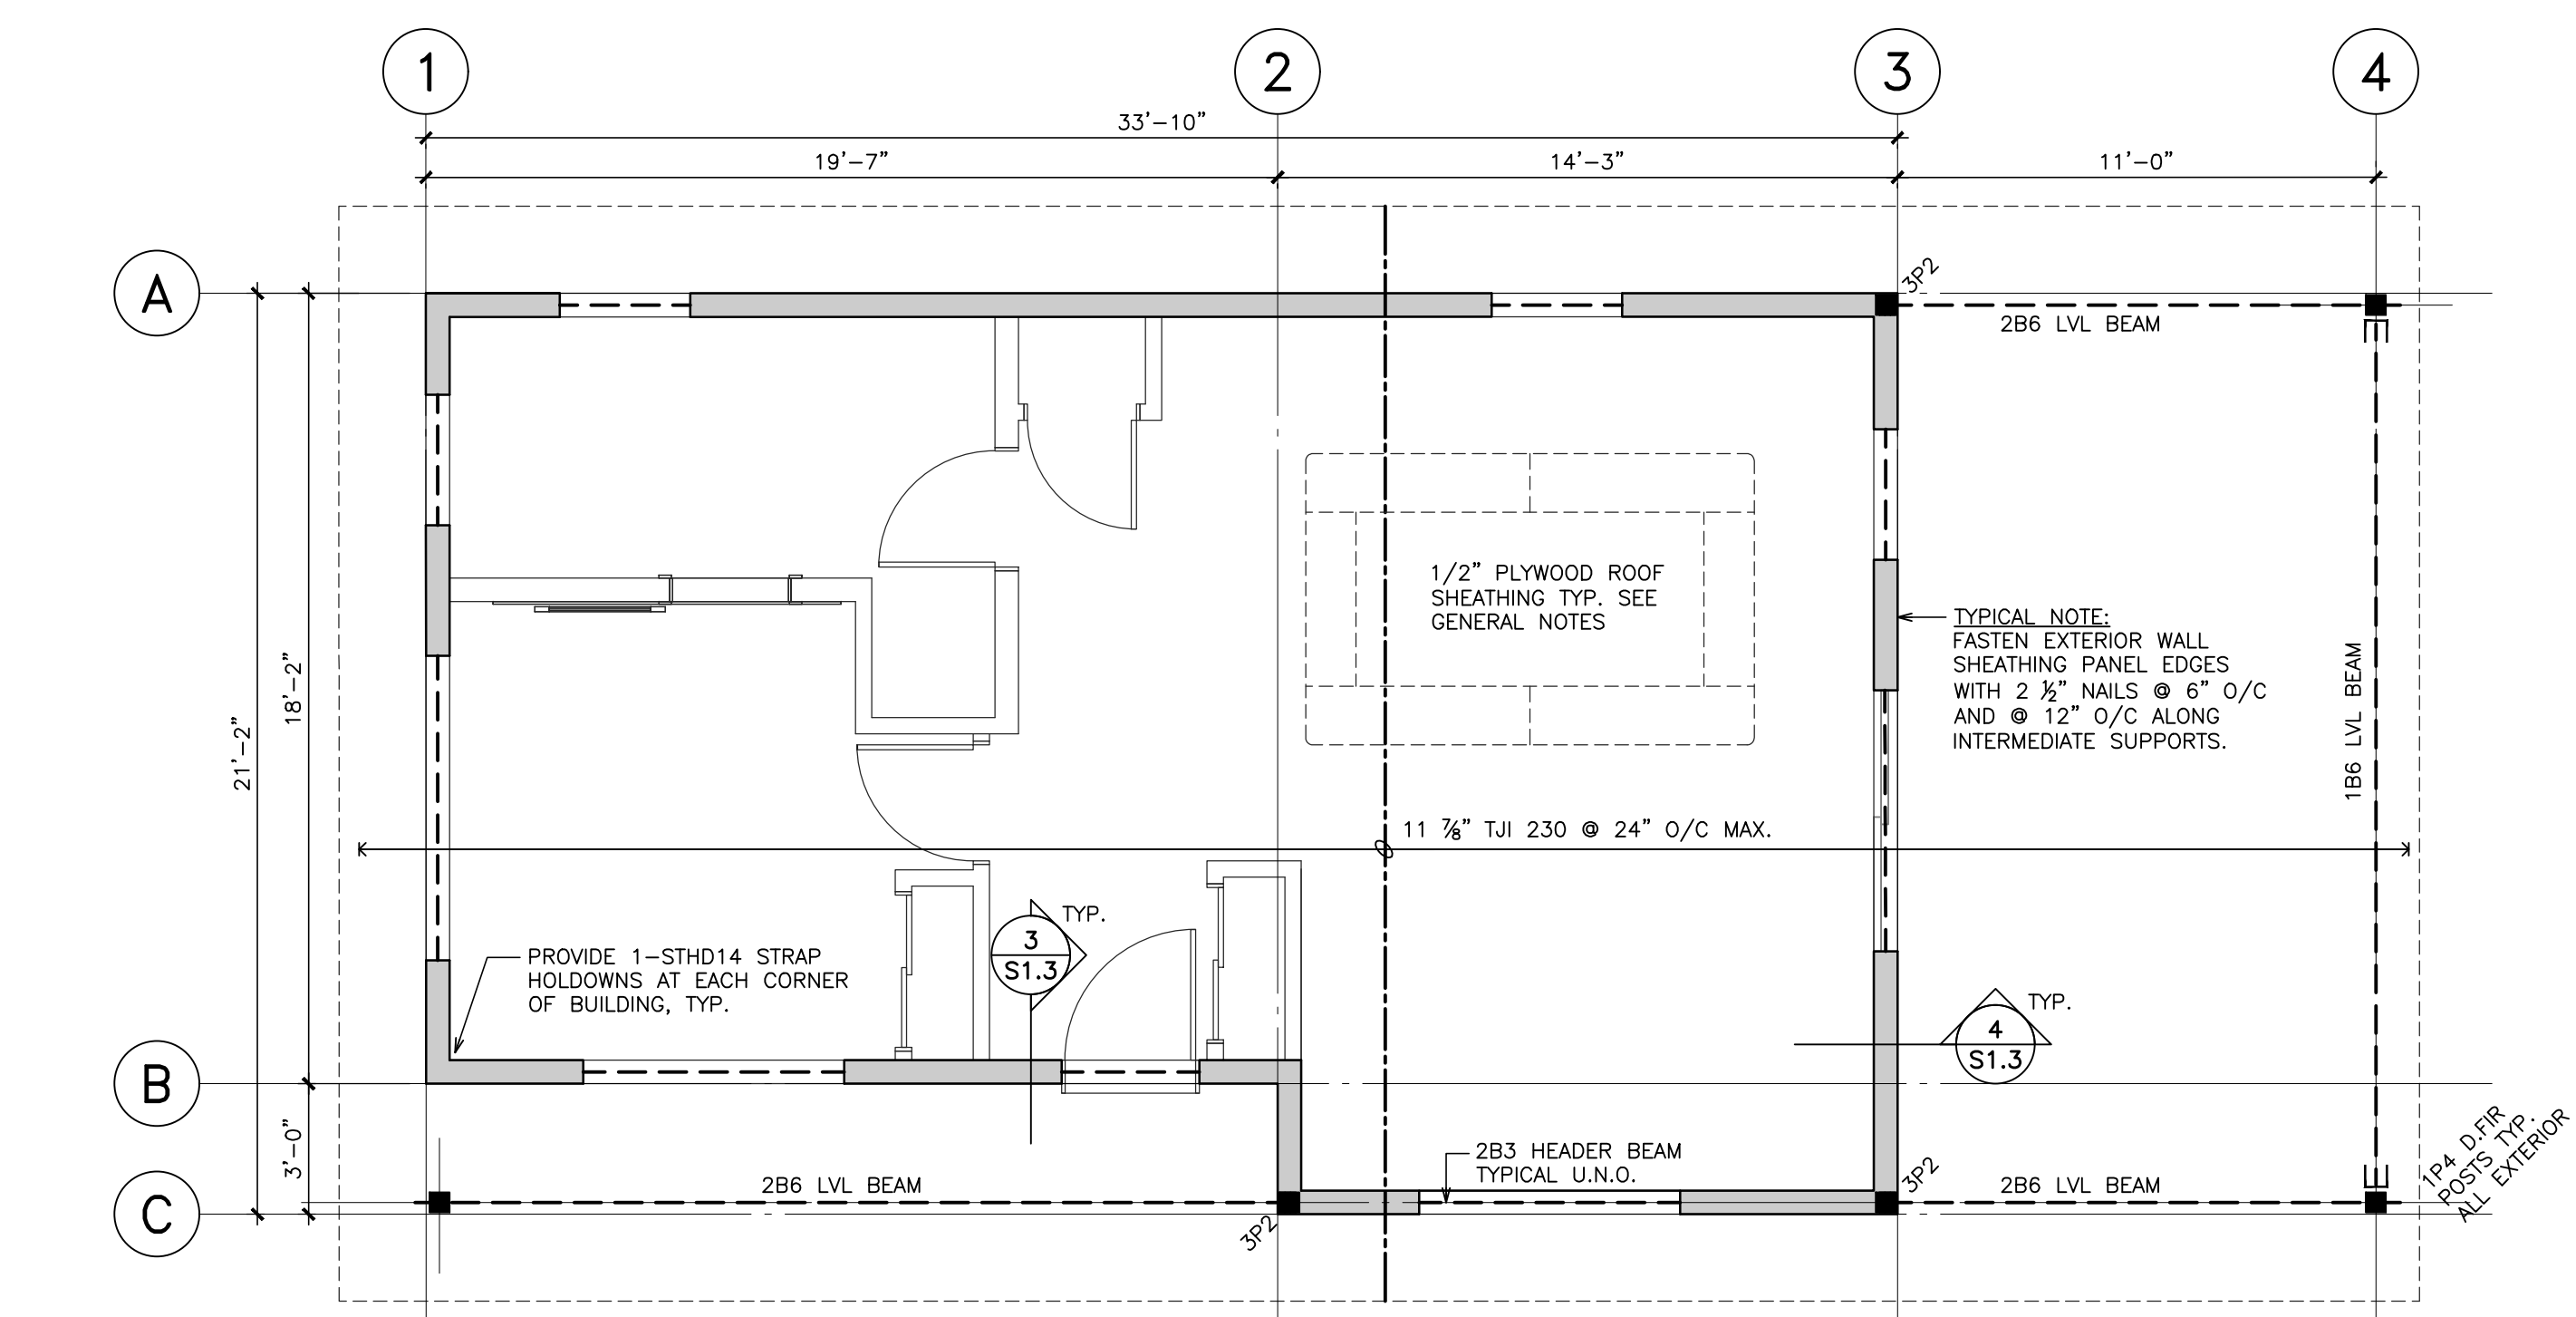


B
S1.3
1/4" = 1'-0"

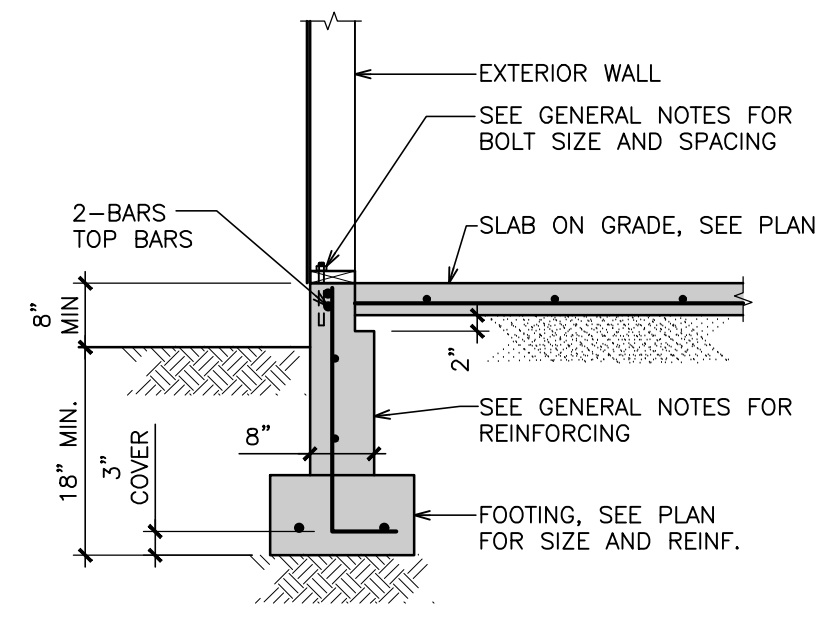


1
S1.3
1/2" = 1'-0"

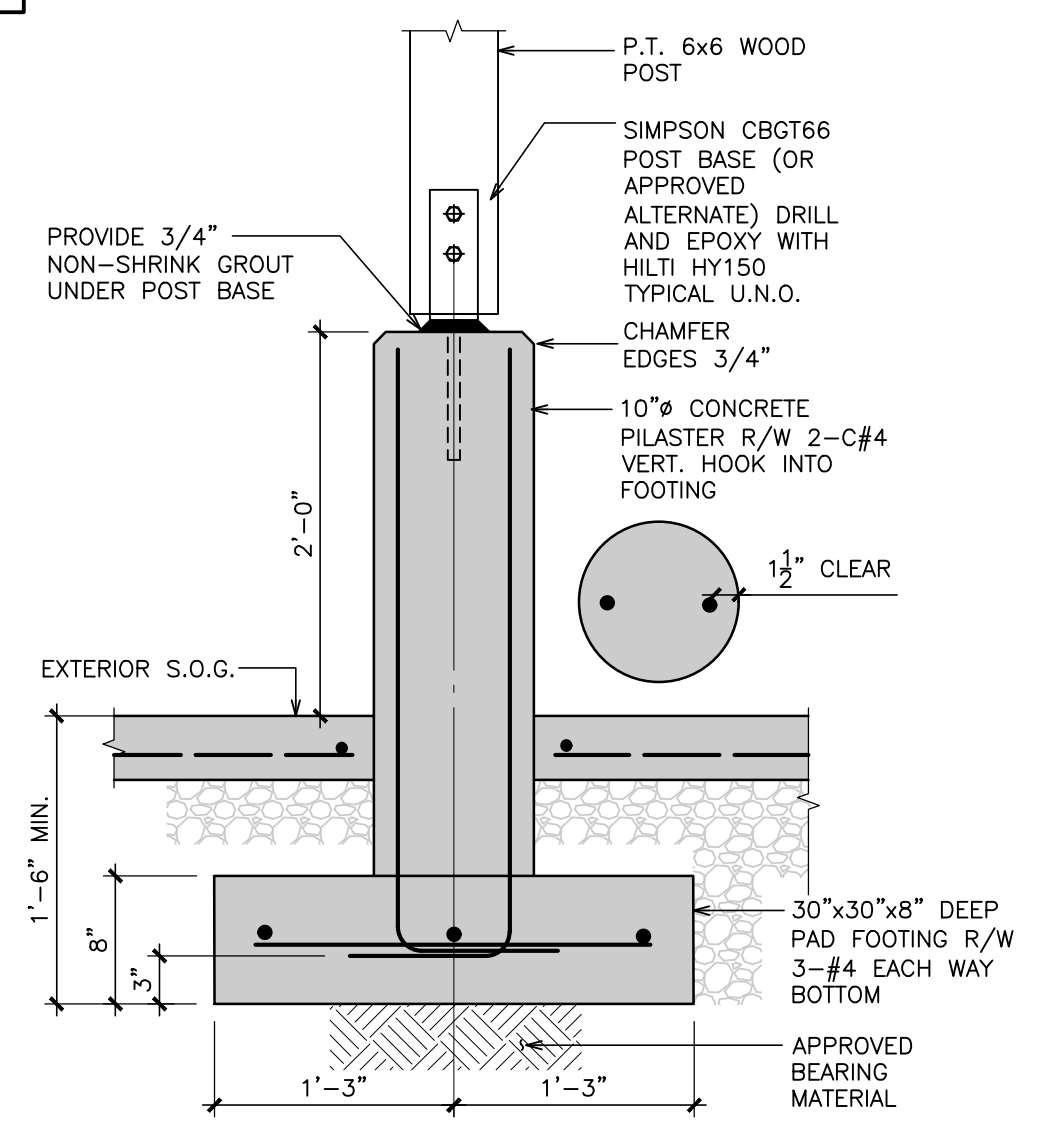

2
S1.3
1" = 1'-0"

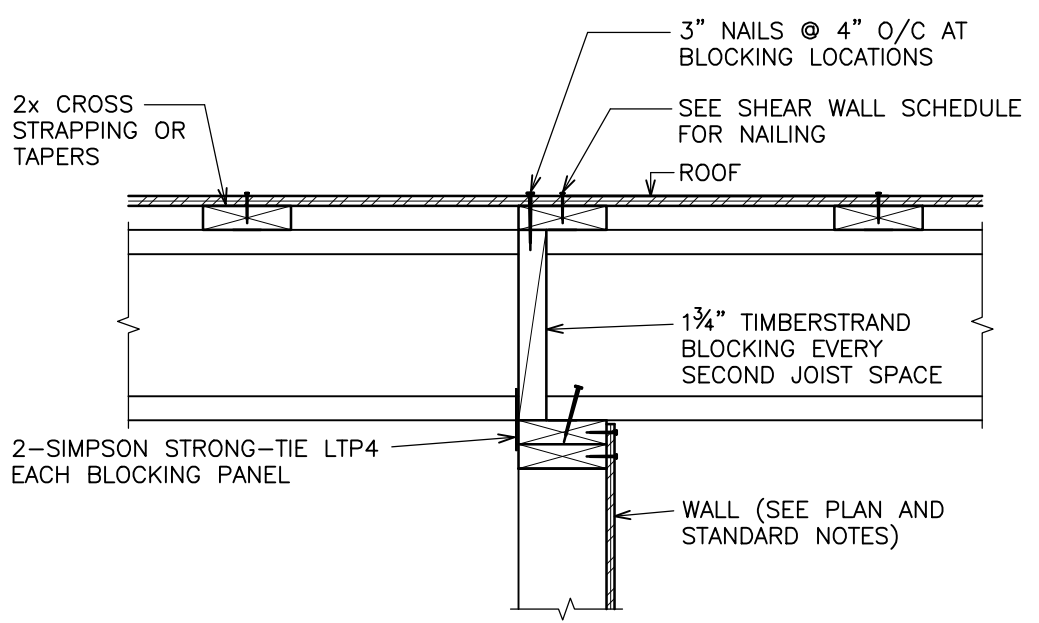

3
S1.3
1" = 1'-0"

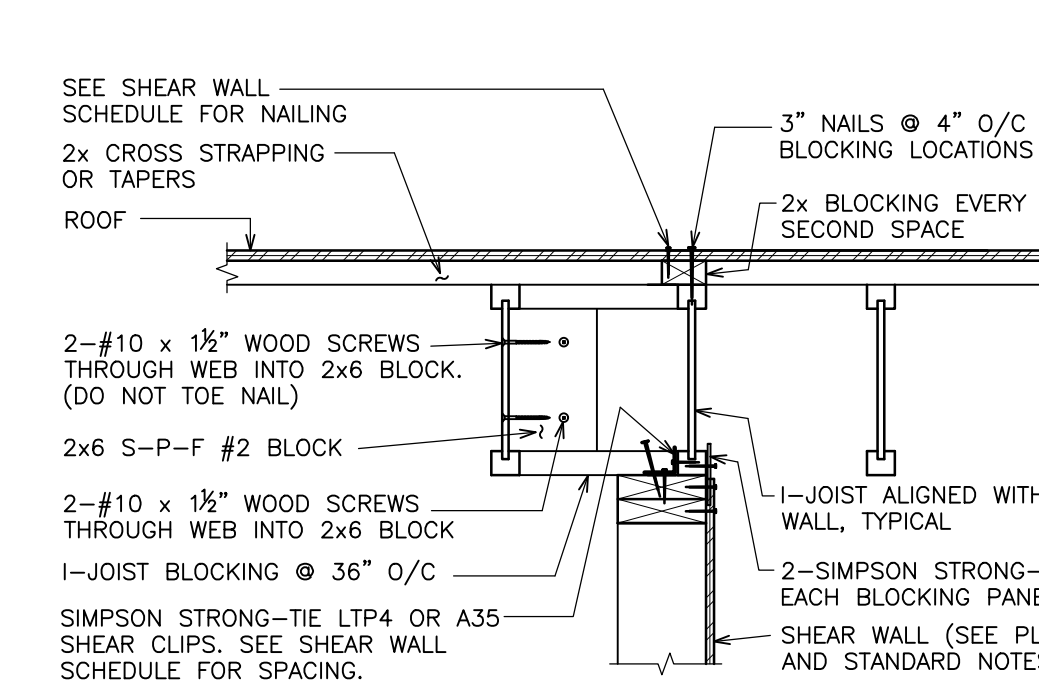

4
S1.3
1" = 1'-0"

WOOD FRAMING cont.

ENGINEERED WOOD PRODUCTS (E.W.P.)

- ENGINEERED WOOD PRODUCTS INCLUDE ALL PRE-MANUFACTURED BEAMS, COLUMNS, AND I-JOISTS SHOWN ON PLAN.
- BEAMS EXPOSED TO VIEW IN FINISHED BUILDING SHALL BE SANDED APPEARANCE GRADE WITH STAMPS IN COVERED LOCATIONS.
- SIZES OF BEAMS AND POSTS SHALL BE AS SPECIFIED ON PLAN.
- BEAMS: MINIMUM STRENGTHS OF BEAMS AS SPECIFIED ON PLAN:

TRUS JOIST MACMILLAN DESIGNATION	MODULUS OF ELASTICITY	SHEAR RESISTANCE (F _v)	BENDING RESISTANCE (F _b)	BEARING RESISTANCE (F _{cp})
PSL	2.2E (2200 KSI)	540 PSI	5360 PSI	1365 PSI
LSL	1.5E (1500 KSI)	745 PSI	4200 PSI	1450 PSI
LVL	2.0E (2000 KSI)	530 PSI	4805 PSI	1365 PSI

BEAM DEFLECTIONS ARE TO BE LIMITED TO LIVE LOAD SPAN/480 AND TOTAL LOAD SPAN/240.

- PSL - PARALLAM BEAM
- LSL - TIMBERSTRAND BEAM
- LVL - LAMINATED VENEER LUMBER

- COLUMNS: COLUMNS SHALL BE PSL 1.8E BY TRUS JOIST MACMILLAN OR PRE-APPROVED EQUIVALENT.

- I-JOISTS (INTERIOR USE ONLY):

- A. I-JOISTS TO BE TJI BY TRUS JOIST MACMILLAN OR PRE-APPROVED EQUIVALENT. JOISTS SHALL BE BLOCKED AND NAILED AS PER MANUFACTURER'S REQUIREMENTS IN ADDITION TO THE GENERAL NOTES.
- B. THE I-JOISTS SHALL BE DESIGNED FOR THE LOADS SPECIFIED IN THE GENERAL NOTES, OR AS SHOWN ON PLAN. SNOW LOADS SHALL BE BASED ON PART 9 OF THE BUILDING CODE, INCLUDING THE EFFECT OF SLIDING OR DRIFTING SNOW, PLUS ANY ADDITIONAL REQUIREMENTS SET OUT IN THE LOCAL BUILDING BY-LAW.
- C. I-JOIST SUPPLIER MUST DESIGN AND SUPPLY THE ENTIRE FLOOR SYSTEM WHICH INCLUDES THE FOLLOWING ELEMENTS:
 - JOIST HANGERS AND CONNECTING HARDWARE.
 - BRIDGING AND BLOCKING.
 - RIM/BOX JOISTS.
 - SQUASH BLOCKS AND WEB STIFFENERS.
- D. I-JOIST SUPPLIER SHALL SUBMIT SHOP DRAWINGS OF THIS SYSTEM SIGNED AND SEALED BY A PROFESSIONAL ENGINEER REGISTERED IN THE PROVINCE OF BRITISH COLUMBIA, TO THE ENGINEER OF RECORD AND ARCHITECT FOR REVIEW.
- E. SHOP DRAWINGS SHALL INCLUDE THE FOLLOWING ELEMENTS:
 - PLAN LAYOUT SHOWING ALL JOISTS AND BEAMS WITH THEIR DIRECTIONS AND SPACING.
 - LOADS USED IN DESIGN OF FLOOR SYSTEM.
 - ALL HANGERS AND CONNECTING HARDWARE.
 - ALL (E.W.P.) BEAMS, BLOCKING, RIM BOARD, POSTS, SQUASH BLOCKING, WEB STIFFENERS, AND CROSS BRIDGING.
 - MATERIAL STRENGTHS AND SPECIFICATIONS.

- F. I-JOIST SUPPLIER SHALL PROVIDE PERIODIC FIELD REVIEW OF THE INSTALLATION OF THE ENGINEERED FLOOR SYSTEM TO ASCERTAIN COMPLIANCE WITH THE SHOP DRAWINGS. COPIES OF THE FIELD REVIEW INSPECTION REPORTS SHALL BE FORWARDED TO THE ENGINEER OF RECORD.
- G. I-JOIST SUPPLIER SHALL SUBMIT A LETTER ATTESTING TO THE SUCCESSFUL COMPLETION AND INSTALLATION OF ALL ELEMENTS IN COMPLIANCE WITH THE E.W.P. SHOP DRAWINGS TO THE ENGINEER OF RECORD. THIS LETTER SHALL BE SIGNED AND SEALED BY A PROFESSIONAL ENGINEER REGISTERED IN THE PROVINCE OF BRITISH COLUMBIA.
- H. I-JOIST SPACING SHALL NOT EXCEED 16" O/C FOR FLOORS AND 24" O/C FOR NON-OCCUPIED ROOFS.
- I. I-JOISTS SHALL MEET A MINIMUM DEFLECTION OF SPAN/480 FOR LIVE LOAD AND SPAN/240 FOR TOTAL LOAD. JOISTS SHALL ALSO BE DESIGNED IN ACCORDANCE WITH THE APPROPRIATE BUILDING CODE FOR VIBRATION CONTROL.
- J. FLOOR JOIST SYSTEM SHALL MEET THE U.L.C. AND S.T.C. RATINGS FOR THE FLOOR ASSEMBLY. REFER TO ARCHITECTURAL DRAWINGS FOR REQUIRED RATINGS.

- DO NOT CUT, NOTCH, OR DAMAGE I-JOIST FLANGES.
- REFER TO MANUFACTURER'S SPECIFICATIONS FOR ALLOWABLE HOLES THROUGH JOIST WEBS.
- PROVIDE AS A MINIMUM 5/8" PLYWOOD WEB STIFFENER TO EACH SIDE OF I-JOIST. ALL LOCATIONS WHERE I-JOISTS ARE CONTINUOUS OVER SUPPORTS AND THE SUPPORT WIDTH IS LESS THAN 5 1/4" WIDE. REFER ALSO TO MANUFACTURER'S SPECIFICATIONS FOR WEB STIFFENERS.
- PRODUCT SUBSTITUTIONS MUST BE PRE-APPROVED.
- DO NOT SUBSTITUTE BUILT-UP MEMBERS OF SAWN TIMBER FOR ENGINEERED WOOD PRODUCTS.
- PARALLAMS USED IN EXTERIOR APPLICATIONS SHALL MEET THE EXPOSURE REQUIREMENTS SPECIFIED BY THE MANUFACTURER. DO NOT USE MICROLAMS.
- ALL E.W.P. SHALL BE KEPT DRY AND PROTECTED FROM THE ENVIRONMENT DURING STORAGE ON OR OFF THE PROJECT SITE AS PER THE MANUFACTURER'S REQUIREMENTS. STORE MATERIAL ELEVATED FROM GROUND AND WRAPPED TO SHED MOISTURE.
- ALL STEEL CONNECTIONS/HARDWARE USED FOR CONNECTING BEAMS SHALL BE CAPABLE OF CARRYING THE SHEAR STRENGTH OF THE MEMBER.

SHOP DRAWINGS TO BE SUBMITTED TO RJC PRIOR TO ORDERING AND INSTALLATION

DRAWING TYPE	REQUIRED	SUBMITTED
ENGINEERED TRUSSES	<input type="checkbox"/>	<input type="checkbox"/>
ENGINEERED ROOF SYSTEMS	<input checked="" type="checkbox"/>	<input type="checkbox"/>
GLULAM	<input type="checkbox"/>	<input type="checkbox"/>
STEEL	<input type="checkbox"/>	<input type="checkbox"/>
GUARDRAIL	<input type="checkbox"/>	<input type="checkbox"/>

NOTE: OTHER SHOP DRAWINGS MAY BE REQUIRED BY OTHER DISCIPLINES THAT DO NOT AFFECT THE BASE BUILDING AND ARE NOT REQUIRED BY RJC. REFER TO THE GENERAL NOTES FOR REQUIRED INFORMATION TO BE SUBMITTED.

No.	Revision	Date	By
3	Issued For Variance Application	2023/09/05	LL
2	Re-issued for Delegated Development Permit	2023/06/29	LL
1	Delegated Development Permit	2022/10/3	LL

- Drawing Notes
- All drawings, plans, models, designs, specifications and other documents prepared by Read Jones Christoffersen Ltd. ("RJC") and used in connection with this project are instruments of service for the work shown in them ("Work") and as such are and remain the property of RJC whether the Work is executed or not, and RJC reserves the copyright in them and in the Work, executed from them, and they shall not be used for any other work or project.
 - These drawings are "design drawings" only. They may not be suitable for use as shop drawings. Use of these drawings as base drawings for "shop drawings" is not permitted unless written permission containing certain conditions and limitations is obtained from RJC. The work "as constructed" may vary from what is shown on these drawings.
 - Use of these drawings is limited to that identified in the Revision column. Do not construct from these drawings unless marked "Issued for Construction" by RJC in the Revision column, and then only for the parts noted. The drawings shall not be used for "pricing", "costing", or "tender" unless so indicated in the Revision column. "Pricing" or "Costing" drawings are not complete and any prices based on such drawings must allow for this.

Seal

EGBC Permit to Practice No. 1002503

Project Name

READ RESIDENCE - GARDEN SUITE

965 COWICHAN STREET, VICTORIA BC

Sheet Title

GENERAL NOTES, TYPICAL DETAILS AND PLANS

Drawn By LL Scale AS SHOWN

Designed By DW Date AUGUST 5, 2023

RJC Project Number VIC.132898.0001


Sheet Number _____ Revision _____

S1.3

Drawing Notes

All drawings, plans, models, designs, specifications and other documents prepared by Lane Design and used in connection with this project are instruments of service for the work shown in them (the "Work") and as such are and remain the property of Lane Design whether the Work is executed or not, and Lane Design reserves the copyright in them and in the Work executed from them, and they shall not be used for any other work or project.

The general contractor is responsible for confirming and correlating dimensions at the job site. The designer will not be responsible for construction means, methods, techniques, sequences or procedures, or safety precautions and programs in connection with the project.

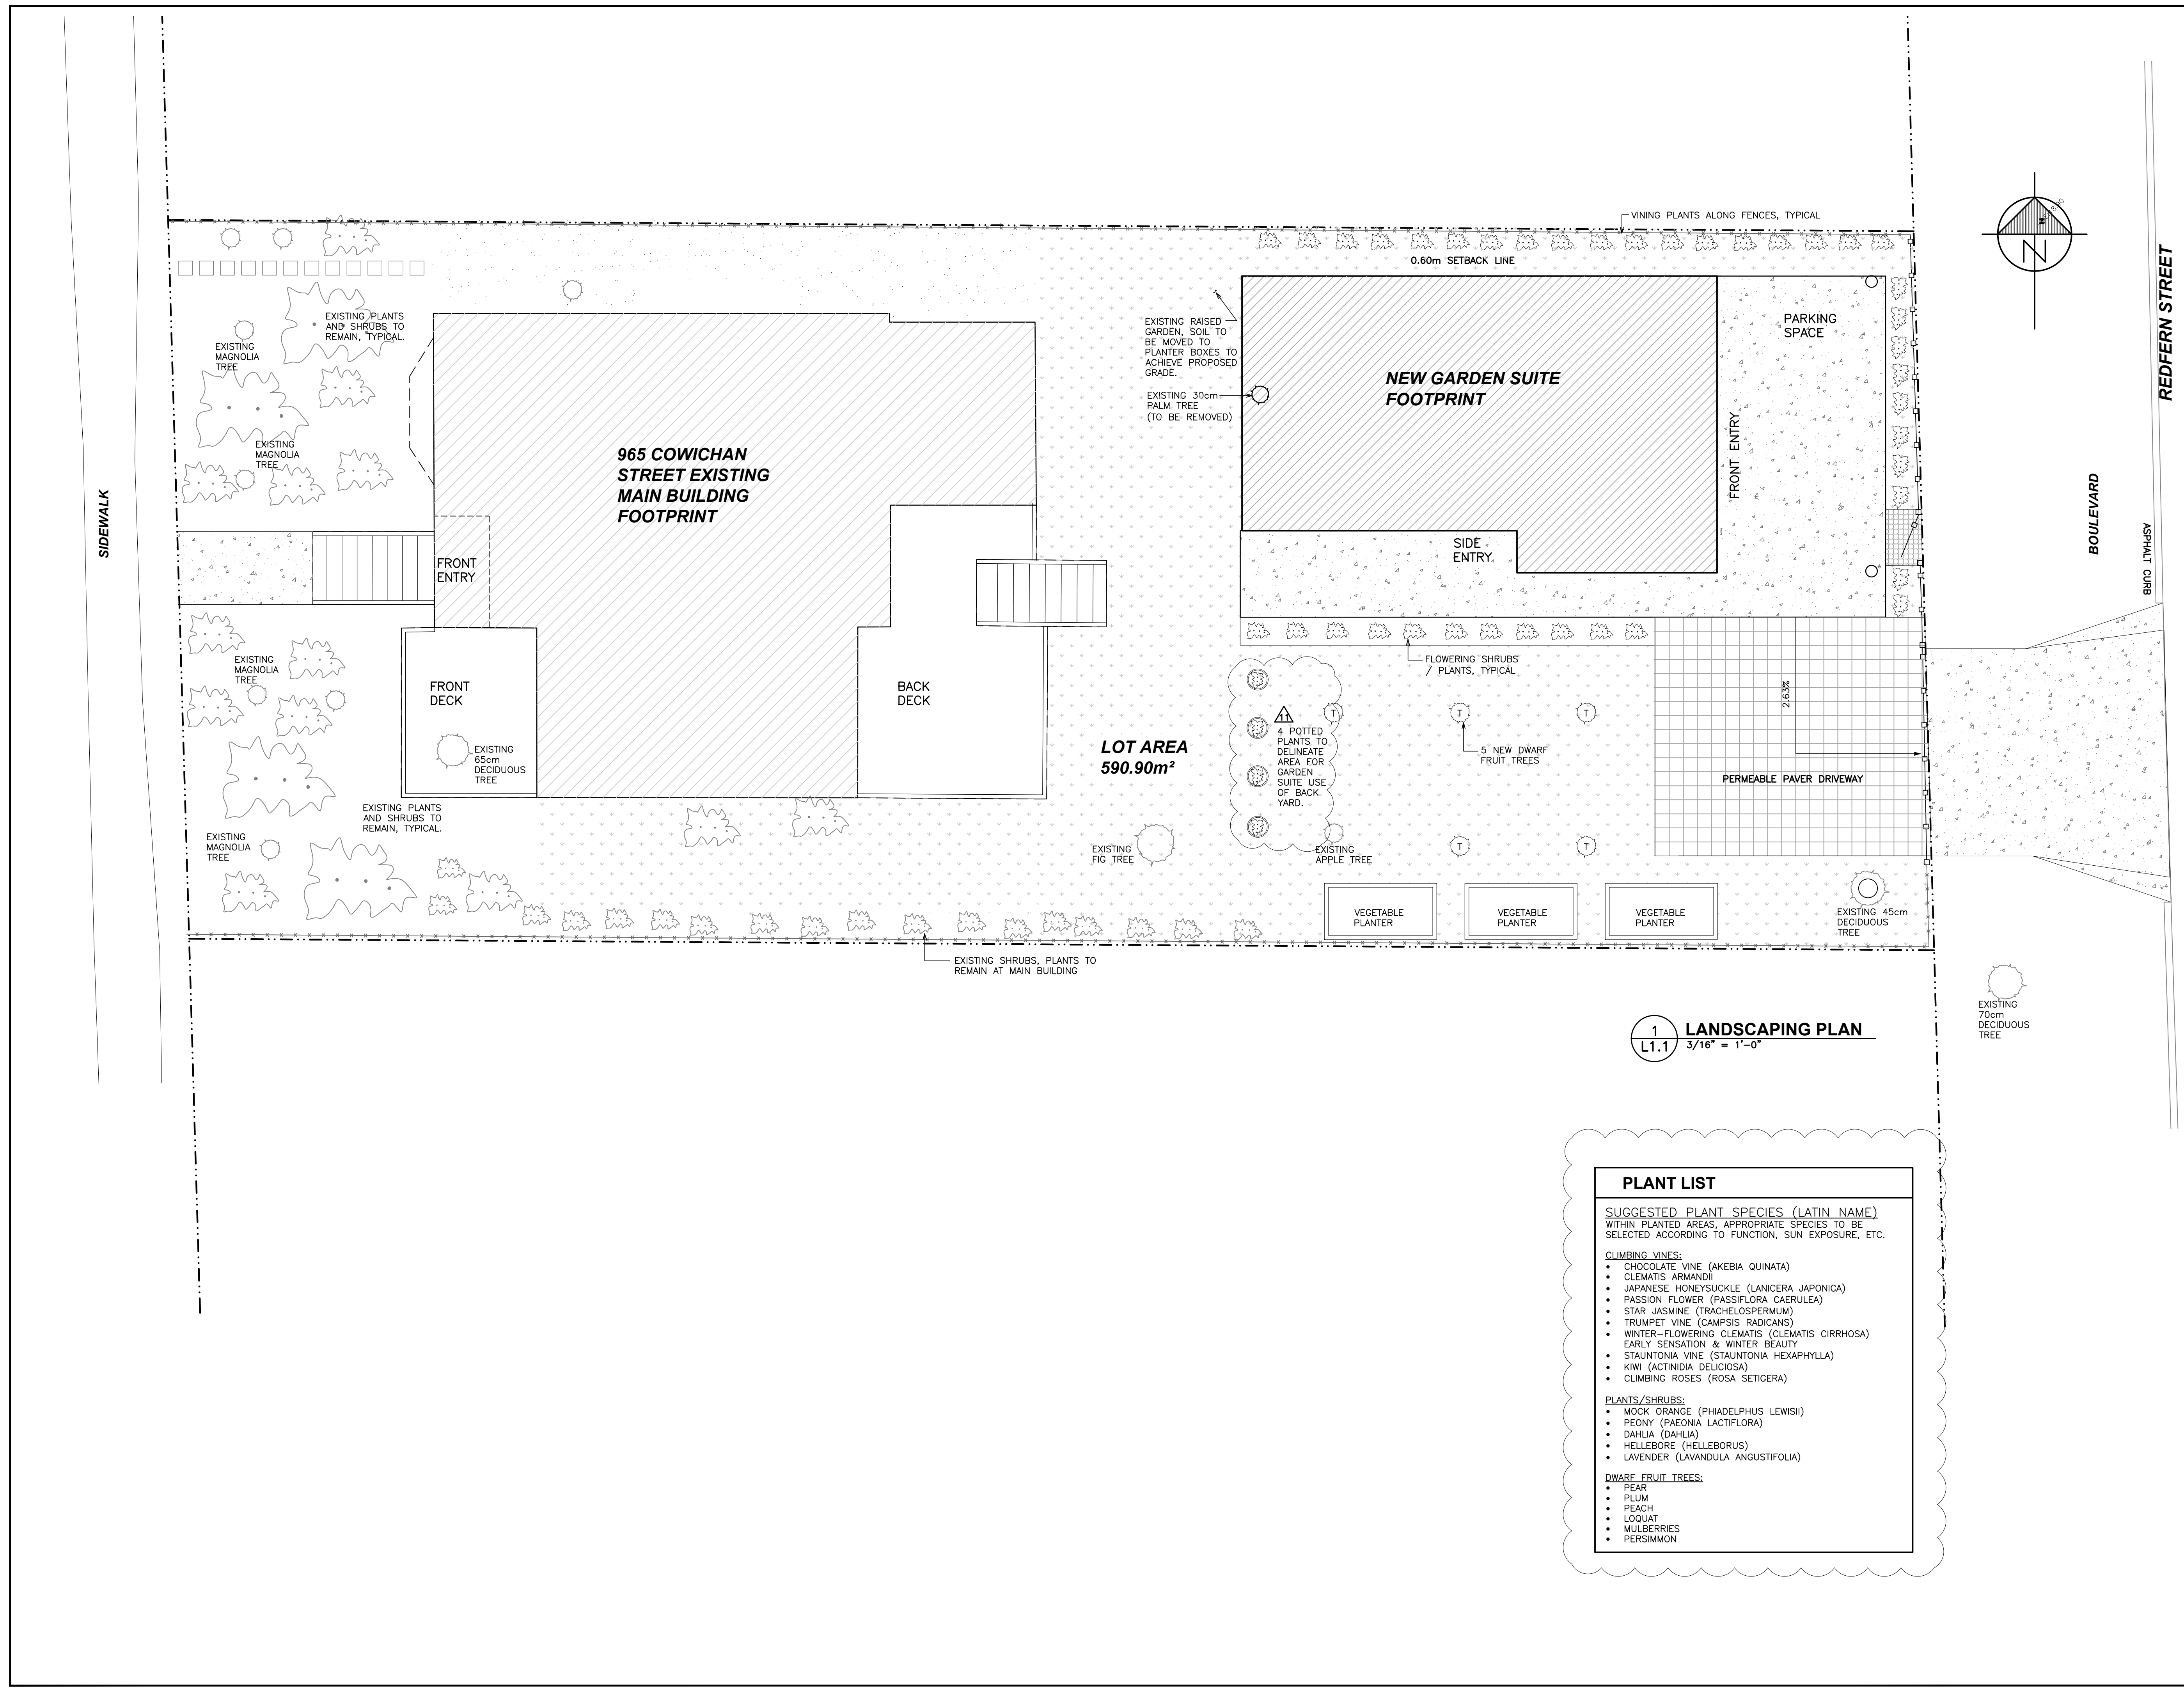

No.	Revision	Date	By
3	Issued for Variance Application	2023/09/05	LL
2	Re-issued for Delegated Development Permit	2023/06/29	LL
1	Delegated Development Permit	2022/10/3	LL

Project Name
READ RESIDENCE - GARDEN SUITE

965 COWICHAN STREET, VICTORIA BC

Sheet Title
LANDSCAPING PLAN

Drawn By LL Scale AS SHOWN
Designed By LL Date AUGUST 5, 2023
Project Number 100
Sheet Number Revision
L1.1

To whom it may concern:

I am writing this letter to justify the current design for a garden suite proposed for development at 965 Cowichan Street. Our proposed design may not strictly meet the design guidelines with regards to orientation to the road as we are located on a double-fronting lot. I would like to touch on both the reasoning for that initial design decision, as well as the efforts that have already been made to bring our proposal within the existing design guidelines.

Our garden suite proposal is meant to provide a space for my mother, Sharon (the owner of the property) space to move into while myself (her son) and my partner grow a family and take over the main home on the same property. Of course it is unlikely we will be able to find affordable, secure, long-term housing in Victoria proper without the luxury of this type of arrangement.

As such, the layout of the garden suite is designed to allow for a greater feeling of connection and openness between the two dwellings on the site. The garden suite being physically oriented with its longest side running roughly east-west, perpendicular to the direction of the road onto which the property fronts, is not intended to suggest the garden suite does not front onto Redfern; as designed the intent was to allow for room along the south side of the property to plant a few fruit trees and install a few garden boxes to grow some vegetables as well as increase the amount of natural light inside the garden suite by allowing the longest dimension of the building to be south facing, with lots of windows and access to a small patio. It is worth noting here that any tree-planting or garden construction would all be done with the thought of allowing for construction of a fence or some other division between the main home and garden suite at a later date, if desired. The proposed layout will also allow for us to maintain an entirely fenced yard for our dogs while supplying an off-street parking spot.

Our proposal has been revised in order to increase street presence on Redfern. In addition to the sliding gate on the south end of the property line along Redfern we have added just a few feet to the north the inclusion of a smaller pedestrian-sized gate for easy access to the front door of the suite. This gate will have an address sign and mailbox directly facing Redfern. We would also like to include a permeable paver pathway from the road across the boulevard. This area would be landscaped appropriately and include a small light to illuminate the address sign when required. I feel that this should bring our proposal within the design guidelines by clearly indicating that the front door of the property is in fact facing Redfern.

I believe this makes a strong case for the development of our garden suite as proposed.


Thanks for your time,
Liam Read-Elliott

2023

CITY OF VICTORIA | Sustainable Planning & Community Development

Development Permit with Variances Application

For 965 Cowichan Street

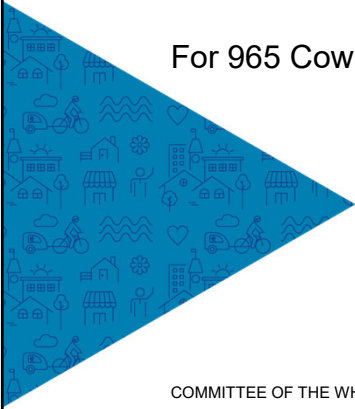

COMMITTEE OF THE WHOLE or COUNCIL | November 2, 2023



Aerial Photo



965 Cowichan Street
Delegated Development Permit No.00784





3




Subject Property



3



Subject Property



4




Neighbouring Properties

5




5

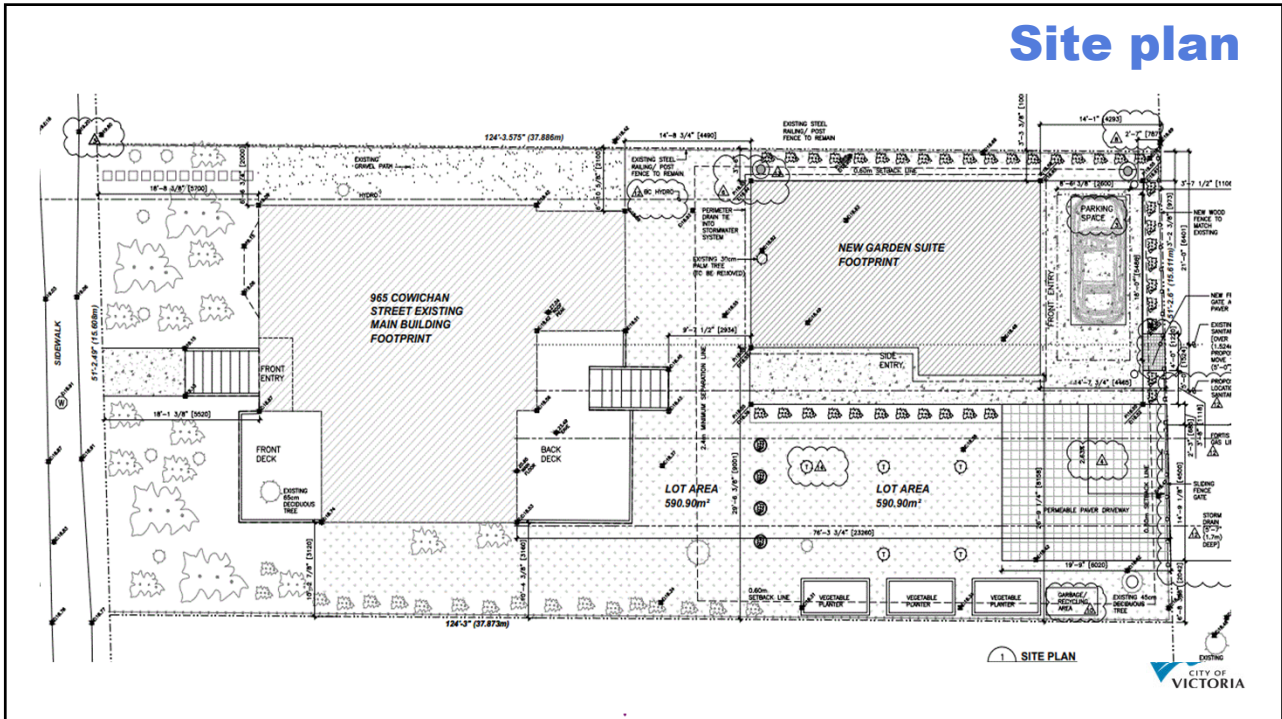

6

Elevation - south

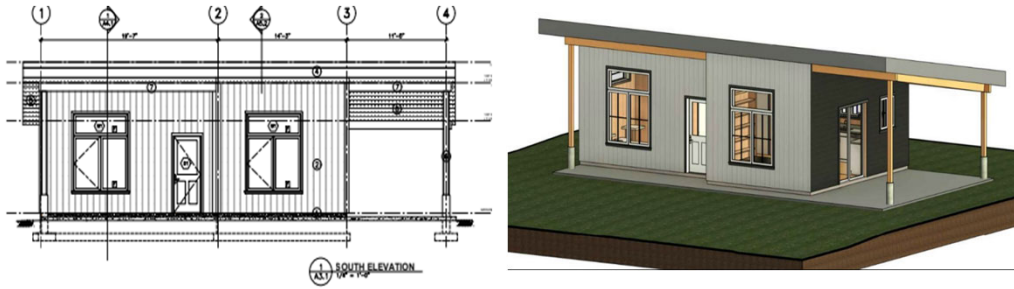

7

Garden Suites Policy and Guidelines

In the case of ...double fronting lots, the Garden Suite should be directly orientated to the adjacent public right-of-way. This means including front doors that are directly orientated to the street or laneway windows directed Towards the street and landscape that reinforces the location of the entry.



8